



SATHYABAMA

INSTITUTE OF SCIENCE AND TECHNOLOGY
(DEEMED TO BE UNIVERSITY)

Accredited with “A” grade by NAAC | 12B Status by UGC | Approved by AICTE
Jeppiaar Nagar, Rajiv Gandhi Salai, Chennai – 600 119
www.sathyabama.ac.in





SCHOOL OF BUILDING AND ENVIRONMENT
DEPARTMENT OF ARCHITECTURE
PRACTICAL TRAINING PORTFOLIO (SAR4063)
DEC 2022

Name of the Student : **SHREYA SUBRAMANIAN**

Batch : **2019 - 2024**

Reg No. : **39210084**

Semester : **VII**

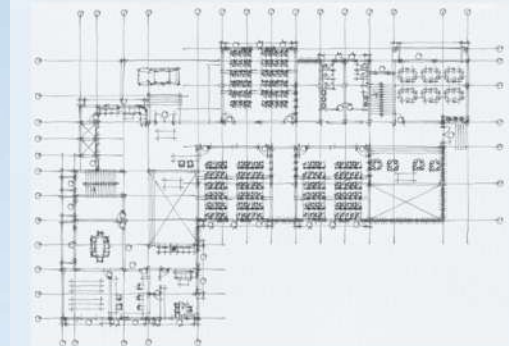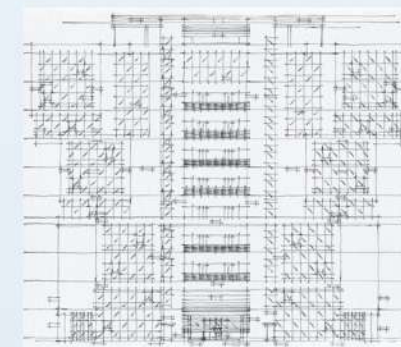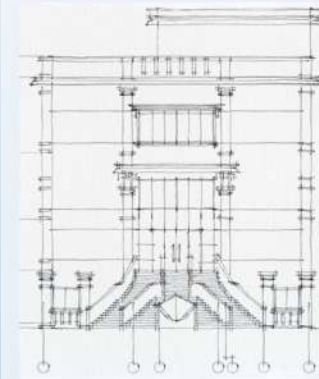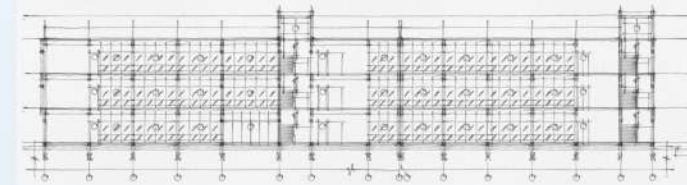

INTERNSHIP PORTFOLIO

SHREYA SUBRAMANIAN
39210084



SATHYABAMA

INSTITUTE OF SCIENCE AND TECHNOLOGY
(DEEMED TO BE UNIVERSITY)

Accredited with “A” grade by NAAC | 12B Status by UGC | Approved by AICTE

Jeppiaar Nagar, Rajiv Gandhi Salai, Chennai – 600 119

www.sathyabama.ac.in

SCHOOL OF BUILDING AND ENVIRONMENT
DEPARTMENT OF ARCHITECTURE
PRACTICAL TRAINING PORTFOLIO (SAR4063)
DEC 2022

Name of the Student : **SHREYA SUBRAMANIAN**

Batch : **2019 - 2024**

Reg No. : **39210084**

Semester : **VII**



SATHYABAMA

INSTITUTE OF SCIENCE AND TECHNOLOGY
(DEEMED TO BE UNIVERSITY)

Accredited with "A" grade by NAAC | 12B Status by UGC | Approved by AICTE

Jeppiaar Nagar, Rajiv Gandhi Salai, Chennai – 600 119

www.sathyabama.ac.in

SCHOOL OF BUILDING AND
ENVIRONMENT DEPARTMENT OF
ARCHITECTURE

VIVA-VOCE EXAMINATION

This is to certify that the practical training SAR 4063 is the work of SHREYA SUBRAMANIAN who had undergone training in PITHAVADIAN AND PARTNERS (Name of the Firm) has been monitored by the continuous assessment during JUNE 2022 to NOVEMBER 2022.

Dr. Devyani Gangopadhyay
DEAN

Submitted for Viva voce Examination held on 15.12.2022

Internal Examiner

External Examiner





SATHYABAMA

INSTITUTE OF SCIENCE AND TECHNOLOGY
(DEEMED TO BE UNIVERSITY)

Accredited with "A" grade by NAAC | 12B Status by UGC | Approved by AICTE

Jeppiaar Nagar, Rajiv Gandhi Salai, Chennai – 600 119

www.sathyabama.ac.in

DECLARATION

I, SHREYA SUBRAMANIAN by declare that the Training Report **JUNE 2022 to NOVEMBER 2022** done by me under the guidance of Ar.N. BALACHANDER is submitted in partial fulfillment of the requirements for the completion of practical training session.

DATE : **13.12.2022**

PLACE : **CHENNAI**

A handwritten signature in black ink, appearing to read 'Shreya'.

SIGNATURE OF CANDIDATE

ACKNOWLEDGEMENT

I am pleased to acknowledge my sincere thanks to the Board **of Management of SATHYABAMA** for their kind encouragement in doing this practical training and for completing it successfully. I am grateful to them.

I convey my thanks to **Dr. Devyani Gangopadhyay**, Dean, School of Building and Environment and **Ar.Sarath Chandra Kanth**, Design Chair, Department of Architecture for having been a constant source of support and encouragement.

I wish to express my thanks to all Teaching and Non-teaching staff members of the Department who were helpful in many ways for the completion of the project.

I also wish to thank **Ar.N. BALACHANDER**, for the experience of interning at their firm.

May 31, 2022

Dr. Devyani Gangopadhyay
Dean

School of Building and Environment
Sathyabama Institute of Science and Technology
SH 49A, Semmancheri,
Chennai - 600119

Dear Madam,

**SUB: Joining Report for Practical Training Student – Ms. Shreya Subramanian
– Reg. No.39210084**

This is to inform you that **Ms. Shreya Subramanian – Reg. No.39210084**
B.Arch student of your Institution will be joining our Firm for her Internship on the
13th of June, 2022 for a period of 90 working days.

The above is for your information.

Thanking you,

Yours faithfully,



Partner

cc: **Ms. Shreya Subramanian – Reg. No.39210084**



SATHYABAMA

INSTITUTE OF SCIENCE AND TECHNOLOGY

(DEEMED TO BE UNIVERSITY)

Accredited "A" Grade by NAAC | 12B Status by UGC | Approved by AICTE

www.sathyabama.ac.in

DEPARTMENT OF ARCHITECTURE

PROFESSIONAL PRACTICAL TRAINING REPORT 2022

(Continuous progress report of the trainee architect for the period of One month in the office to submitted to HOD by the Trainee in Charge of the Organization)

1. Name of the office / organization : PITHAVADIAN AND PARTNERS
2. Address & Contact Number : 10, Murugappa Rd., Nawab Gardens, Kotturpuram
Ch-85. Phone No.: (0) 44 2447 0033
3. Name of the student : SHREYA SUBRAMANIAN
4. Duration : From 13th June 2022 To 30th June 2022
5. Total No. of days : 15

6. Evaluation of Performance criteria shall be on

* Note: Kindly grade the student as per his/her overall performance in the office during the assessment month which will be converted to the allotted 90 marks by the department.

Description of works	Excellent	Good	Fair	Poor	NA
Understanding of office culture		✓			
Participation in the office		✓			
Reading of drawings			✓		
Presentation Techniques		✓			
Model making works					
Understanding of construction details			✓		
Drafting Skills (Manual / Computer)			✓		
Site Supervision / Discussion with clients					
Adherence to Time schedule		✓			
Other computer skills		✓			
File and Office Maintenance					
Coordination with other consultants					
Overall Grading*	C				

(A-9.0, B-8.0, C-7.0, D-6.0, E-5.0)



SATHYABAMA

INSTITUTE OF SCIENCE AND TECHNOLOGY

(DEEMED TO BE UNIVERSITY)

Accredited "A" Grade by NAAC | 12B Status by UGC | Approved by AICTE

www.sathyabama.ac.in

7. Any other Remarks :

8. Signature of the:
Head of the Office
/ Organization
(With Seal)

For PITHAVADIAN & PARTNERS

[Signature]
Partner





SATHYABAMA

INSTITUTE OF SCIENCE AND TECHNOLOGY
(DEEMED TO BE UNIVERSITY)

Accredited "A" Grade by NAAC | 12B Status by UGC | Approved by AICTE

www.sathyabama.ac.in

DEPARTMENT OF ARCHITECTURE

PROFESSIONAL PRACTICAL TRAINING REPORT 2022

(Continuous progress report of the trainee architect for the period of One month in the office to submitted to HOD by the Trainee in Charge of the Organization)

1. Name of the office / organization : PITHAVADIAN AND PARTNERS
2. Address & Contact Number : 10, Murugappa Rd., Nawab Gardens, Kotturpuram, Ch-85. Phone No: (0) 44 2447 0033
3. Name of the student : SHREYA SUBRAMANIAN
4. Duration : From 1st July 2022 To 31st July 2022
5. Total No. of days : 23

6. Evaluation of Performance criteria shall be on

* Note: Kindly grade the student as per his/her overall performance in the office during the assessment month which will be converted to the allotted 90 marks by the department.

Description of works	Excellent	Good	Fair	Poor	NA
Understanding of office culture	✓				
Participation in the office	✓				
Reading of drawings	✓				
Presentation Techniques		✓			
Model making works					✓
Understanding of construction details		✓			
Drafting Skills (Manual / Computer)	✓				
Site Supervision / Discussion with clients					✓
Adherence to Time schedule		✓			
Other computer skills		✓			
File and Office Maintenance	✓				
Coordination with other consultants					✓
Overall Grading*	A				

(A - 9.0, B - 8.0, C - 7.0, D - 6.0, E - 5.0)



SATHYABAMA

INSTITUTE OF SCIENCE AND TECHNOLOGY
(DEEMED TO BE UNIVERSITY)

Accredited "A" Grade by NAAC | 12B Status by UGC | Approved by AICTE

www.sathyabama.ac.in

7. Any other Remarks :

8. Signature of the:
Head of the Office
/ Organization
(With Seal)

For PITHAVADIAN AND PARTNERS

N. P. Subramanian
Partner



MONTHLY REPORT-JULY



SATHYABAMA

INSTITUTE OF SCIENCE AND TECHNOLOGY
(DEEMED TO BE UNIVERSITY)

Accredited "A" Grade by NAAC | 12B Status by UGC | Approved by AICTE

www.sathyabama.ac.in

DEPARTMENT OF ARCHITECTURE

PROFESSIONAL PRACTICAL TRAINING REPORT 2022

(Continuous progress report of the trainee architect for the period of One month in the office to submitted to HOD by the Trainee in Charge of the Organization)

1. Name of the office / organization : **PITHAVADIAN AND PARTNERS**
10, Murugappa Rd, Nawab Gardens,
2. Address & Contact Number : **Kotturpuram, Ch-85. Phone No. : (044) 2447 0033**
3. Name of the student : **SHREYA SUBRAMANIAN**
4. Duration : **From 1st August 2022 To 31st August 2022**
5. Total No. of days : **24**

6. Evaluation of Performance criteria shall be on

* Note: Kindly grade the student as per his/her overall performance in the office during the assessment month which will be converted to the allotted 90 marks by the department.

Description of works	Excellent	Good	Fair	Poor	NA
Understanding of office culture		✓			
Participation in the office		✓			
Reading of drawings					✓
Presentation Techniques	✓				
Model making works		✓			
Understanding of construction details		✓			
Drafting Skills (Manual / Computer)		✓			
Site Supervision / Discussion with clients					✓
Adherence to Time schedule	✓				
Other computer skills	✓				
File and Office Maintenance		✓			
Coordination with other consultants					✓
Overall Grading*	9.0				

(A-9.0, B-8.0, C-7.0, D-6.0, E-5.0)



SATHYABAMA

INSTITUTE OF SCIENCE AND TECHNOLOGY
(DEEMED TO BE UNIVERSITY)

Accredited "A" Grade by NAAC | 12B Status by UGC | Approved by AICTE

www.sathyabama.ac.in

7. Any other Remarks :

8. Signature of the:
Head of the Office
/ Organization
(With Seal)

For PITHAVADIAN AND PARTNERS

N. P. Subramanian
Partner





SATHYABAMA

INSTITUTE OF SCIENCE AND TECHNOLOGY
[DEEMED TO BE UNIVERSITY]

Accredited "A" Grade by NAAC | 12B Status by UGC | Approved by AICTE

www.sathyabama.ac.in

DEPARTMENT OF ARCHITECTURE

PROFESSIONAL PRACTICAL TRAINING REPORT 2022

(Continuous progress report of the trainee architect for the period of One month in the office to submitted to HOD by the Trainee in Charge of the Organization)

1. Name of the office / organization : PITHAVADIAN AND PARTNERS
10, Murugappa Rd., Nawab Gardens,
Kotturpuram, Ch-85. Phone No.: (0)44 2447 0033
2. Address & Contact Number
3. Name of the student : SHREYA SUBRAMANIAN
4. Duration : From 1st September 2022 to 30th September 2022
5. Total No. of days : 25

6. Evaluation of Performance criteria shall be on

* Note: Kindly grade the student as per his/her overall performance in the office during the assessment month which will be converted to the allotted 90 marks by the department.

Description of works	Excellent	Good	Fair	Poor	NA
Understanding of office culture		✓			
Participation in the office	✓				
Reading of drawings	✓				
Presentation Techniques	✓				
Model making works					
Understanding of construction details		✓			
Drafting Skills (Manual / Computer)	✓				
Site Supervision / Discussion with clients					
Adherence to Time schedule		✓			
Other computer skills		✓			
File and Office Maintenance		✓			
Coordination with other consultants					
Overall Grading*	9.0				

(A - 9.0, B - 8.0, C - 7.0, D - 6.0, E - 5.0)



SATHYABAMA

INSTITUTE OF SCIENCE AND TECHNOLOGY
[DEEMED TO BE UNIVERSITY]

Accredited "A" Grade by NAAC | 12B Status by UGC | Approved by AICTE

www.sathyabama.ac.in

7. Any other Remarks :

8. Signature of the:
Head of the Office
/ Organization
(With Seal)

For PITHAVADIAN AND PARTNERS

N. P. Subramanian
Partner



MONTHLY REPORT-SEPTEMBER



SATHYABAMA

INSTITUTE OF SCIENCE AND TECHNOLOGY
(DEEMED TO BE UNIVERSITY)

Accredited "A" Grade by NAAC | 12B Status by UGC | Approved by AICTE

www.sathyabama.ac.in

DEPARTMENT OF ARCHITECTURE

PROFESSIONAL PRACTICAL TRAINING REPORT 2022

(Continuous progress report of the trainee architect for the period of One month in the office to submitted to HOD by the Trainee in Charge of the Organization)

1. Name of the office / organization : PITHAVADIAN AND PARTNERS
2. Address & Contact Number : 10, Murugappa Rd., Nambal Gardens,
Kotturpuram, Ch-85. Phone No.: (0)44 2447 0033
3. Name of the student : SHREYA SUBRAMANIAN
4. Duration : From 1st October 2022 To 7th October 2022
5. Total No. of days : 3

6. Evaluation of Performance criteria shall be on

* Note: Kindly grade the student as per his/her overall performance in the office during the assessment month which will be converted to the allotted 90 marks by the department.

Description of works	Excellent	Good	Fair	Poor	NA
Understanding of office culture	✓				
Participation in the office		✓			
Reading of drawings	✓				
Presentation Techniques		✓			
Model making works					✓
Understanding of construction details		✓			
Drafting Skills (Manual / Computer)	✓				
Site Supervision / Discussion with clients		✓			
Adherence to Time schedule	✓				
Other computer skills	✓				
File and Office Maintenance		✓			
Coordination with other consultants					✓
Overall Grading*	9				

(A - 9.0, B - 8.0, C - 7.0, D - 6.0, E - 5.0)



SATHYABAMA

INSTITUTE OF SCIENCE AND TECHNOLOGY

(DEEMED TO BE UNIVERSITY)

Accredited "A" Grade by NAAC | 12B Status by UGC | Approved by AICTE

www.sathyabama.ac.in

7. Any other Remarks :

8. Signature of the:
Head of the Office
/ Organization
(With Seal)

For PITHAVADIAN AND PARTNERS

N. P. Subramanian
Partner



MONTHLY REPORT-OCTOBER

DAY NO.	DATE	PROJECT	WORK DONE	ASSIGNED BY
JUNE				
WEEK 1				
1	13.06.2022	Tidel Park- Villupuram	Security Cabin- plan, section, elevation	Ar. Lekha
2	14.06.2022	Tidel Park- Villupuram	Toilet Detail- PH	Ar. Lekha
		IITM Staff Quarters	Photoshop- Plan Checking and corrections in plan	Ar. Chandiny
3	15.06.2022	Tidel Park- Villupuram	Toilet Detail- PH	Ar. Lekha
		IITM Staff Quarters	Photoshop- Sections	Ar. Chandiny
4	16.06.2022	Tidel Park- Villupuram	Toilet Detail- PH	Ar. Lekha
			Security Cabin- Changes	
5	17.06.2022	IIT Indore	Admin Block- Corrections and checking in Plan (As Built)	Ar. Govarthan
6	18.06.2022	IIT Indore	Admin Block- Corrections and checking in Elevation (As Built)	Ar. Govarthan
WEEK 2				
7	20.06.2022	IIT Indore	Admin Block- correction and checking in Elevation, Section (As Built)	Ar. Govarthan
8	21.06.2022	IIT Indore	Admin Block- correction and checking in Section (As Built)	Ar. Govarthan
9	22.06.2022	IIT Indore	Admin Block- Corrections (As Built)	Ar. Govarthan
10	23.06.2022	Tidel Park- Villupuram	Toilet Detail PH- Corrections	Ar. Lekha
		Collage	Print outs	Ar. Valli
11	24.06.2022	Tidel Park- Tirupur	Toilet Detail- Ladies, Gents, PH toilet	Ar. Rutvi
		Cheyyar	Checking the CAD drawings Printouts	Ar. Valli

DAY NO.	DATE	PROJECT	WORK DONE	ASSIGNED BY
JUNE				
WEEK 3				
12	27.06.2022	Tidel Park- Tirupur	Toilet Detail- Ladies, Gents, PH toilet	Ar. Rutvi
		IIT Indore	Admin Block- Interior Layout	Ar. Govardhan
13	28.06.2022	IIT Inodre	Admin Block- Interior Layout	Ar. Govarthan
		FRCCI	Unit 1- VCI Office Block- corrections in plan given by client	
14	29.06.2022	FRCCI	Unit 1- VCI Office Block- corrections in plan given by client	Ar. Govarthan
		IIT Indore	Admin Block- Interior Layout	
15	30.06.2022	IIT Indore	Admin Block- Interior Layout	Ar. Govarthan
JULY				
16	01.07.2022	Tidel Park - Tirupur	Toilet Detail- Ladies, Gents, PH	Ar. Rutvi
17	02.07.2022	Tidel Park- Villupuram	Joinery Detail- for doors and windows	Ar. Lekha
WEEK 4				
18	04.07.2022	Tidel Park- Villupuram	Joinery Detail- for doors and windows	Ar. Lekha
19	05.07.2022	IIA	Checking and Corrections in option 3 of IIA plan	Ar. Chandiny
20	06.07.2022	IIA	Checking and Corrections in option 3 of IIA plan	Ar. Chandiny
		Tidel Park- Tirupur	Toilet Detail- Ladies, Gents, PH	Ar. Rutvi
21	07.07.2022	Tidel Park- Tirupur	Toilet Detail- Ladies, Gents, PH	Ar. Rutvi
		FRCCI	Unit 1- VCI Office Block- new proposal in plan	Ar. Govarthan
22	08.07.2022	IIT Staff Quarters	Photoshop- Typical floor plan, Stilt floor plan, Terrace plan	Ar. Chandiny

DAY NO.	DATE	PROJECT	WORK DONE	ASSIGNED BY
JULY				
WEEK 5				
23	11.07.2022	IIT Staff Quarters	Photoshop - Section	Ar. Chandiny
		Temico	Staircase Detail 1	Ar. Carol
24	12.07.2022	Temico	Staircase Detail 1	Ar. Carol
25	13.07.2022	Temico	Staircase Detail 1	Ar. Carol
		Tidel Park- Tirupur	Toilet Detail - Ladies, Gents, PH	Ar. Rutvi
26	14.07.2022	Jesons	Canteen Block- Changes in Section and Elevation	Ar. Carol
27	15.07.2022	Jesons	Canteen Block- Changes in Section and Elevation	Ar. Carol
		IIA	Photoshop- plans	Ar. Chandiny
28	16.07.2022	Temico	Joinery Detail- Substation and Ancillary Block	Ar. Carol
		TCI	Entrance Staircase Detail	Ar. Akshaya
WEEK 6				
29	18.07.2022	Temico	Joinery Detail- Substation and Ancillary Block	Ar. Carol
		TCI	Entrance Staircase Detail	Ar. Akshaya
30	19.07.2022	TCI	Entrance Staircase Detail	Ar. Akshaya
		Tidel Park- Tirupur	Toilet Detail changes- Ladies, Gents, PH	Ar. Rutvi
		IIT Indore	Combined Services Drawing- Ground Floor and Interior corrections	Ar. Govarthan
31	20.07.2022	IIT Indore	Combined Services Drawing- 1st - 3rd Floor and Interior corrections	Ar. Govarthan
32	21.07.2022	IIT Indore	Combined Services Drawing- 4th - 6th Floor and Interior corrections	Ar. Govarthan
33	22.07.2022	IIT Indore	Combined Services Drawing- 7th - 9th Floor and Interior corrections	Ar. Govarthan

DAY NO.	DATE	PROJECT	WORK DONE	ASSIGNED BY
JULY				
WEEK 7				
34	25.07.2022	Temico	Joinery Detail changes- Substation and Ancillary Block	Ar. Carol
		Tidel Park- Tirupur	Toilet Detail changes- Ladies, Gents, PH	Ar. Rutvi
		Jesons	Canteen Block- MD Dining Room	Ar. Carol
35	26.07.2022	Temico	Lintel Detail - Main Block and Substation	Ar. Carol
		Tidel Park- Tirupur	Toilet Detail changes- Ladies, Gents, PH	Ar. Rutvi
		Jesons	Canteen Block- MD Dining Room	Ar. Carol
36	27.07.2022	TCI	Changes in Elevations and Section	Ar. Akshaya
		Temico	Lintel Detail - Main Block and Substation Block	Ar. Carol
37	28.07.2022	Temico	Lintel Detail - Main Block and Substation	Ar. Carol
38	29.07.2022	Temico	Lintel Detail - Main Block and Substation	Ar. Carol
AUGUST				
WEEK 8				
39	01.08.2022	Temico	Staircase Deatil 2	Ar. Carol
40	02.08.2022	Temico	Staircase Deatil 2	Ar. Carol
		SIPCOT	Survey Drawing	Ar. Akshaya
41	04.08.2022	Temico	Staircase Deatil 2	Ar. Carol
		IIT Indore	Converting CAD drawings to PDF	Ar. Govarthan
42	05.08.2022	IIT Indore	Corrections in CAD drawings	Ar. Govarthan
			Converting CAD drawings to PDF	
43	06.08.2022	IIT Indore	Sketch Up- Admin Block-Site Block Model	Ar. Govarthan
			Corrections in CAD drawings	
			Presentation work	

DAY NO.	DATE	PROJECT	WORK DONE	ASSIGNED BY
AUGUST				
WEEK 9				
44	08.08.2022	Temico	Staircase Deatil 2	Ar. Carol
45	09.08.2022	Temico	Terrace Plan- Ancillary Building	Ar. Carol
			Road section	
			Staircase Deatil 2	
46	10.08.2022	Temico	Staircase Deatil 2	Ar. Carol
47	11.08.2022	Temico	Staircase Deatil 2	Ar. Carol
		FRCCI	Unit 1- Production Plant - Plan and Section	Ar. Govarthan
48	12.08.2022	FRCCI	Unit 1- Production Plant - Section and Elevation	Ar. Govarthan
WEEK 10				
49	16.08.2022	FRCCI	Unit 1- Production Plant - Section	Ar. Govarthan
50	17.08.2022	Jesons	Canteen Block- MD Dining Room changes	Ar. Carol
		Sivagiri	Public Convenience- Plan and Section changes	Valli Ma'am
		CDCI	Printouts	
51	18.08.2022	AMAAN	Corrections in CAD drawings	Valli Ma'am
52	19.08.2022	AMAAN	Corrections in CAD drawings	Valli Ma'am
		FRCCI	Unit 1- VCI Office Block- Plan and Elevation	Ar. Govarthan
53	20.08.2022	FRCCI	Unit 1- VCI Office Block- Section and Elevation	Ar. Govarthan
			Unit 2- Staff Security Cabin changes	

DAY NO.	DATE	PROJECT	WORK DONE	ASSIGNED BY
AUGUST				
WEEK 11				
54	22.08.2022	FRCCI	Unit 2- Staff Security Cabin changes	Ar. Govarthan
			Unit 2- Utility Block-changes	
			Unit 1- VCI Office Block- SketchUp Model	
55	23.08.2022	FRCCI	Unit 1- VCI Office Block- SketchUp Model	Ar. Govarthan
56	24.08.2022	IIT Staff Quarters	Photoshop- Stilt Floor and Typical Floor Plan	Ar. Chandiny
57	25.08.2022	TFC	Corrections in Plan	Valli Ma'am
58	26.08.2022	TFC	Corrections in Plan and Section	Valli Ma'am
59	27.08.2022	MGC	Site Visit	Bala Sir
WEEK 12				
60	29.08.2022	FRCCI	Unit 2- Truck Parking and Staff Entry Security Cabin- Section and Elevation	Ar. Govarthan
			Unit 1- VCI Office Block- Changes	
61	30.08.2022	FRCCI	Unit 2- Corrections in CAD drawings	Ar. Govarthan
			Unit 2- Converting CAD drawings to PFDs	
62	31.08.2022	FRCCI	Unit 1- Corrections in CAD drawings	Ar. Govarthan
SEPTEMBER				
WEEK 12				
63	01.09.2022	FRCCI	Unit 1- Corrections in CAD drawings	Ar. Govarthan
			Unit 1- Converting CAD drawings to PFDs	
			Unit 1- Excel Sheet work	
64	02.09.2022	FRCCI	Unit 1- Correction in CAD drawing	Ar. Govarthan
		ICAI	Scheme Plan	Ar. Rajesh
65	03.09.2022	ICAI	Scheme Plan corrections	Partha Sir

DAY NO.	DATE	PROJECT	WORK DONE	ASSIGNED BY
SEPTEMBER				
WEEK 13				
66	05.09.2022	ICAI	Scheme Plan corrections	Partha Sir
		TNHB	OHT Detail	Ar. Govarthan
67	06.09.2022	ICAI	Changes in Plan	Partha Sir
68	07.09.2022	ICAI	Changes in Plan	Partha Sir
		TNHB	OHT Detail- corrections	Ar. Govarthan
69	08.09.2022	ICAI	Borehole Site plan and Elevations	Partha Sir
70	09.09.2022	ICAI	Changes in Plan and Elevations	Partha Sir
71	10.09.2022	Kerala Bar Council	Plan corrections	Ar. Rajesh
			Photoshop- Ground Floor Plan	
WEEK 14				
72	12.09.2022	Kerala Bar Council	Photoshop- Floor Plans	Ar. Rajesh
73	13.09.2022	Kerala Bar Council	Photoshop- Sections and PPT work	Ar. Rajesh
74	14.09.2022	FRCCI	Unit 1- Utility Block- Corrections	Ar. Govarthan
			Unit 1- Office Block- Corrections	
75	15.09.2022	ICAI	Changes in Plan	Partha Ma'am
76	16.09.2022	ICAI	Changes in Plan	Partha Ma'am
77	17.09.2022	Indian Bank	Photoshop- Sections	Ar. Rutvi


DAY NO.	DATE	PROJECT	WORK DONE	ASSIGNED BY
SEPTEMBER				
WEEK 15				
78	19.09.2022	Indian Bank	PPT work	Ar. Rutvi
		ICAI	Site Plan	Partha Sir
79	20.09.2022	Infotech	Printouts	Ar. Govarthan
		ICAI	Elevations	Partha Sir
80	21.09.2022	ICAI	Elevations	Partha Sir
		AIISH	Ground floor plan- changes	Ar. Chandiny
81	22.09.2022	ICAI	Site Plan changes	Cynthia Ma'am
			SketchUP- Model	
82	23.09.2022	ICAI	SketchUP- Model	Cynthia Ma'am
			Changes in Plan and Site Plan	Partha Sir
83	24.09.2022	Frudenberg	Site Plan chnages	Ar. Govarthan
			Green Area Calculation	
		AIISH	Photoshop- Section and PPT	Ar. Chandiny
WEEK 16				
84	26.09.2022	ICAI	Changes in Elevations	Partha Sir
85	27.09.2022	ICAI	Changes in SketchUp model	Partha Sir
86	28.09.2022	Positioner	Section	Partha Sir
87	29.09.2022	CSD, Bargur	Bus Parking- Type C Truss	Valli Ma'am
			Printouts	

DAY NO.	DATE	PROJECT	WORK DONE	ASSIGNED BY
OCTOBER				
WEEK 17				
88	03.10.2022	Temico	Floor plan- Toilet changes	Ar. Carol
			Cable Trench Detail	
			Soil nailing - changes	
89	06.10.2022	Temico	Cable Trench Detail	Ar. Carol
			Main Block- Window Joinery Detail	
90	07.10.2022	Temico	Main Block- Window Joinery Detail	Ar. Carol
			Main Block- Ramp Detail	
		Positioner	Plan and Section - changes	Ar. Rutvi
WEEK 18				
91	10.10.2022	Temico	Main Block- Ramp Detail	Ar. Carol
		ICAI	Floor Plan- Changes	Ar. Rajesh
92	11.10.2022	Temico	Main Block- Ramp Detail	Ar. Carol
93	12.10.2022	CSD, Bargur	Site Visit	Valli Ma'am
94	13.10.2022	TN Tourism	Site Analysis	Ar. Lekha
95	14.10.2022	TN Tourism	Site Analysis- Photosop	Ar. Lekha
			Site Sections- Photoshop	
96	15.10.2022	TN Tourism	Site Sections- Photoshop	Ar. Lekha

DAY NO.	DATE	PROJECT	WORK DONE	ASSIGNED BY
OCTOBER				
WEEK 19				
97	17.10.2022	FRCCI	Unit 1 & 2- Converting CAD drawings to PFDs	Ar. Govarthan
			Unit 2- Production Plant- Ground floor plan	
98	18.10.2022	Temico	Main Block- Ramp Detail	Ar. Carol
99	19.10.2022	Temico	Main Block- Ramp Detail	Ar. Carol
		FRCCI	Unit 2- Production Plant- Ground floor plan	Ar. Govarthan
100	20.10.2022	FRCCI	Unit 2- Production Plant- Ground floor plan and Section	Ar. Govarthan
101	21.10.2022	FRCCI	Unit 2- Production Plant- Ground floor plan, Machinery Layout and Section	Ar. Govarthan
WEEK 20				
102	25.10.2022	FRCCI	Unit 2- Production Plant- First floor plan	Ar. Govarthan
103	26.10.2022	FRCCI	Unit 2- Production Plant- Ground floor and First floor plan- changes	Ar. Govarthan
			Unit 2- Production Plant- Roof Plan	
104	27.10.2022	FRCCI	Unit 2- Production Plant- Floor Plan and Section changes	Ar. Govarthan
105	28.10.2022	FRCCI	Unit 2- Production Plant- Sections changes	Ar. Govarthan
106	29.10.2022	FRCCI	Unit 2- Production Plant- Machinery Layout changes and Sections	Ar. Govarthan
WEEK 21				
107	31.10.2022	FRCCI	Unit 2- Production Plant- Sections and Elevations	Ar. Govarthan
NOVEMBER				
108	01.11.2022	FRCCI	Unit 2- Production Plant- Elevations	Ar. Govarthan

CERTIFICATE

This is to certify that Ms. Shreya Subramanian (Reg.No. 39210084) Student of Sathyabama Institute of Science and Technology, Chennai had undergone professional training at our Firm from 13-06-2022 to 07.10.2022 (90 days). During this period she has worked on the preparation of Architectural detailed drawings for various projects. She has also been exposed to Design Competitions and site works. She is sincere and hard working. The above Qualities are appreciated by the Partners and we wish her all success in her academic and Professional Career.

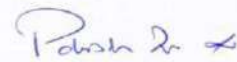

Parthsarathi Dutta Gupta
Managing Partner
Dt.07.10.2022

1.	ABOUT THE FIRM
	DETAIL DRAWINGS
2.	TAMIL NADU HOUSING BOARD
3.	M/S TEMICO MOTOR INDIA PRIVATE LIMITED
4.	TIDEL PARK - TIRUPUR
5.	TIDEL PARK - VILLUPURAM
	ARCHITECTURAL DRAWINGS
6.	IIT - INDORE
7.	INSTITUTE OF CHARTERED ACCOUNTANTS OF INDIA
8.	FREUDENBERG REGIONAL CORPORATE CENTER INDIA PVT. LTD.
	COMPETITION RENDERS
9.	IIT - MADRAS
10.	TAMILNADU TOURISM DEVELOPMENT CORPORATION LTD.
11.	INDIAN BANK
12.	ADVOCATE'S ACADEMY
13.	SITE VISIT
14.	CRITICAL OVERVIEW

HISTORY

ONE OF THE EARLIEST ARCHITECTURAL FIRMS IN CHENNAI, PNP'S HISTORY DATES BACK TO 1919, DURING THE TIME OF THE BRITISH RAJ. IT'S PARENT ORGANISATION, **JACKSON AND BARKER** WAS NAMED AFTER R. JACKSON AND H.W. BARKER. IN 1947, THE FIRM WAS UNDER THE LEADERSHIP OF MAJOR HAROLD F. PRYNNE, J.E. DAVIS AND M.A. RIDDLEY ABBOT AND THE FIRM WAS RE-NAMED AS **PRYNNE, ABBOT AND DAVIS**. THE FIRM WAS AGAIN RE-NAMED AS **PITHAVADIAN & PARTNERS** IN THE YEAR 1972, WITH MR. PITHAVADIAN AT THE HELM. WITH ITS 100 YEAR HISTORY, TODAY THE COMPANY IS ONE OF THE MOST RESPECTED ARCHITECTURAL FIRMS IN CHENNAI. IT IS HEADED BY **MR.PARTHSARTHI** IN THE ROLE OF MANAGING PARTNER AND **N.BALACHANDER** AS PARTNER OF THE FIRM.

OFFICE

LOCATED IN 4 CITIES INCLUDING CHENNAI, BENGALURU, KOCHI AND HYDERABAD, PNP ARCHITECTS OFFERS END-TO-END SOLUTIONS FOR ALL TYPES OF BUILDING, SITES AND SERVICE PROJECTS. THE FIRM HAS BEEN INVOLVED IN NEARLY 3000 PROJECTS OF VARIED SIZES, COMPLEXITY AND SECTORS.



ABOUT
PITHAVADIAN AND PARTNERS







**TAMIL NADU
HOUSING
BOARD**




M/S TEMICO MOTOR INDIA PRIVATE LIMITED

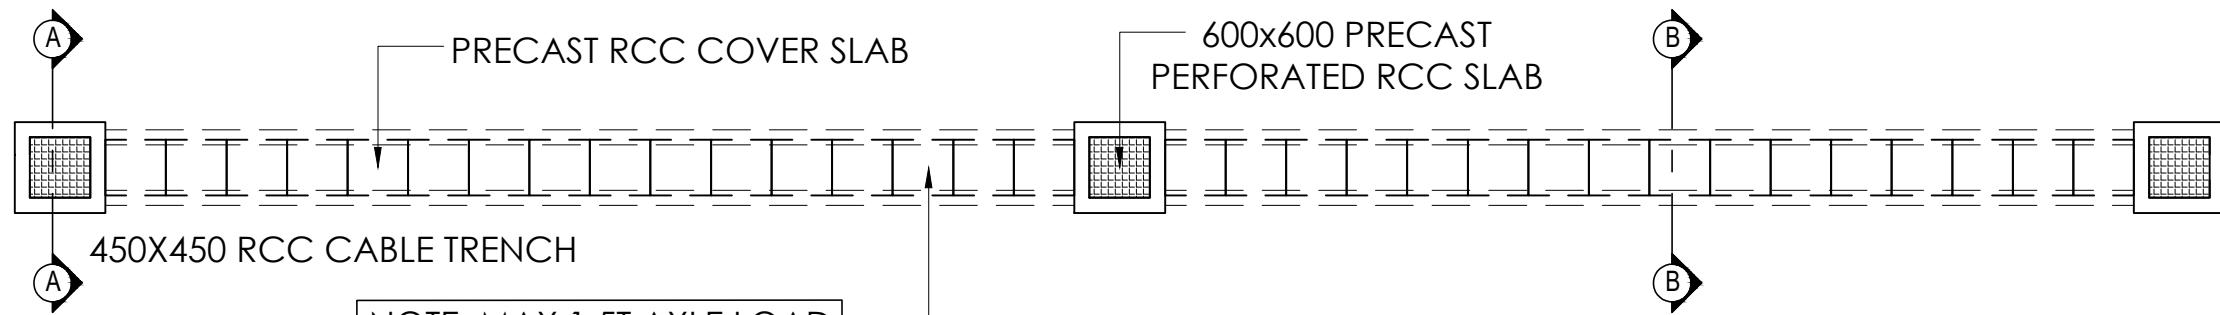


PLAN
SCALE-1:75

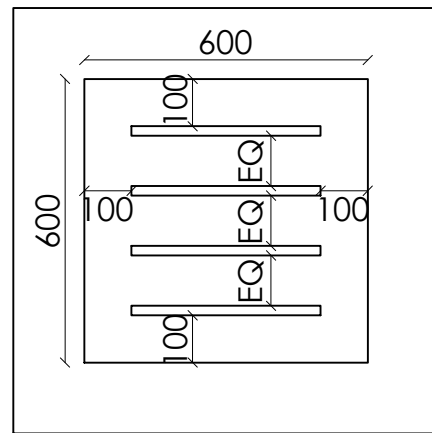

PRECAST PERFORATED
RCC SLAB DETAIL

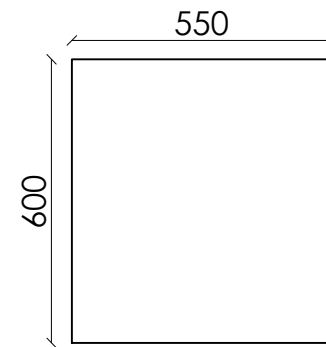


PRECAST RCC
COVER SLAB DETAIL

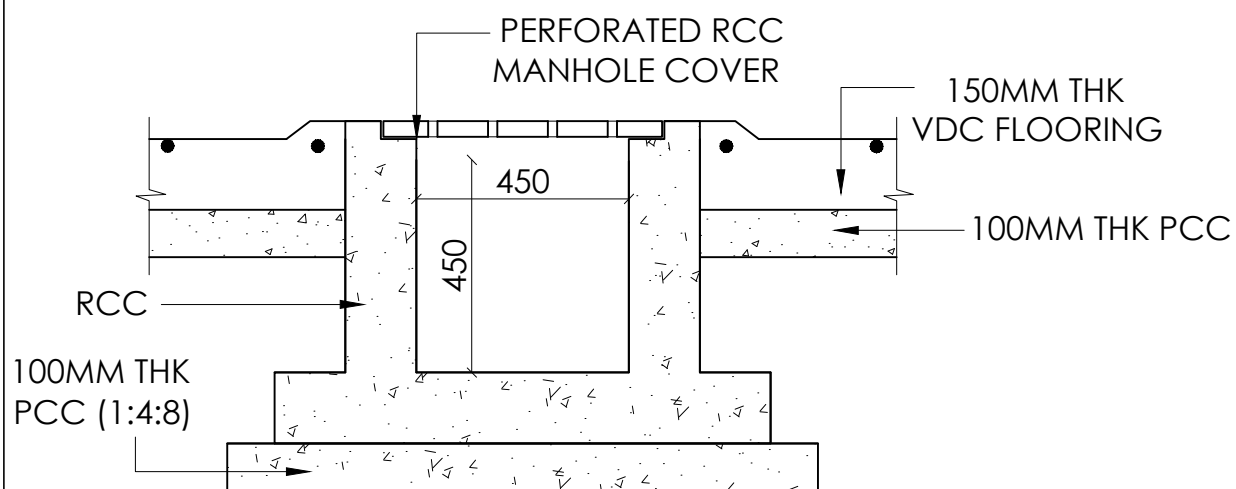

TYPICAL HT CABLE TRENCH SECTION AT MANHOLE

LT CABLE TRENCH
SECTION AA

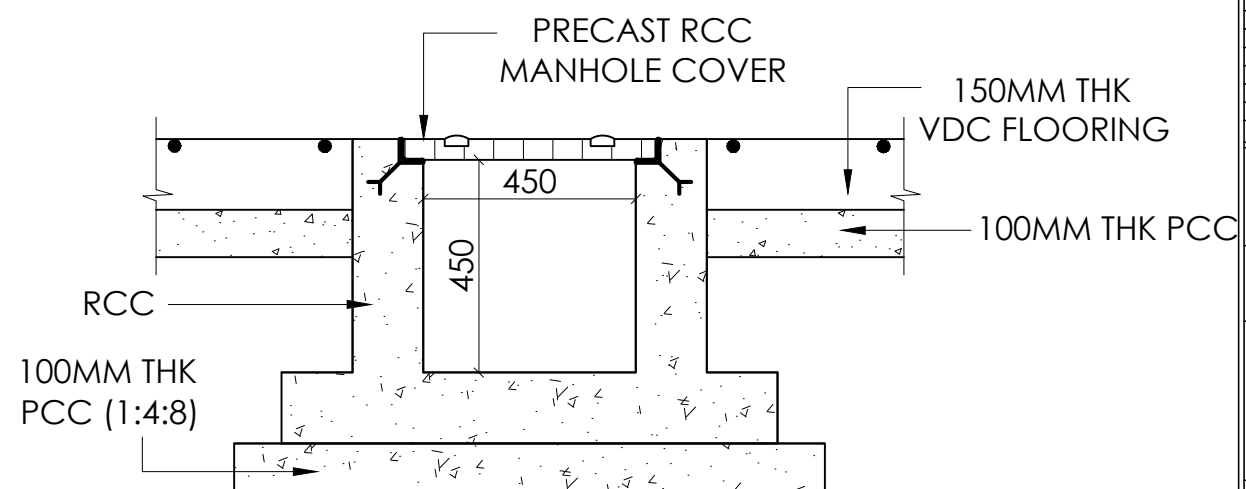

TYPICAL HT CABLE TRENCH SECTION AT MANHOLE

LT CABLE TRENCH
SECTION BB

NOTES

1. This drawing is sole property of 'Pithavadian and Partners' and must not be reproduced or altered either in full or in part by anyone without consent from us or be passed to any individual or company not authorized by us.
2. Any discrepancy in the drawing should be brought to the immediate attention of the Architect.
3. All dimensions in millimeters and levels in meters.
4. Dimensions to be followed as indicated and not to be scaled.

REV.	DATE	DESCRIPTION	DRAWN	CHKD.
------	------	-------------	-------	-------

REVISIONS

AS BUILT	
CONSTRUCTION	
APPROVAL	
INFORMATION	*
TENDER	
SCHEME	
ISSUED FOR	

INFORMATION

NAME OF THE PROJECT:
PROPOSED FACTORY FOR M/S TEMICO AT BENGALURU

CLIENT:
M/S TEMICO MOTOR INDIA PRIVATE LIMITED

DRAWING TITLE:
CABLE TRENCH DETAIL
MAIN BLOCK

STRUCTURAL CONSULTANT:
ZACHARIA GEORGE F.I.E

SCALE: 1:20 @ A3	DESIGN BY: PDG	DRAWN BY: SHREYA	CHECKED BY: PDG
DATE: 03.10.2022	SIGN:	SIGN:	SIGN:












ARCHITECTURE * INTERIORS * PLANNING * ENGINEERING * MANAGEMENT

PITHAVADIAN AND PARTNERS
Chennai • Bengaluru • Kochi • Hyderabad

10, MURUGAPPA ROAD, NAWAB GARDENS,
KOTTURPURAM, CHENNAI - 600 085

Phone : +91 (0) 44 2447 0033 / 44 166
Fax : +91 (0) 44 2447 0888/4213 2797
email : mail@paparchitect.com
website : www.paparchitect.com



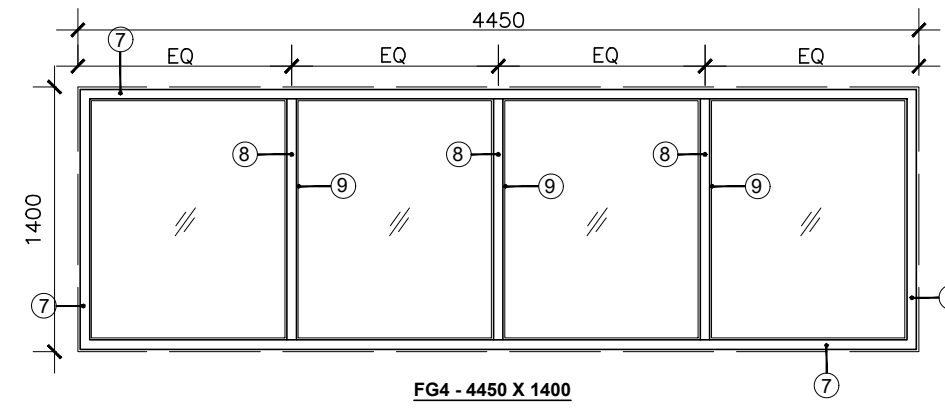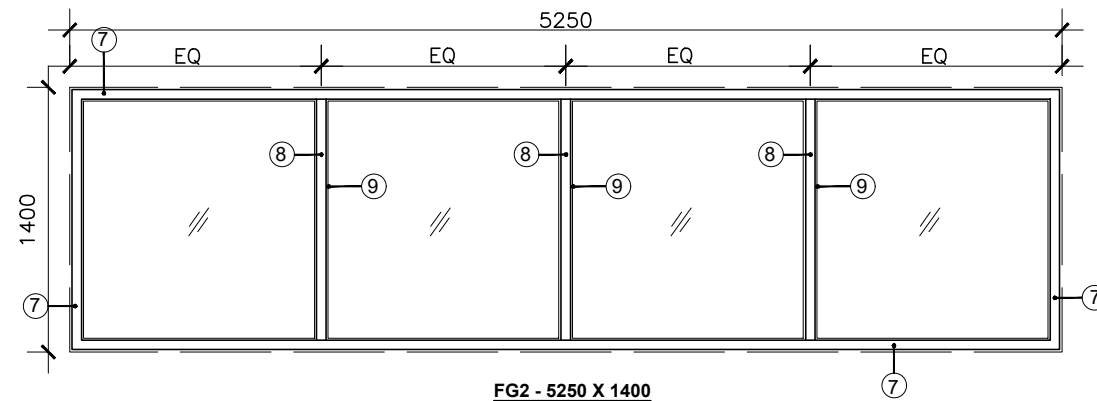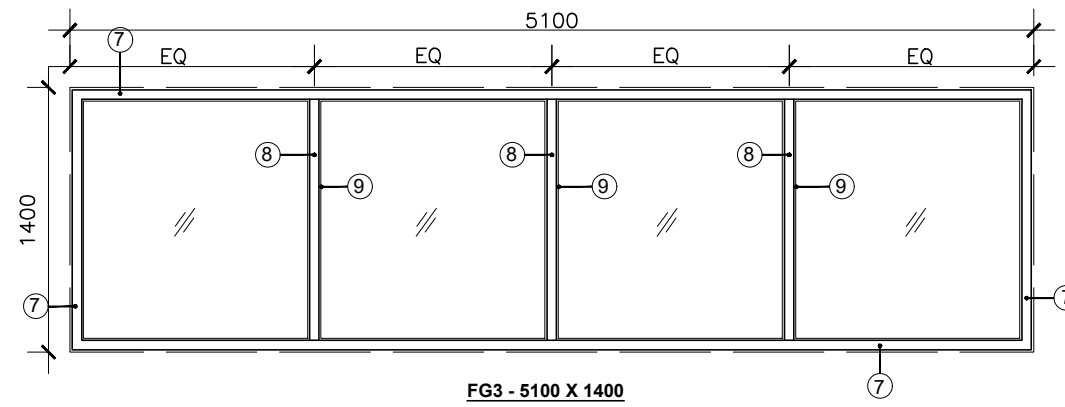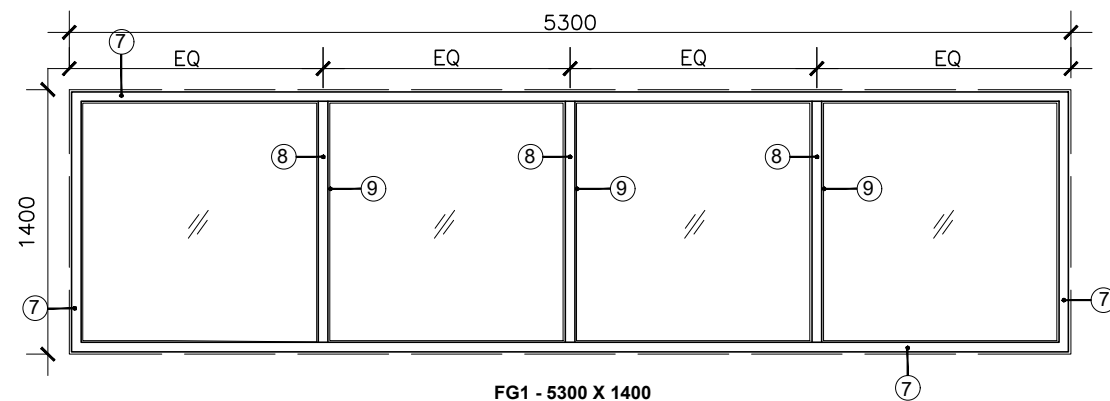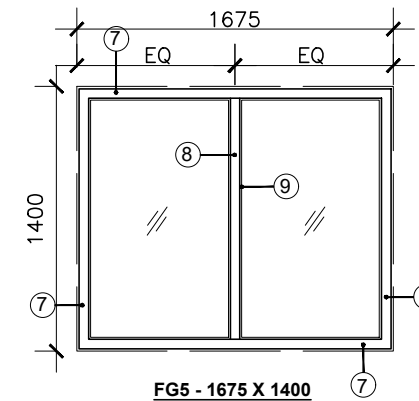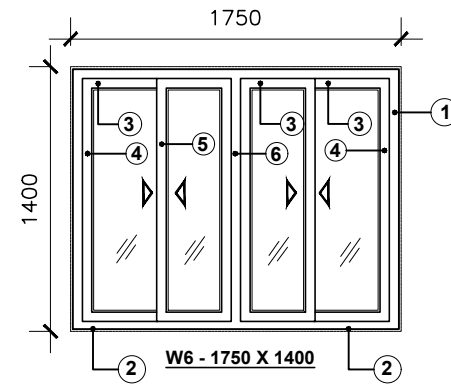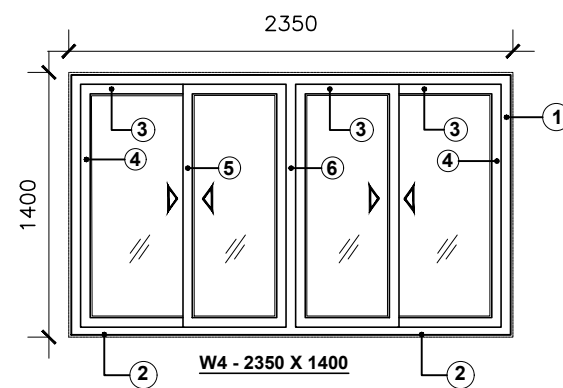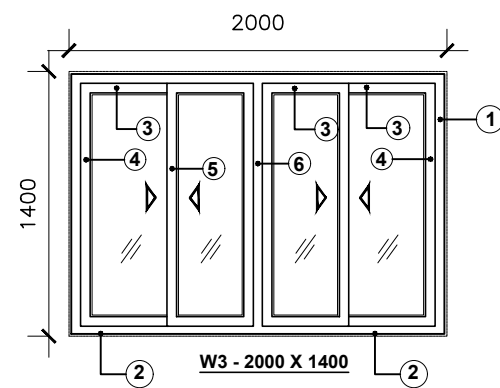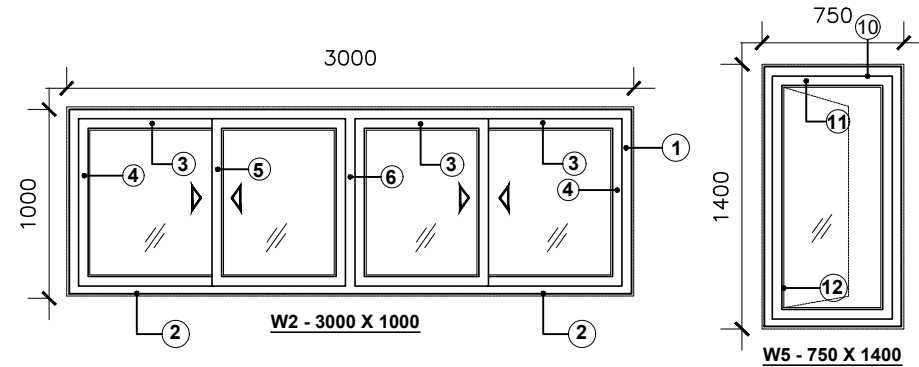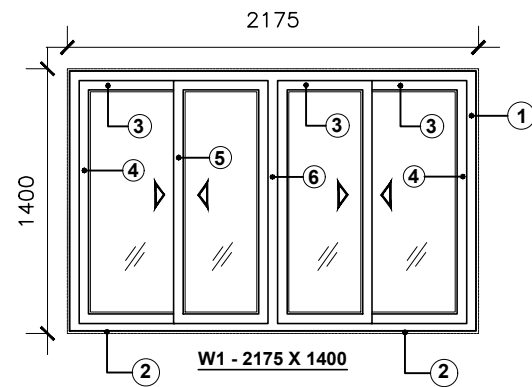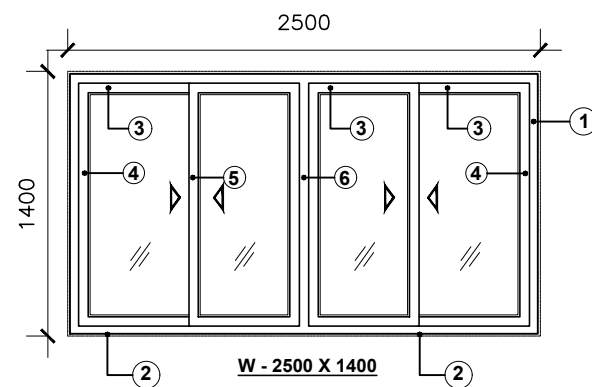

NOTES

- This drawing is sole property of 'Pithavadian and Partners' and must not be reproduced or altered either in full or in part by anyone without consent from us or be passed to any individual or company not authorized by us.
- Any discrepancy in the drawing should be brought to the immediate attention of the Architect.
- All dimensions in millimeters and levels in meters.
- Dimensions to be followed as indicated and not to be scaled.

S.NO.	DESCRIPTION	JINDAL SEC. NO.	WT/KG
SLIDING WINDOW			
1	OUTER FRAME TOP & SIDE	20829	0.784
2	OUTER FRAME BOTTOM	20830	0.909
3	SHUTTER FRAME HORIZONTAL	20736	0.547
4	SHUTTER FRAME VERTICAL	20738	0.547
5	SHUTTER FRAME INTER LOCK	20737	0.607
6	VERTICAL MULLION	20966	0.547
FIXED GLAZING			
7	OUTER FRAME FOR FIXED GLAZING	20047	0.942
8	MULLION	20048	0.942
9	CLIP	19360	0.124
OPENABLE WINDOW			
10	OUTER FRAME	20509	0.663
11	SHUTTER FRAME	20509	0.663
12	CLIP	19360	0.124

REV.	DATE	DESCRIPTION	DRAWN	CHKD.
REVISIONS				
AS BUILT				
CONSTRUCTION				
APPROVAL				
INFORMATION	*			
TENDER				
SCHEME				
ISSUED FOR				

INFORMATION

NAME OF THE PROJECT:
PROPOSED FACTORY FOR M/S TEMICO AT BENGALURU

CLIENT:
M/S TEMICO MOTOR INDIA PRIVATE LIMITED

DRAWING TITLE:
WINDOW JOINERY DETAIL

STRUCTURAL CONSULTANT:
ZACHARIA GEORGE F.I.E

SCALE: 1:50 @ A3	DESIGN BY: PDG	DRAWN BY: SHREYA	CHECKED BY: PDG
DATE: 07.10.2022	SIGN:	SIGN:	SIGN:

ARCHITECTURE * INTERIORS * PLANNING * ENGINEERING * MANAGEMENT



PITHAVADIAN AND PARTNERS
Chennai • Bengaluru • Kochi • Hyderabad

10, MURUGAPPA ROAD, NAWAB GARDENS,
KOTURPURAM, CHENNAI - 600 085


Phone : +91 (0) 44 2447 0033 / 44 166
Fax : +91 (0) 44 2447 0888/4213 2797
email : mail@paparchitect.com
website : www.paparchitect.com




DWG NO: 02-02 (SHT 01 OF 01) REV NO: 0

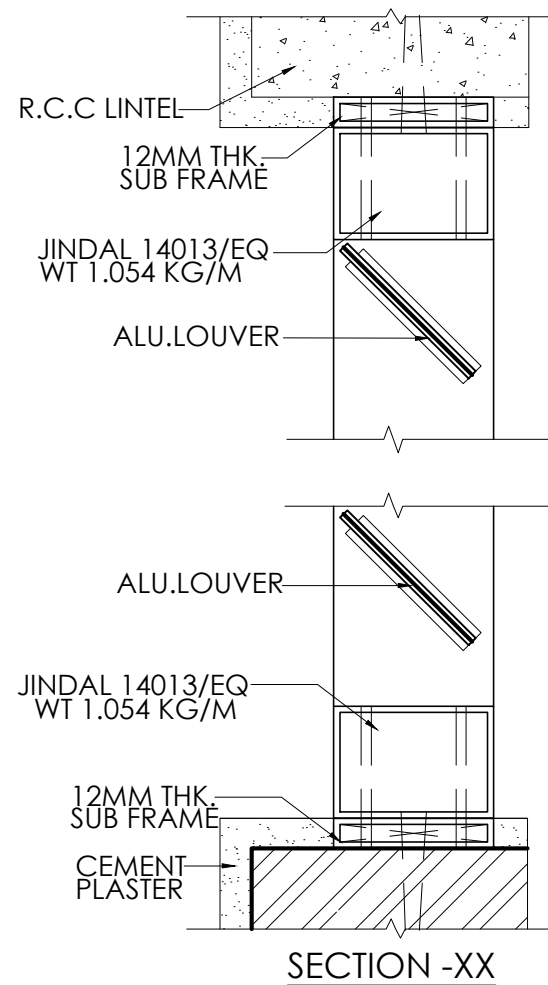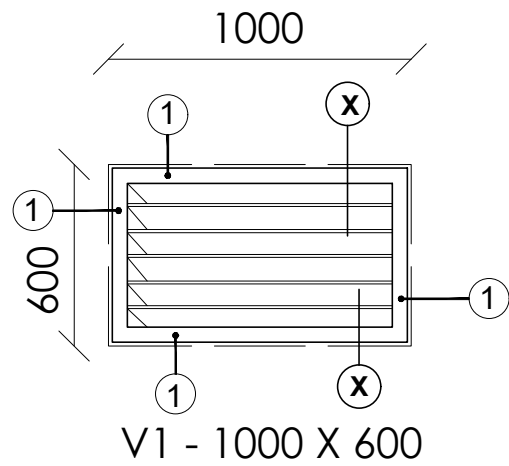


S.NO.	DESCRIPTION	JINDAL SEC. NO.	WT/KG
VENTILATOR			
1	OUTER FRAME & MULLION FOR LOUVERED VENTILATOR	14013/EQ	1.054


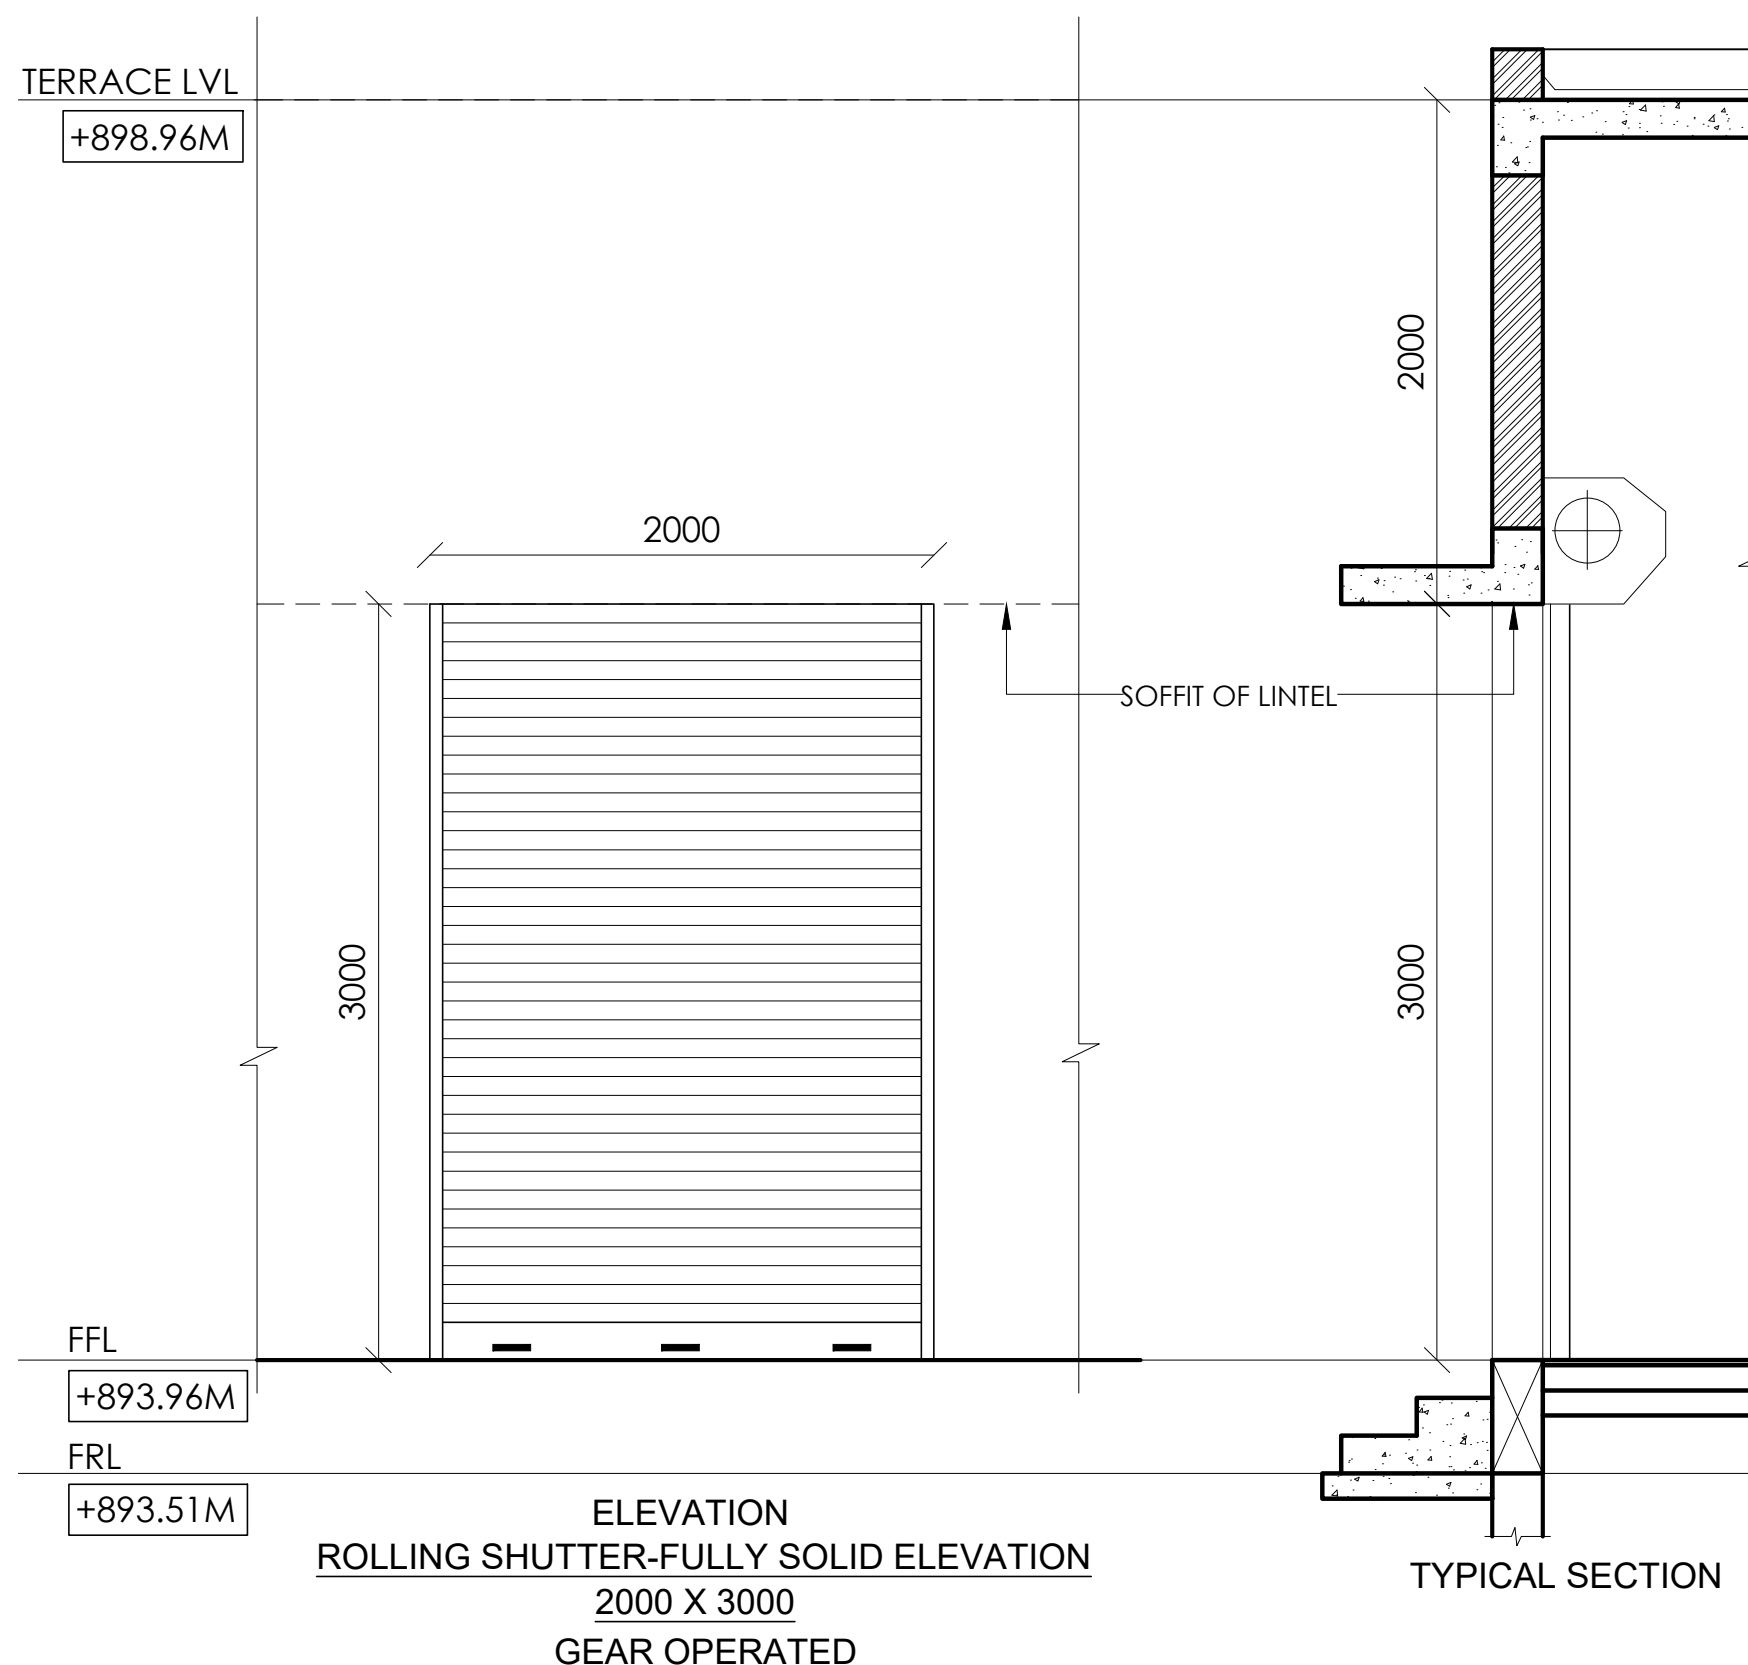


- NOTES
1. This drawing is sole property of 'Pithavadian And Partners' and must not be reproduced or altered either in full or in part by anyone without consent from us or be passed to any individual or company not authorized by us.
 2. Any discrepancy in the drawing should be brought to the immediate attention of the Architect.
 3. All dimensions in millimeters and levels in meters.
 4. Dimensions to be followed as indicated and not to be scaled.

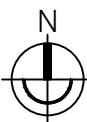REV.	DATE	DESCRIPTION	DRAWN	CHKD.
REVISIONS				
AS BUILT		INFORMATION		
CONSTRUCTION				
APPROVAL				
INFORMATION	*			
TENDER				
SCHEME				
ISSUED FOR				
NAME OF THE PROJECT:				
PROPOSED FACTORY FOR M/S TEMICO AT BENGALURU				
CLIENT:				
M/S TEMICO MOTOR INDIA PRIVATE LIMITED				
	DRAWING TITLE:			
	JOINERY DETAIL			
	ANCILLARY BUILDING			
	STRUCTURAL CONSULTANT:			
ZACHARIA GEORGE F.I.E				
SCALE:	DESIGN BY:	DRAWN BY:	CHECKED BY:	
1:25 @ A3	PDG	SHREYA	PDG	
DATE:	SIGN:	SIGN:	SIGN:	
25.07.2022				
ARCHITECTURE * INTERIORS * PLANNING * ENGINEERING * MANAGEMENT				
PITHAVADIAN AND PARTNERS				
Chennai • Bengaluru • Kochi • Hyderabad				
10, MURUGAPPA ROAD, NAWAB GARDENS, KOTTURPURAM, CHENNAI - 600 085				
Phone	: +91 (0) 44 2447 0033 / 44 / 66			
Fax	: +91 (0) 44 2447 0888/4213 2797			
email	: mail@paparchitect.com			
website	: www.paparchitect.com			
DWG NO: 02-03A		(SHT 01 OF 02)		REV NO: 0

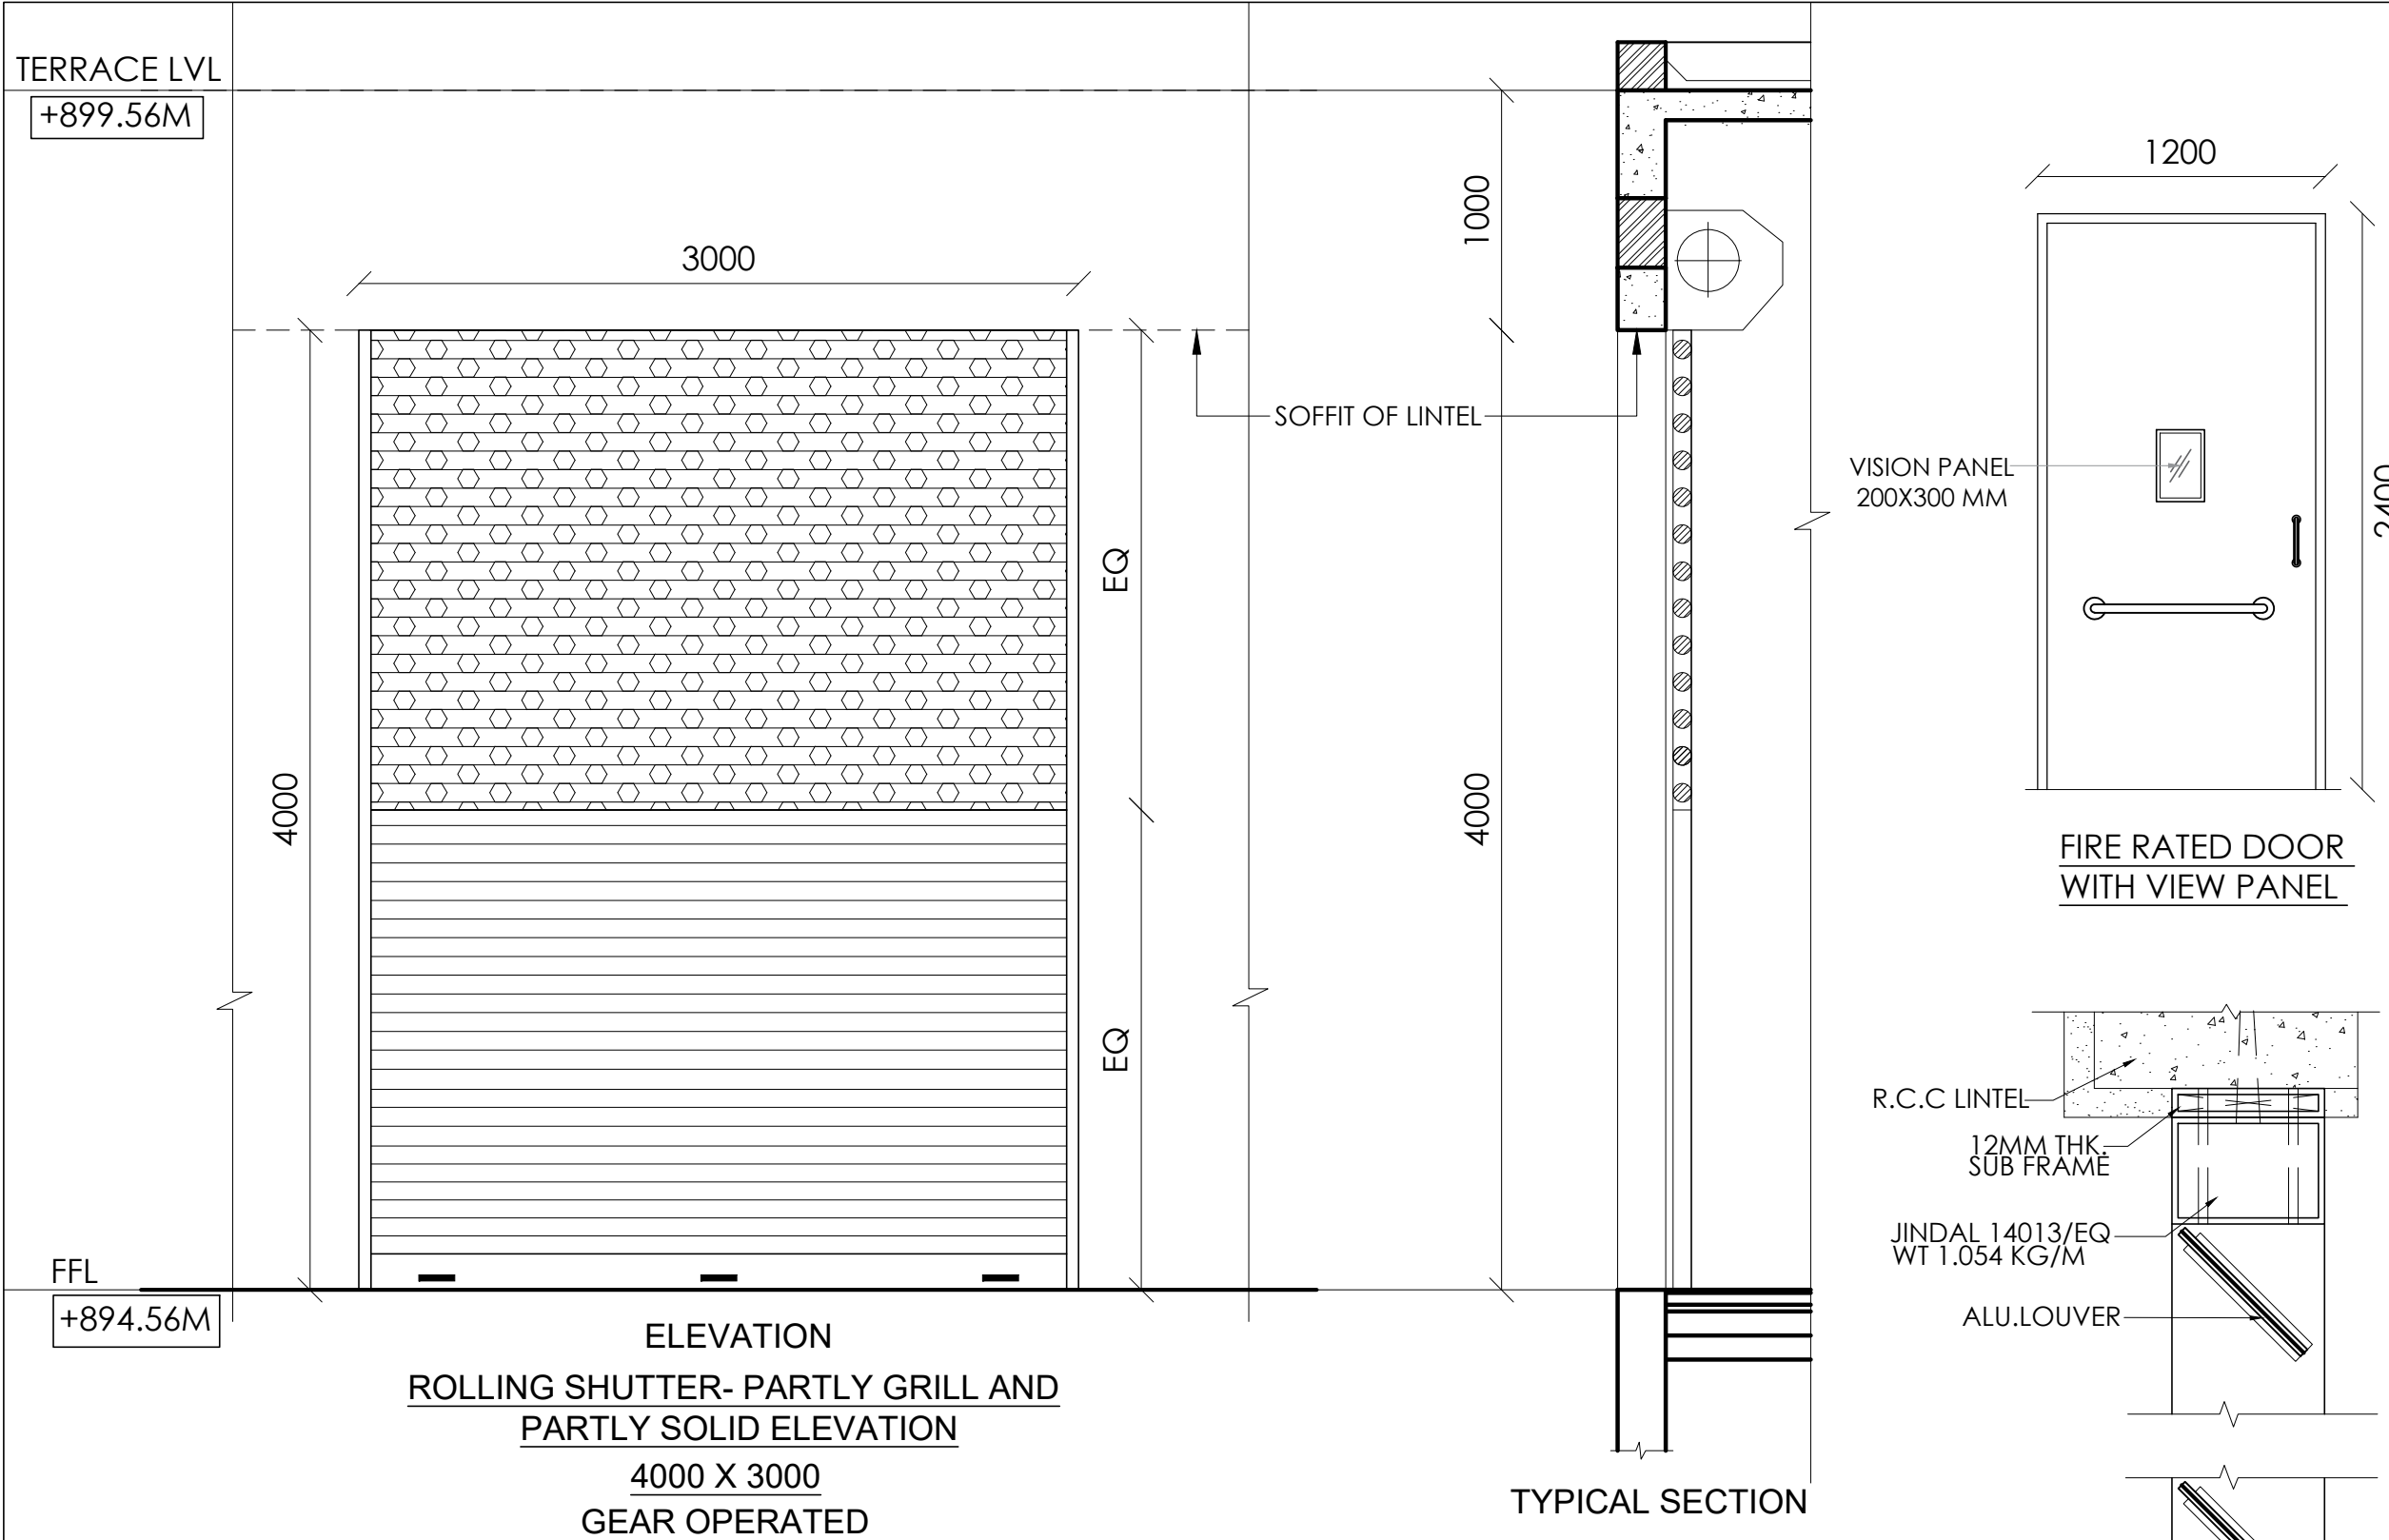

S.NO.	DESCRIPTION	JINDAL SEC. NO.	WT/KG
VENTILATOR			
1	OUTER FRAME & MULLION FOR LOUVERED VENTILATOR	14013/EQ	1.054

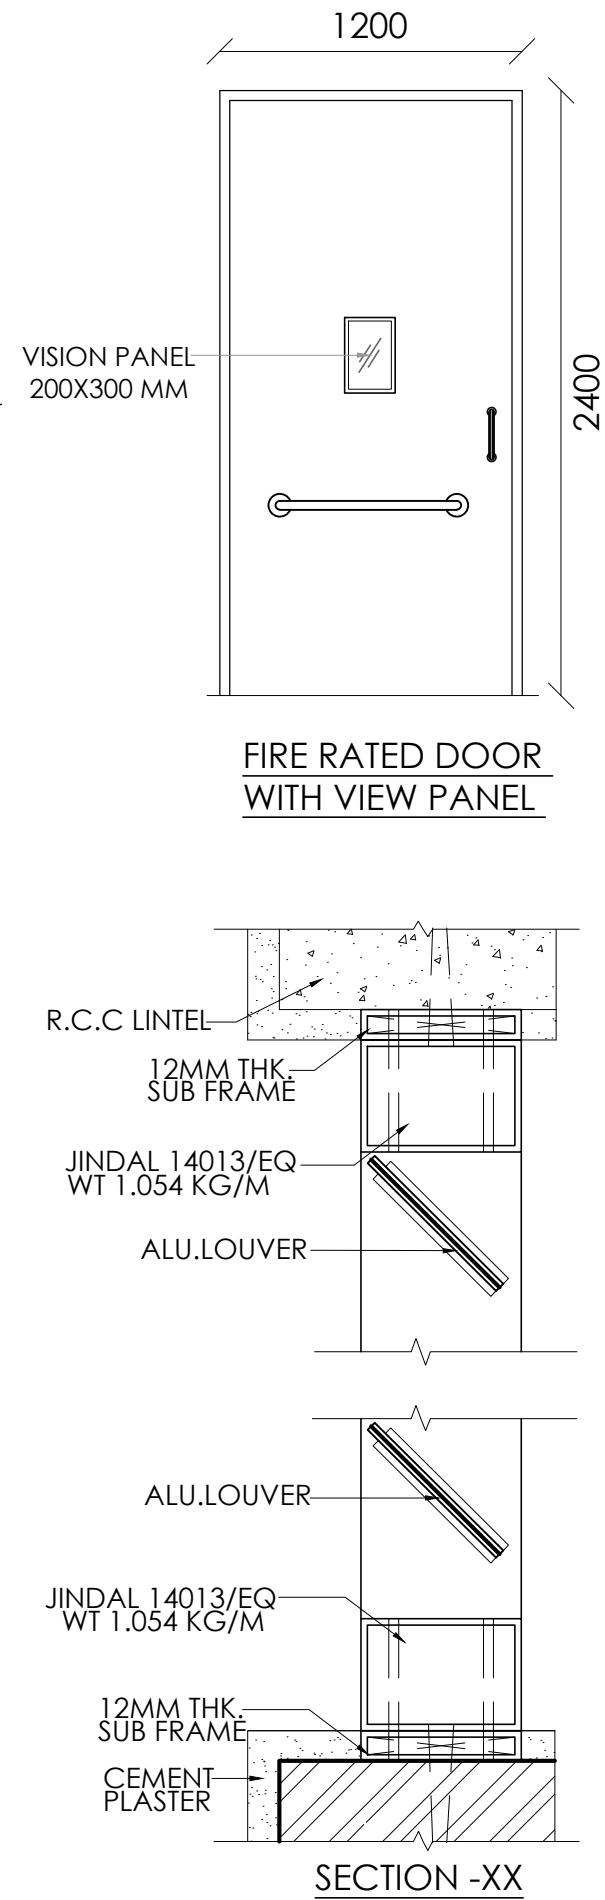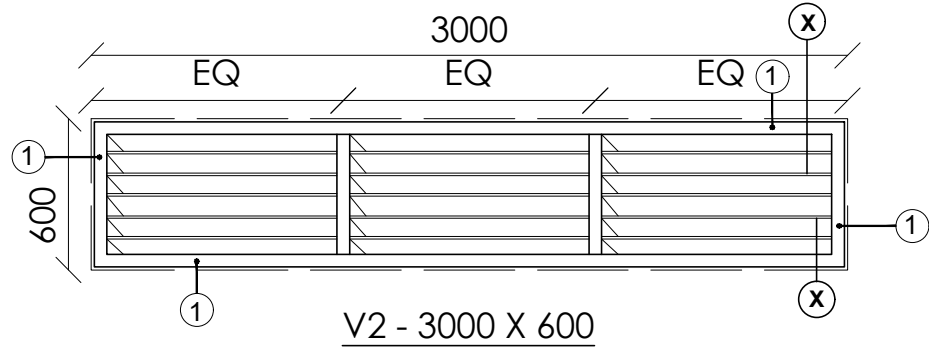

NOTES


1. This drawing is sole property of 'Pithavadian And Partners' and must not be reproduced or altered either in full or in part by anyone without consent from us or be passed to any individual or company not authorized by us.

2. Any discrepancy in the drawing should be brought to the immediate attention of the Architect.


3. All dimensions in millimeters and levels in meters.

4. Dimensions to be followed as indicated and not to be scaled.

REV.	DATE	DESCRIPTION	DRAWN	CHKD.
REVISIONS				
AS BUILT				
CONSTRUCTION				
APPROVAL				
INFORMATION *				
TENDER				
SCHEME				
ISSUED FOR				
NAME OF THE PROJECT:				
PROPOSED FACTORY FOR M/S TEMICO AT BENGALURU				
CLIENT:				
M/S TEMICO MOTOR INDIA PRIVATE LIMITED				
DRAWING TITLE:				
JOINERY DETAIL				
SUBSTATION BLOCK				
STRUCTURAL CONSULTANT:				
ZACHARIA GEORGE F.I.E				
SCALE:		DESIGN BY:	DRAWN BY:	CHECKED BY:
1:25 @ A3		PDG	SHREYA	PDG
DATE:		SIGN:	SIGN:	SIGN:
25.07.2022				
ARCHITECTURE * INTERIORS * PLANNING * ENGINEERING * MANAGEMENT				
PITHAVADIAN AND PARTNERS				
Chennai • Bengaluru • Kochi • Hyderabad				
10, MURUGAPPA ROAD, NAWAB GARDENS,				
KOTURPURAM, CHENNAI - 600 085				
Phone : +91 (0) 44 2447 0033 / 44 / 66				
Fax : +91 (0) 44 2447 0888/4213 2797				
email : mail@paparchitect.com				
website : www.paparchitect.com				
DWG NO: 02-03B (SHT 02 OF 02) REV NO: 0				

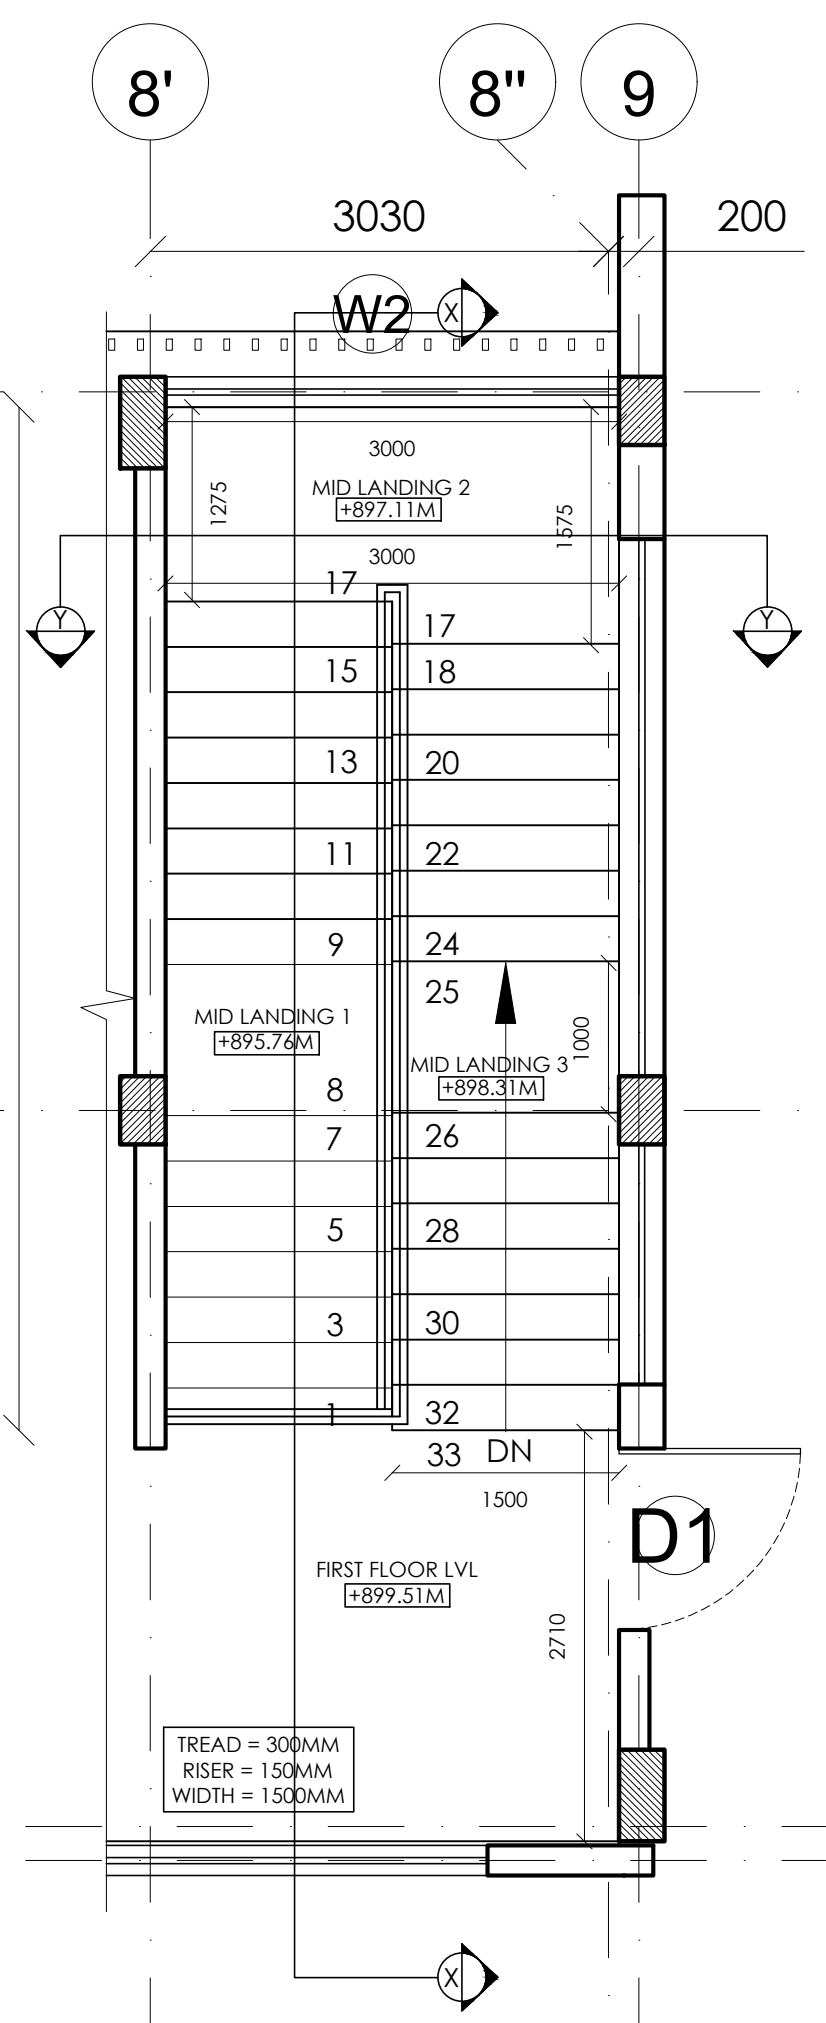

FIRST FLOOR PLAN

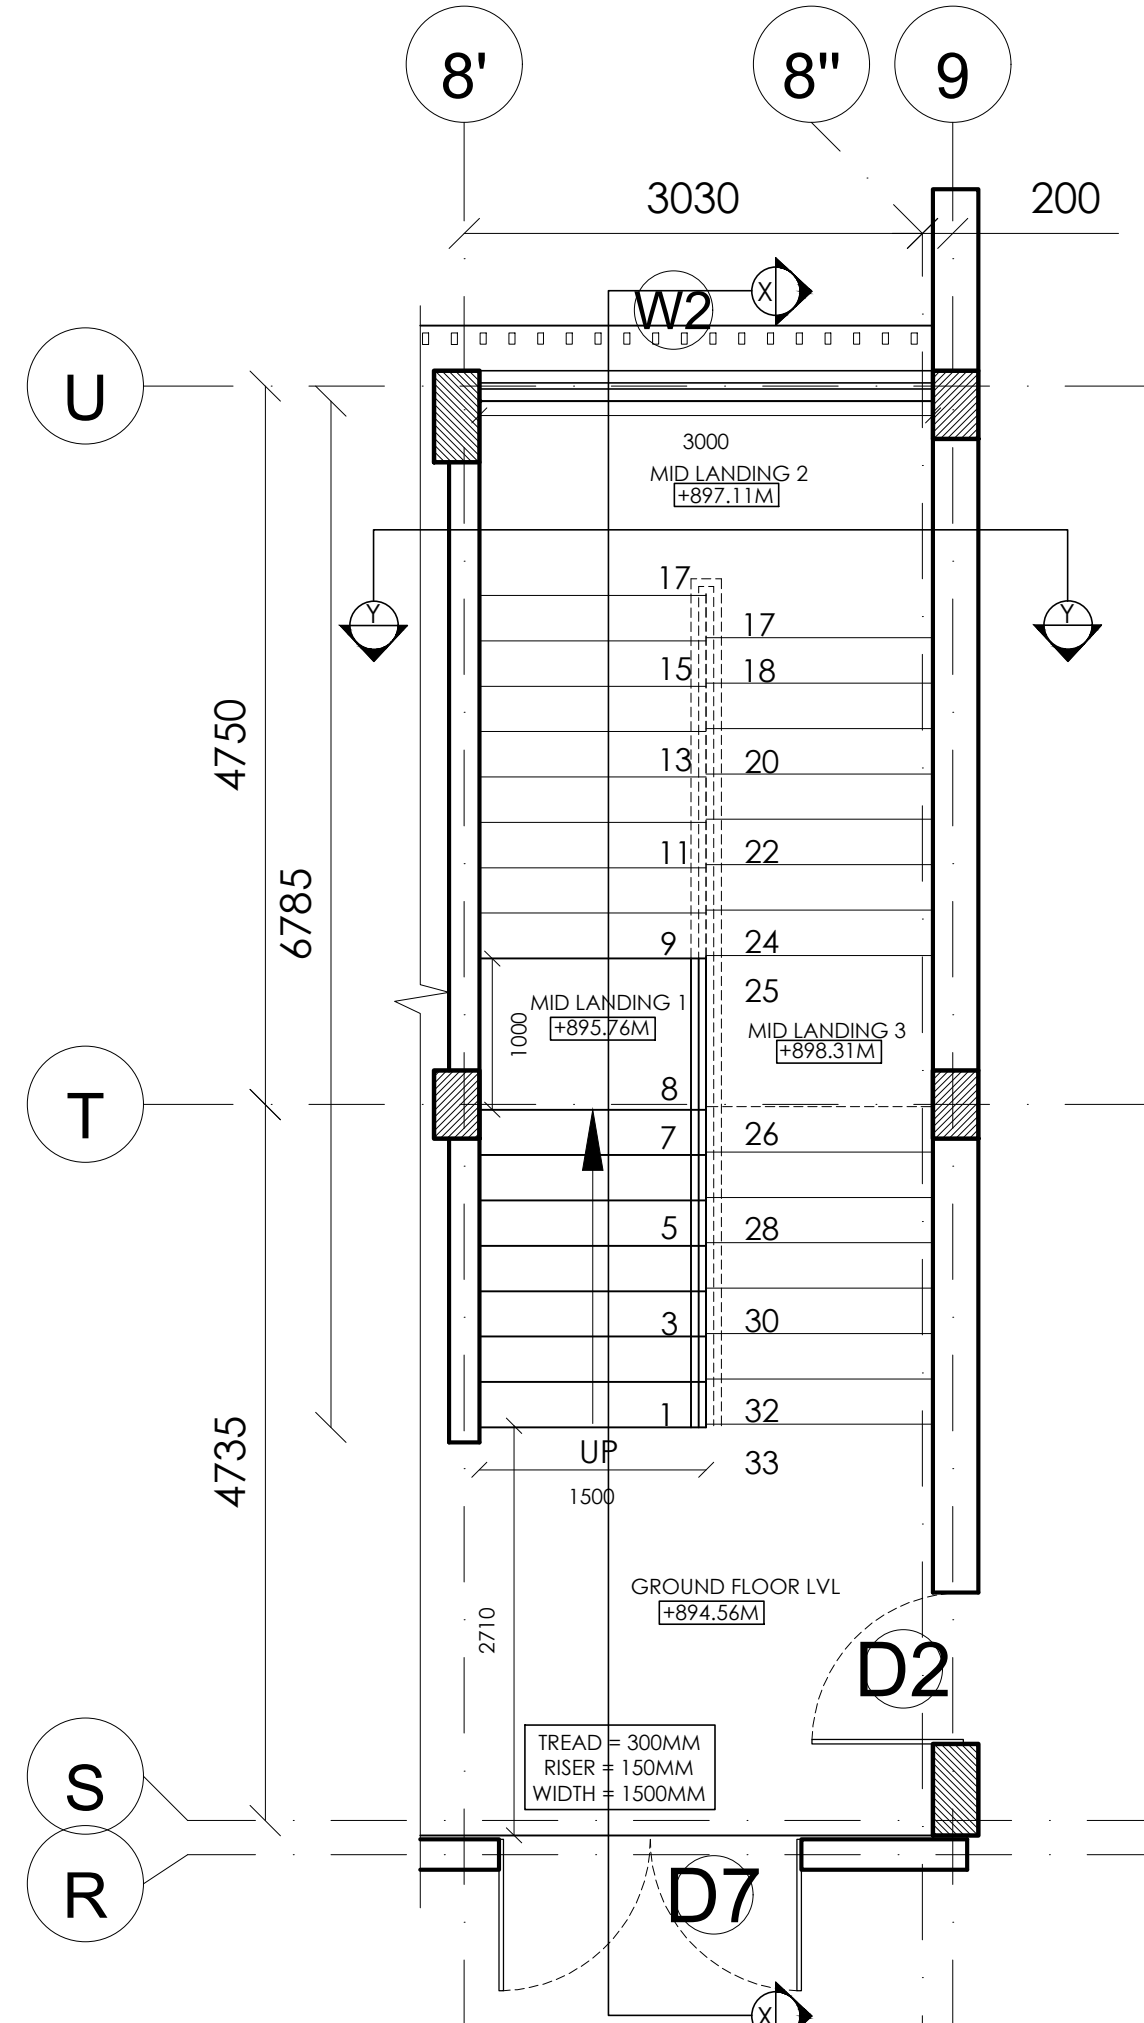

GROUND FLOOR PLAN

NOTES

- This drawing is sole property of 'Pithavadian And Partners' and must not be reproduced or altered either in full or in part by anyone without consent from us or be passed to any individual or company not authorized by us.
- Any discrepancy in the drawing should be brought to the immediate attention of the Architect.
- All dimensions in millimeters and levels in meters.
- Dimensions to be followed as indicated and not to be scaled.

REV.	DATE	DESCRIPTION	DRAWN	CHKD.
AS BUILT				
CONSTRUCTION				
APPROVAL				
INFORMATION	*			
TENDER				
SCHEME				
ISSUED FOR				

NAME OF THE PROJECT:
PROPOSED FACTORY FOR M/S TEMICO AT BENGALURU

CLIENT:
M/S TEMICO MOTOR INDIA PRIVATE LIMITED

DRAWING TITLE:
STAIRCASE DETAIL 1
PLANS

STRUCTURAL CONSULTANT:
ZACHARIA GEORGE F.I.E

SCALE:	DESIGN BY:	DRAWN BY:	CHECKED BY:
1:50 @ A3	PDG	SHREYA	PDG
DATE: 13.07.2022	SIGN:	SIGN:	SIGN:

ARCHITECTURE * INTERIORS * PLANNING * ENGINEERING * MANAGEMENT

PITHAVADIAN AND PARTNERS
Chennai • Bengaluru • Kochi • Hyderabad
10, MURUGAPPA ROAD, NAWAB GARDENS,
KOTURPURAM, CHENNAI - 600 085
Phone : +91 (0) 44 2447 0033 / 44 166
Fax : +91 (0) 44 2447 0888/4213 2797
email : mail@paparchitect.com
website : www.paparchitect.com

PNP

DWG NO: 02-04A (SHT 01 OF 03) REV NO: 0

NOTES

1. This drawing is sole property of 'Pithavadian And Partners' and must not be reproduced or altered either in full or in part by anyone without consent from us or be passed to any individual or company not authorized by us.
2. Any discrepancy in the drawing should be brought to the immediate attention of the Architect.
3. All dimensions in millimeters and levels in meters.
4. Dimensions to be followed as indicated and not to be scaled.

TERRACE LVL

+903.51M

FIRST FLOOR LVL

+899.51M

MID LANDING 3 LVL

+898.31M

MID LANDING 2 LVL

+896.81M

MID LANDING 1 LVL

+895.76M

FFL

+894.56M

FRL

+893.51M

FGL -
BELOW ROAD

+893.10M

FGL -
BELOW BUILDING

+893.41M

4000

8950

2400

3750

2550

1200

1050

1050

410

100

1000

2550

4750

4735

225

U

T

S

R

SECTION XX

D1

2M WIDE
CORRIDORTREAD = 300MM
RISER = 150MM
WIDTH = 1500MM

D2


2M WIDE
CORRIDOR


FLIGHT 4

FLIGHT 3

FLIGHT 2

FLIGHT 1

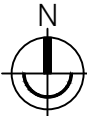REV.	DATE	DESCRIPTION	DRAWN	CHKD.
REVISIONS				
AS BUILT		INFORMATION		
CONSTRUCTION				
APPROVAL				
INFORMATION	*			
TENDER				
SCHEME				
ISSUED FOR				
NAME OF THE PROJECT:				
PROPOSED FACTORY FOR M/S TEMICO AT BENGALURU				
CLIENT:				
M/S TEMICO MOTOR INDIA PRIVATE LIMITED				
		DRAWING TITLE:		
		STAIRCASE DETAIL 1		
		SECTION XX		
		STRUCTURAL CONSULTANT:		
		ZACHARIA GEORGE F.I.E		
SCALE:	DESIGN BY:	DRAWN BY:	CHECKED BY:	
1:50 @ A3	PDG	SHREYA	PDG	
DATE:	SIGN:	SIGN:	SIGN:	
13.07.2022				
ARCHITECTURE * INTERIORS * PLANNING * ENGINEERING * MANAGEMENT				
PITHAVADIAN AND PARTNERS				
Chennai • Bengaluru • Kochi • Hyderabad				
10, MURUGAPPA ROAD, NAWAB GARDENS, KOTURPURAM, CHENNAI - 600 085				
Phone : +91 (0) 44 2447 0033 / 44 / 66				
Fax : +91 (0) 44 2447 0888/4213 2797				
email : mail@paparchitect.com				
website : www.paparchitect.com				
DWG NO: 02-04B		(SHT 02 OF 03)		REV NO: 0

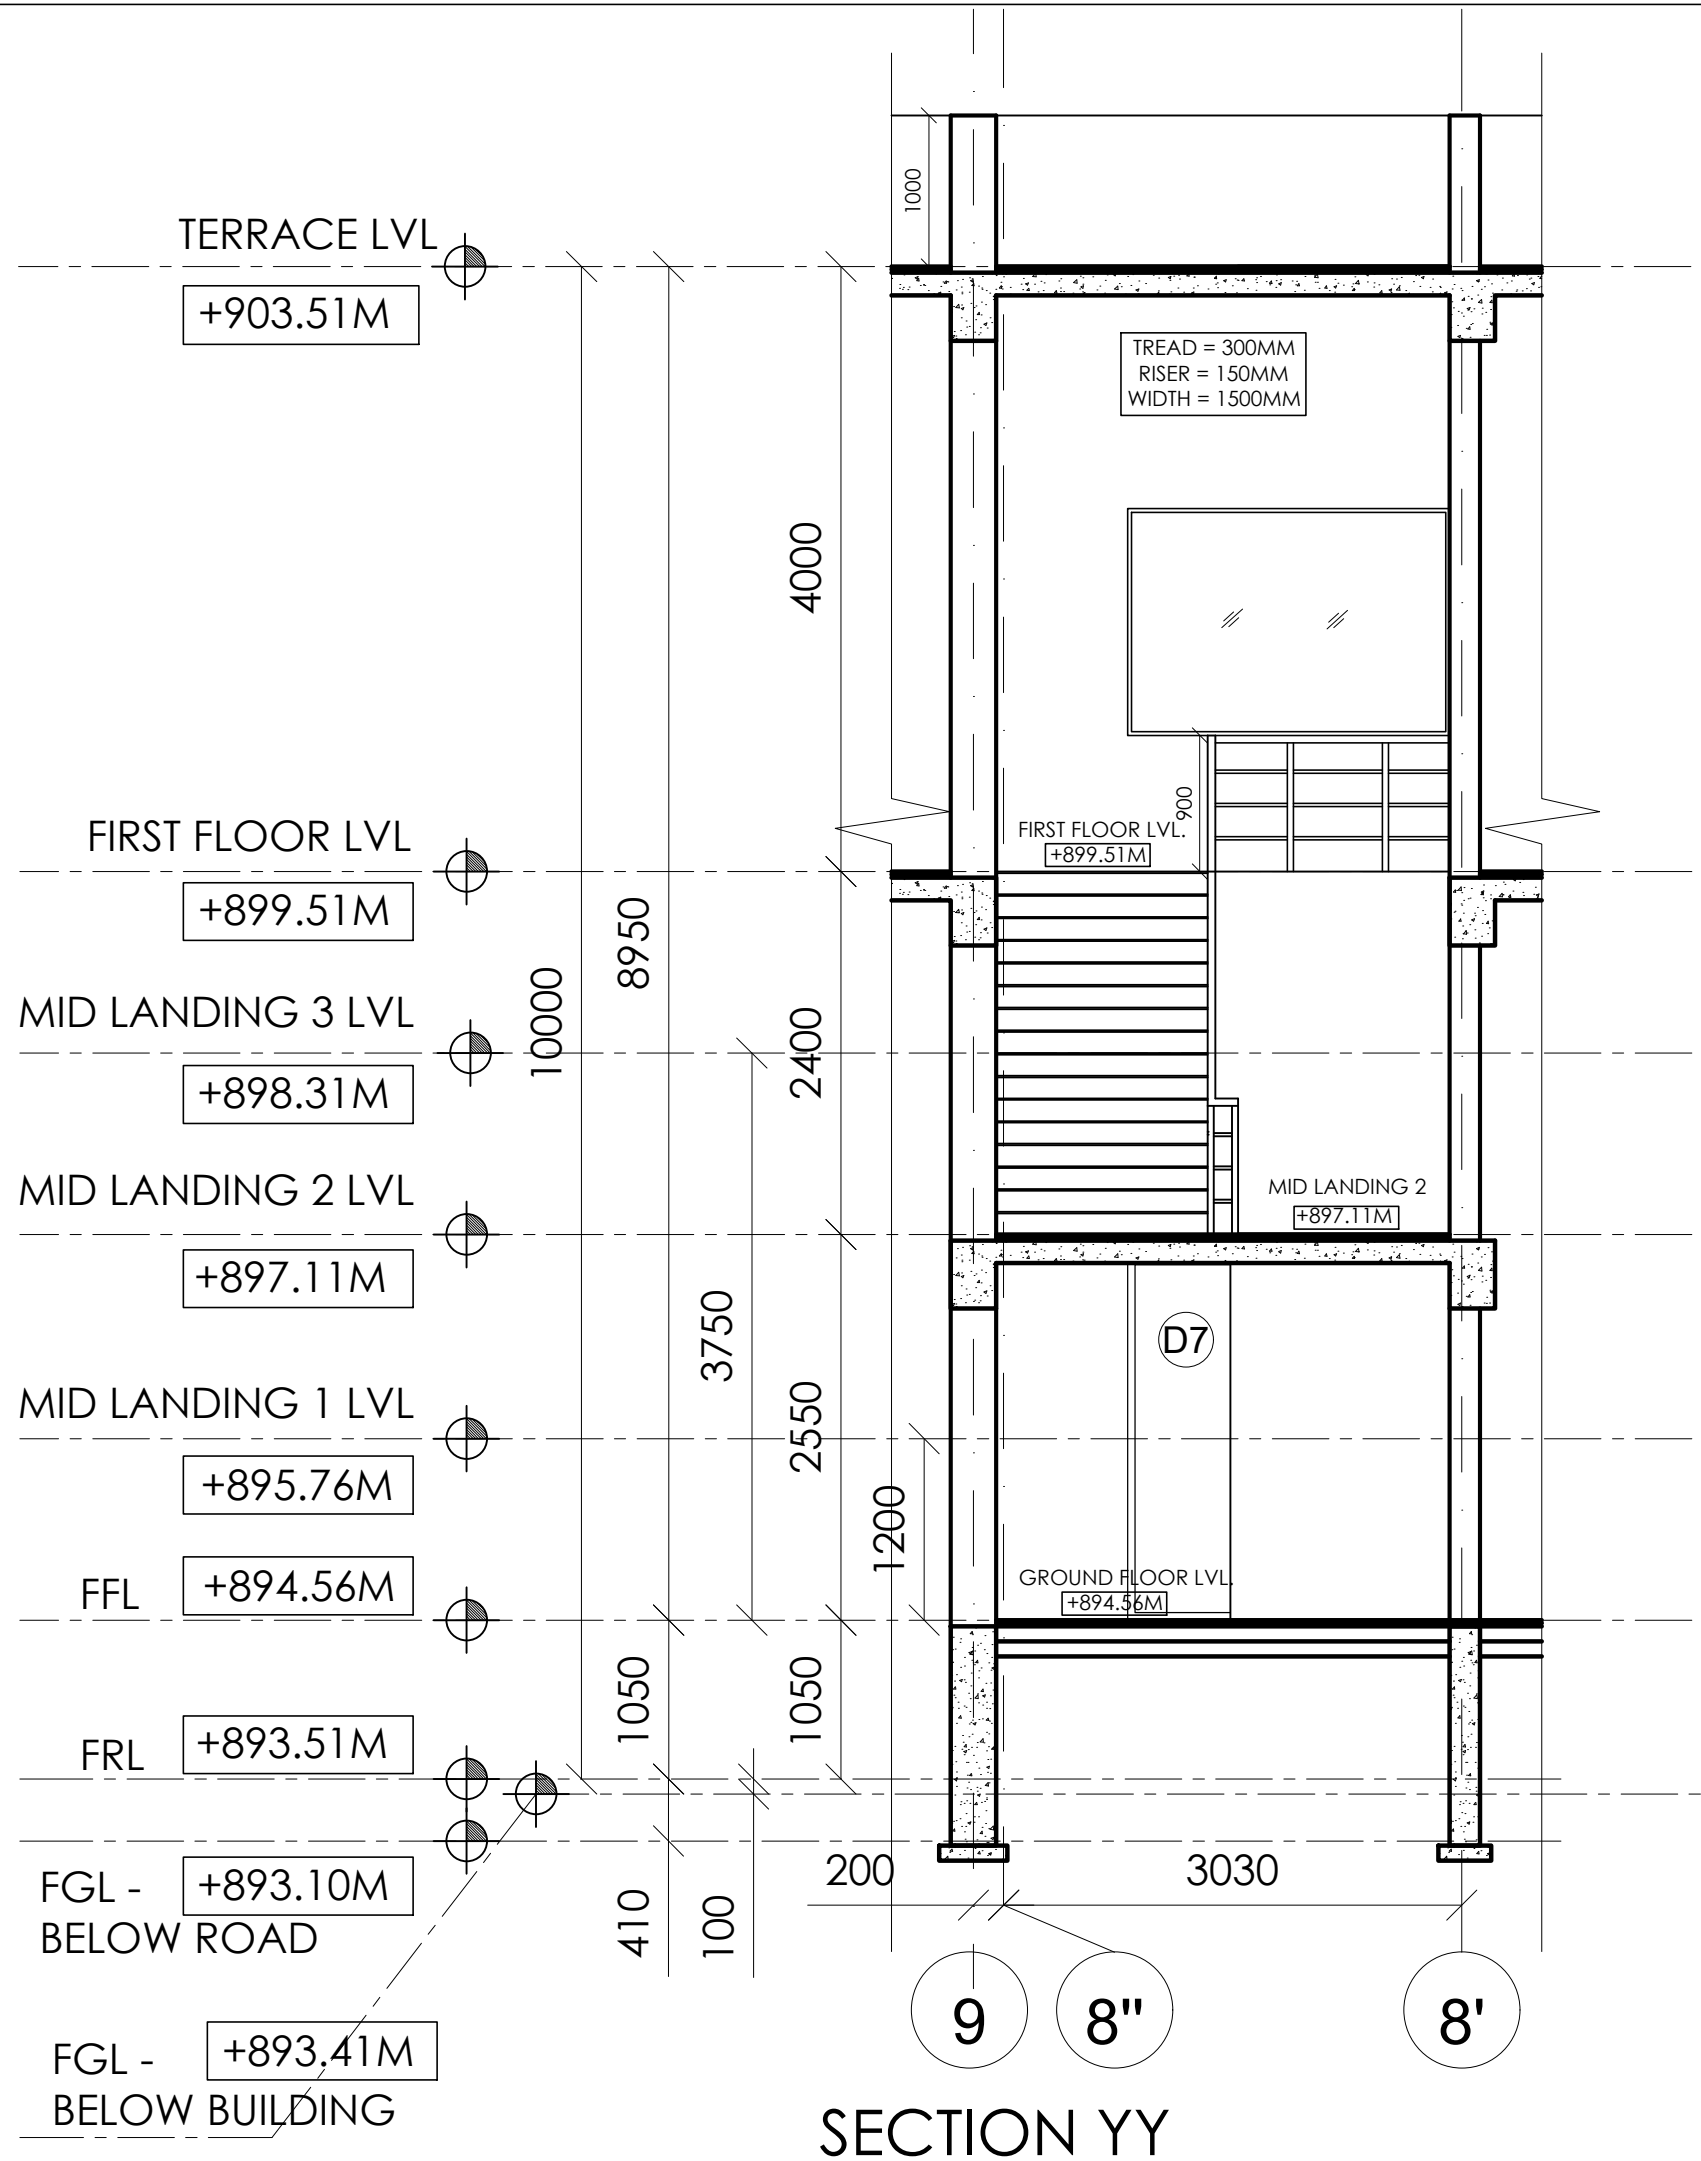

NOTES

1. This drawing is sole property of 'Pithavadian and Partners' and must not be reproduced or altered either in full or in part by anyone without consent from us or be passed to any individual or company not authorised by us.

2. Any discrepancy in the drawing should be brought to the immediate attention of the Architect.

3. All dimensions in millimeters and levels in meters.

4. Dimensions to be followed as indicated and not to be scaled.

REV.	DATE	DESCRIPTION	DRAWN	CHKD.
REVISIONS				
AS BUILT				
CONSTRUCTION				
APPROVAL				
INFORMATION *				
TENDER				
SCHEME				
ISSUED FOR				

NAME OF THE PROJECT:

PROPOSED FACTORY FOR M/S TEMICO AT BENGALURU

CLIENT:

M/S TEMICO MOTOR INDIA PRIVATE LIMITED

N

DRAWING TITLE:

STAIRCASE DETAIL 1

SECTION YY

STRUCTURAL CONSULTANT:

ZACHARIA GEORGE F.I.E

SCALE:	DESIGN BY:	DRAWN BY:	CHECKED BY:
1:50 @ A3	PDG	SHREYA	PDG
DATE:	SIGN:	SIGN:	SIGN:
13.07.2022			

ARCHITECTURE * INTERIORS * PLANNING * ENGINEERING * MANAGEMENT

PITHAVADIAN AND PARTNERS

Chennai • Bengaluru • Kochi • Hyderabad

10, MURUGAPPA ROAD, NAWAB GARDENS,
KOTTURPURAM, CHENNAI - 600 085

Phone : +91 (0) 44 2447 0033 / 44 166

Fax : +91 (0) 44 2447 0888/4213 2797




email : mail@paparchitect.com

website : www.paparchitect.com


DWG NO: 02-04C

(SHT 03 OF 03)

REV NO: 0

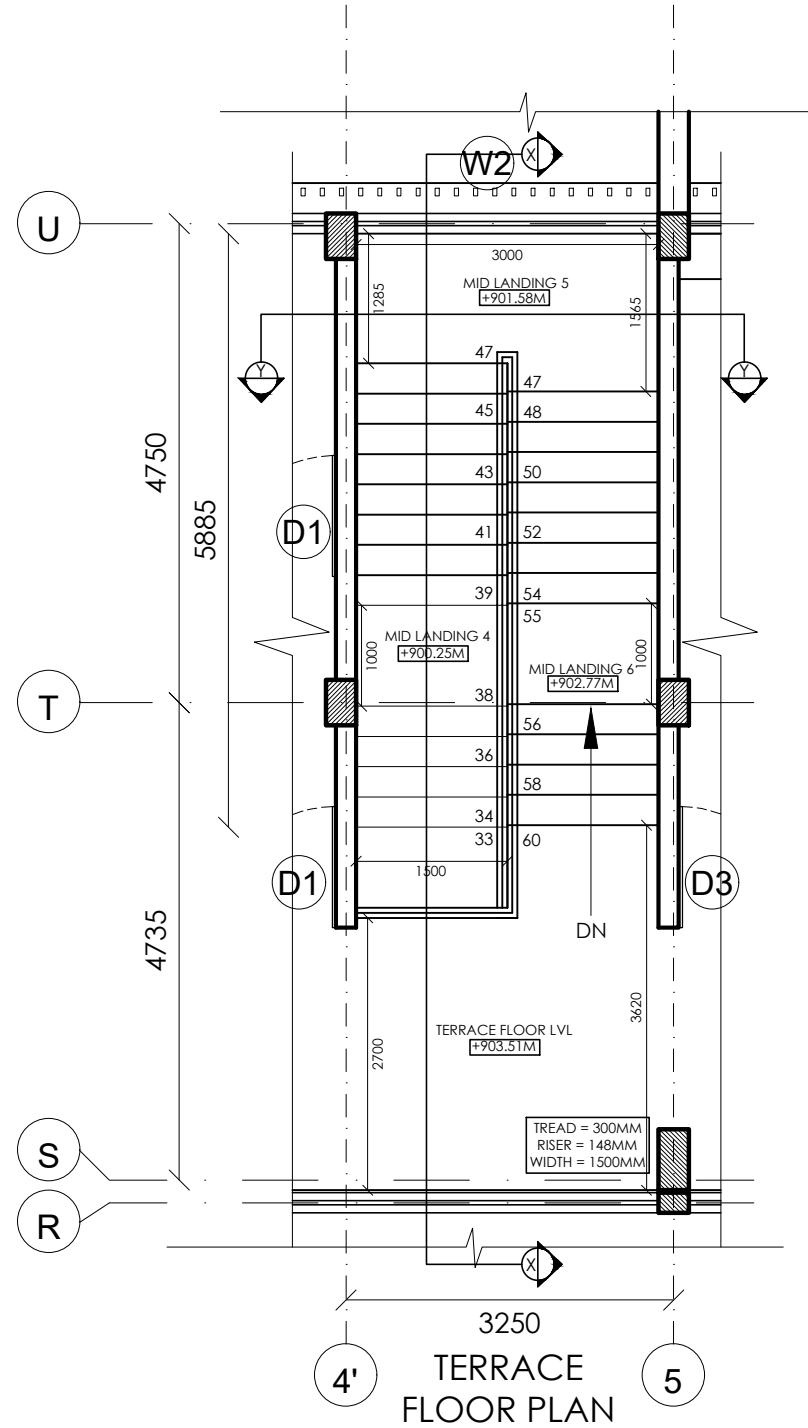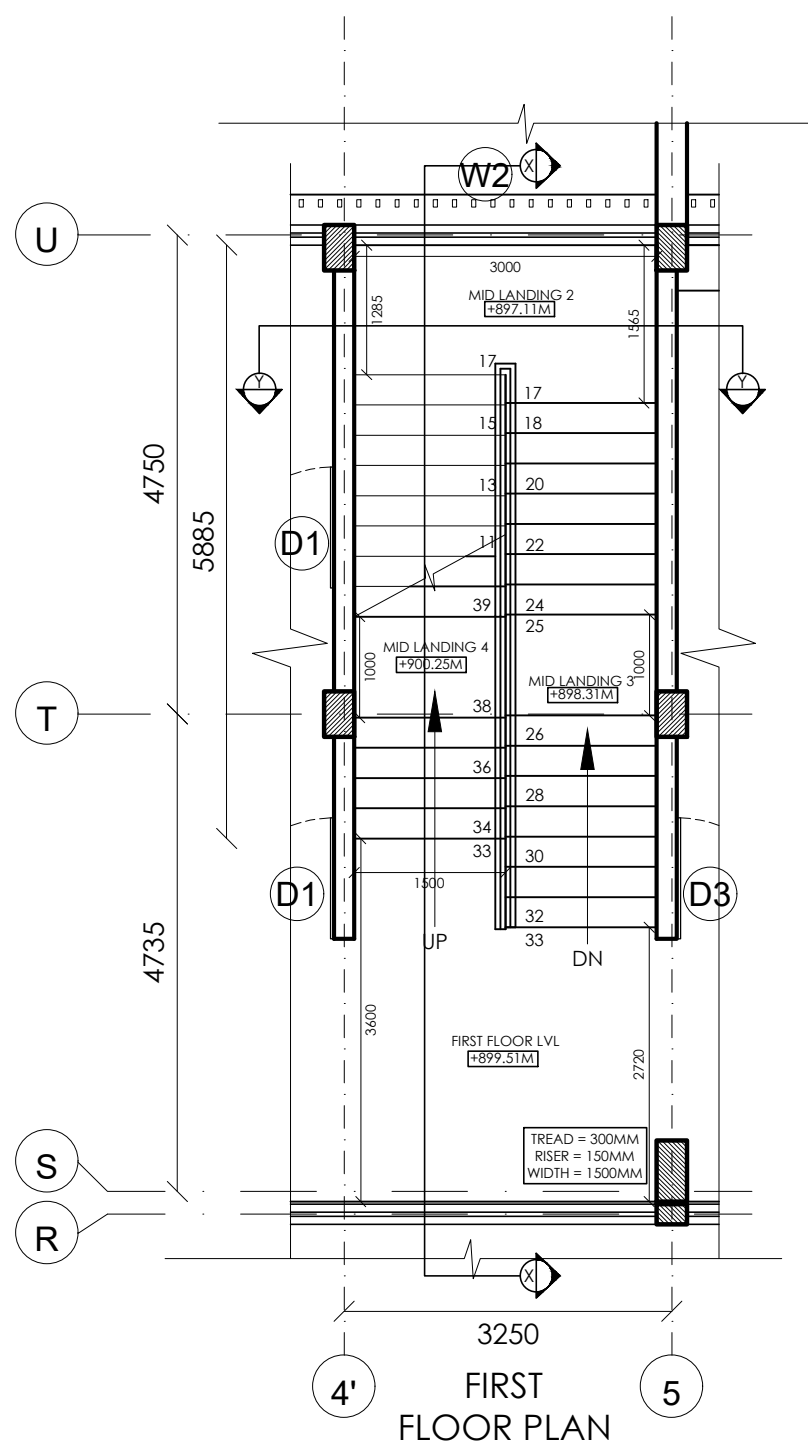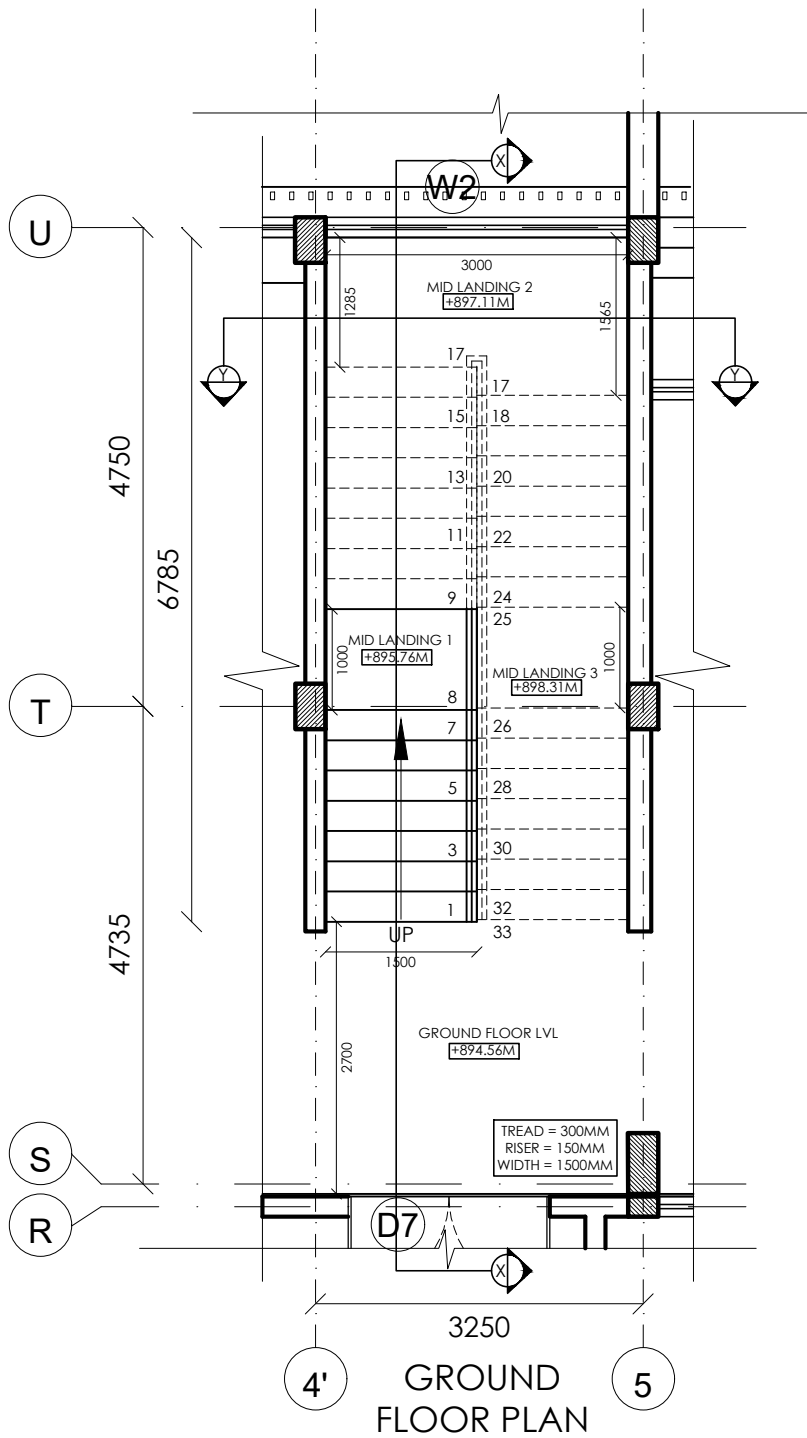

- NOTES
1. This drawing is sole property of 'Pithavadian and Partners' and must not be reproduced or altered either in full or in part by anyone without consent from us or be passed to any individual or company not authorized by us.
 2. Any discrepancy in the drawing should be brought to the immediate attention of the Architect.
 3. All dimensions in millimeters and levels in meters.
 4. Dimensions to be followed as indicated and not to be scaled.

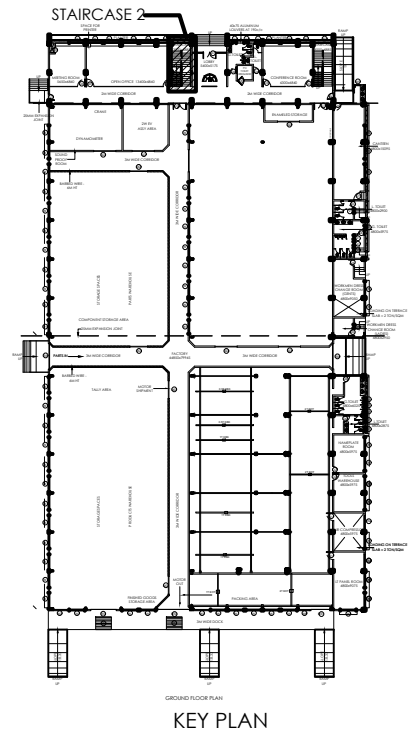

REV.	DATE	DESCRIPTION	DRAWN	CHKD.
REVISIONS				
AS BUILT				
CONSTRUCTION				
APPROVAL				
INFORMATION *				
TENDER				
SCHEME				
ISSUED FOR				
NAME OF THE PROJECT:				
PROPOSED FACTORY FOR M/S TEMICO AT BENGALURU				
CLIENT:				
M/S TEMICO MOTOR INDIA PRIVATE LIMITED				
DRAWING TITLE:				
STAIRCASE DETAIL 2				
PLANS				
STRUCTURAL CONSULTANT:				
ZACHARIA GEORGE F.I.E				
SCALE:	DESIGN BY:	DRAWN BY:	CHECKED BY:	
1:75 @ A3	PDG	SHREYA	PDG	
DATE:	SIGN:	SIGN:	SIGN:	
11.08.2022				

ARCHITECTURE * INTERIORS * PLANNING * ENGINEERING * MANAGEMENT

PITHAVADIAN AND PARTNERS

Chennai • Bengaluru • Kochi • Hyderabad

10, MURUGAPPA ROAD, NAWAB GARDENS, KOTURPURAM, CHENNAI - 600 085

Phone : +91 (0) 44 2447 0033 / 44 166

Fax : +91 (0) 44 2447 0888/4213 2797

email : mail@paparchitect.com


website : www.paparchitect.com

DWG NO: 02-05A (SHT 01 OF 02) REV NO: 0



NOTES

1. This drawing is sole property of 'Pithavadian And Partners' and must not be reproduced or altered either in full or in part by anyone without consent from us or be passed to any individual or company not authorized by us.
2. Any discrepancy in the drawing should be brought to the immediate attention of the Architect.
3. All dimensions in millimeters and levels in meters.
4. Dimensions to be followed as indicated and not to be scaled.

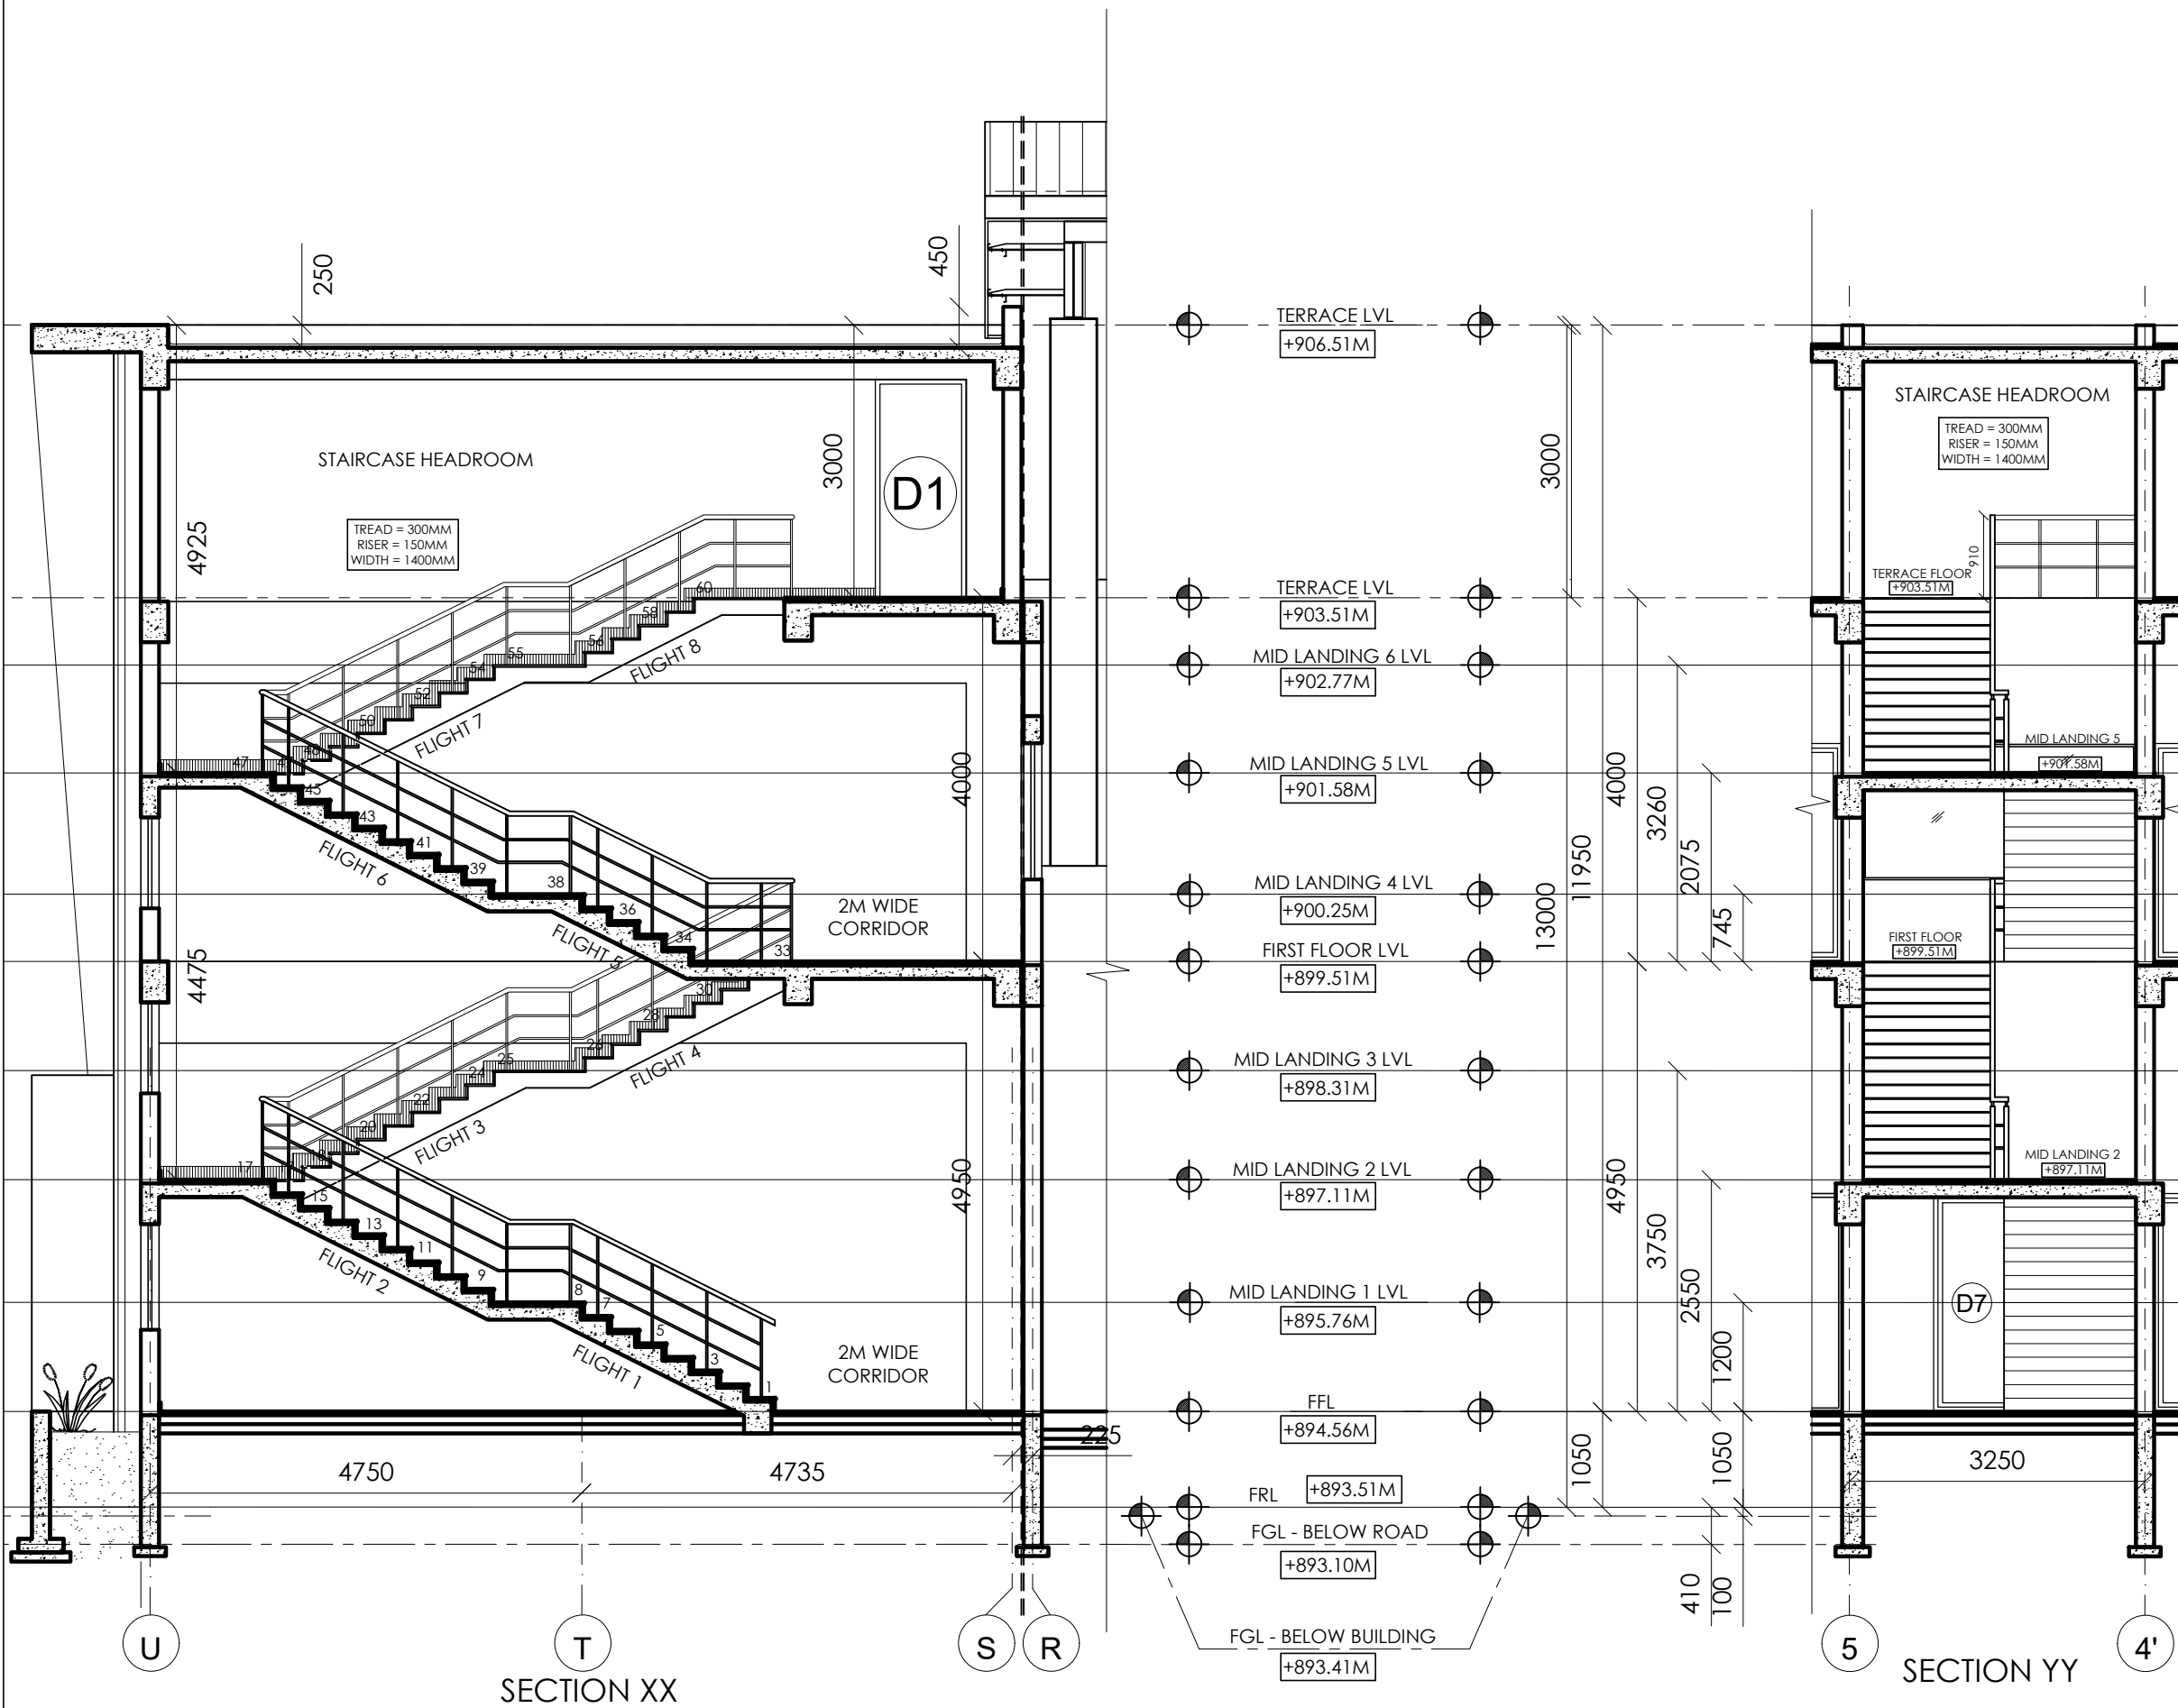

REV.	DATE	DESCRIPTION	DRAWN	CHKD.
------	------	-------------	-------	-------

REVISIONS				
AS BUILT				
CONSTRUCTION				
APPROVAL				
INFORMATION	*			
TENDER				
SCHEME				
ISSUED FOR				

INFORMATION

NAME OF THE PROJECT:
PROPOSED FACTORY FOR M/S TEMICO AT BENGALURU

CLIENT:
M/S TEMICO MOTOR INDIA PRIVATE LIMITED

DRAWING TITLE:
STAIRCASE DETAIL 2
SECTIONS
STRUCTURAL CONSULTANT:
ZACHARIA GEORGE F.I.E

SCALE: 1:75 @ A3	DESIGN BY: PDG	DRAWN BY: SHREYA	CHECKED BY: PDG
DATE: 11.08.2022	SIGN:	SIGN:	SIGN:

ARCHITECTURE * INTERIORS * PLANNING * ENGINEERING * MANAGEMENT

PITHAVADIAN AND PARTNERS
Chennai • Bengaluru • Kochi • Hyderabad


10, MURUGAPPA ROAD, NAWAB GARDENS,
KOTURPURAM, CHENNAI - 600 085

Phone : +91 (0) 44 2447 0033 / 44 166
Fax : +91 (0) 44 2447 0888 / 4213 2797
email : mail@paparchitect.com
website : www.paparchitect.com




DWG NO: 02-05B


(SHT 02 OF 02) REV NO: 0

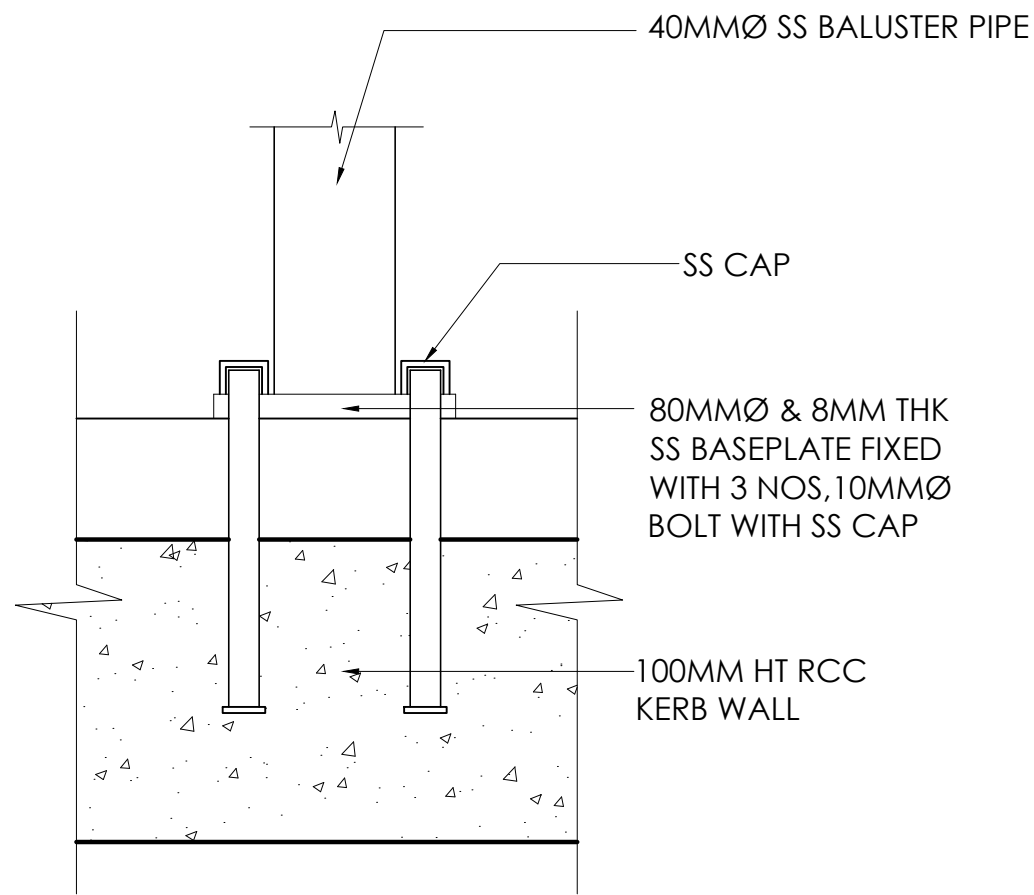


DETAIL OF FIXING BALUSTERS

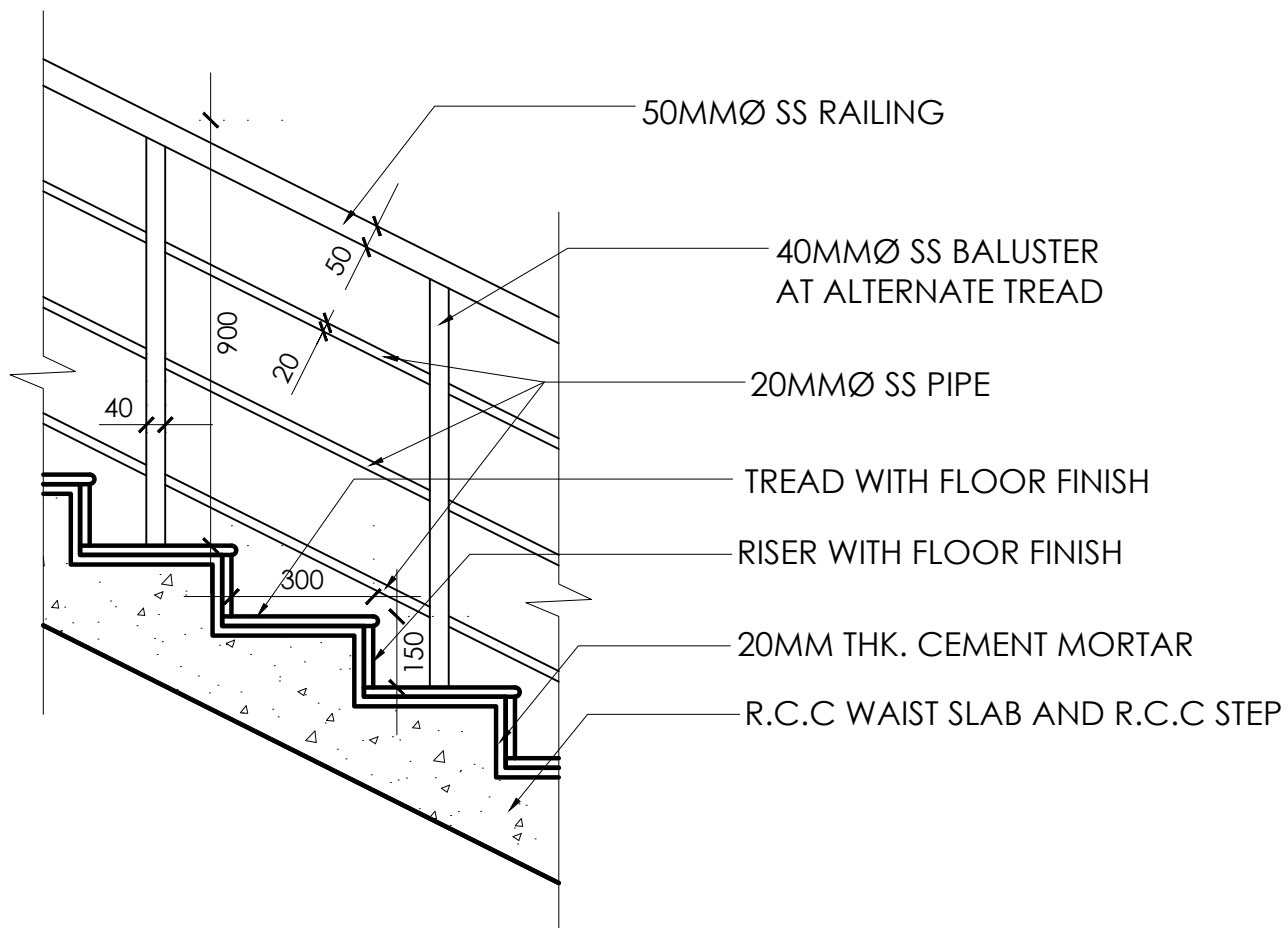


DETAIL OF RAILING
SCALE-1:20

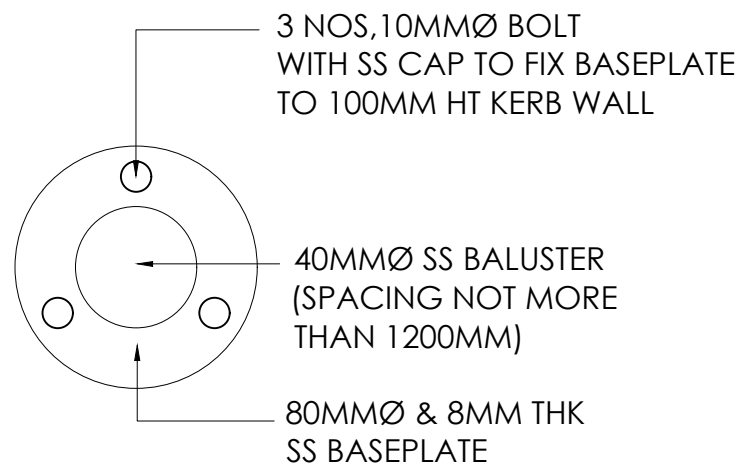

DETAIL OF BASE PLATE

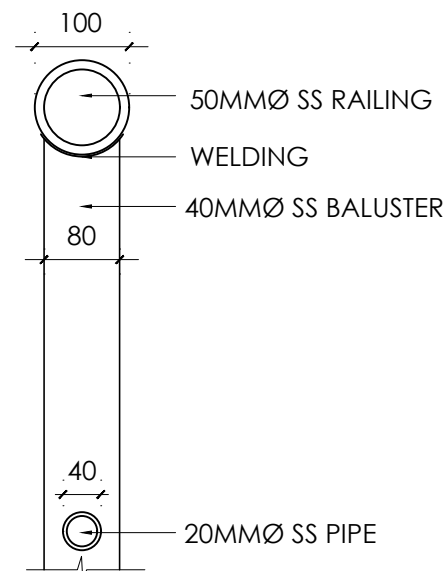

DETAIL OF SS HANDRAIL

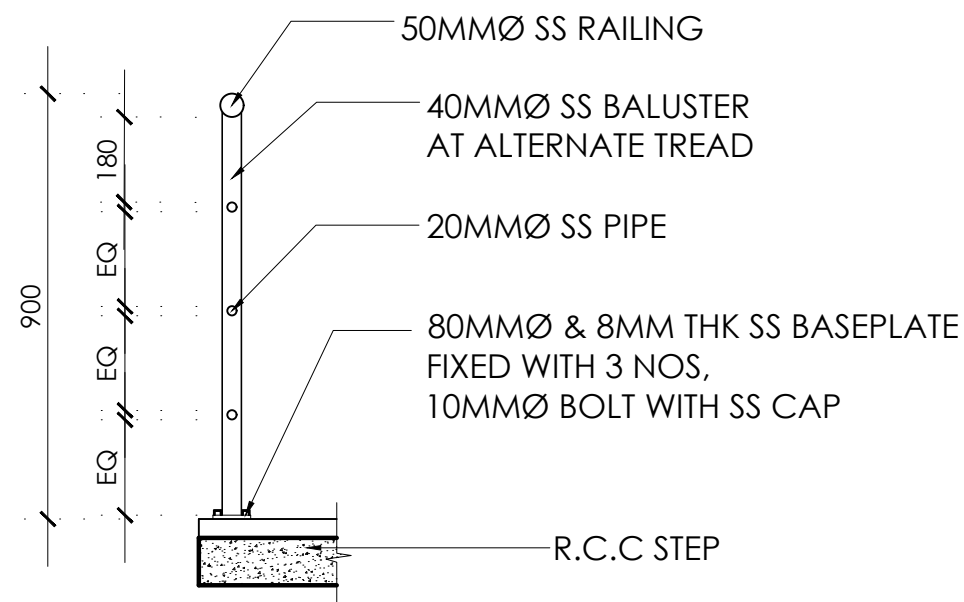


DETAIL OF FIXING BALUSTER ON RAMP
SCALE-1:20


NOTES

1. This drawing is sole property of 'Pithavadian And Partners' and must not be reproduced or altered either in full or in part by anyone without consent from us or be passed to any individual or company not authorized by us.
2. Any discrepancy in the drawing should be brought to the immediate attention of the Architect.
3. All dimensions in millimeters and levels in meters.
4. Dimensions to be followed as indicated and not to be scaled.


REV.	DATE	DESCRIPTION	DRAWN	CHKD.
R E V I S I O N S				
AS BUILT		INFORMATION		
CONSTRUCTION				
APPROVAL				
INFORMATION	*			
TENDER				
SCHEME				
ISSUED FOR				
NAME OF THE PROJECT:				
PROPOSED FACTORY FOR M/S TEMICO AT BENGALURU				
CLIENT:				
M/S TEMICO MOTOR INDIA PRIVATE LIMITED				
		DRAWING TITLE:		
		STAIRCASE DETAIL		
		RAILING DETAIL		
		STRUCTURAL CONSULTANT:		
		ZACHARIA GEORGE F.I.E		
SCALE: 1:5 @ A3	DESIGN BY: PDG	DRAWN BY: SHREYA	CHECKED BY: PDG	
DATE: 11.08.2022	SIGN:	SIGN:	SIGN:	
ARCHITECTURE * INTERIORS * PLANNING * ENGINEERING * MANAGEMENT				
PITHAVADIAN AND PARTNERS				
Chennai • Bengaluru • Kochi • Hyderabad				
10, MURUGAPPA ROAD, NAWAB GARDENS, KOTTURPURAM, CHENNAI - 600 085				
Phone : +91 (0) 44 2447 0033 / 44 / 66				
Fax : +91 (0) 44 2447 0888/4213 2797				
email : mail@paparchitect.com				
website : www.paparchitect.com				
DWG NO: 02-06		(SHT 01 OF 01)		REV NO: 0

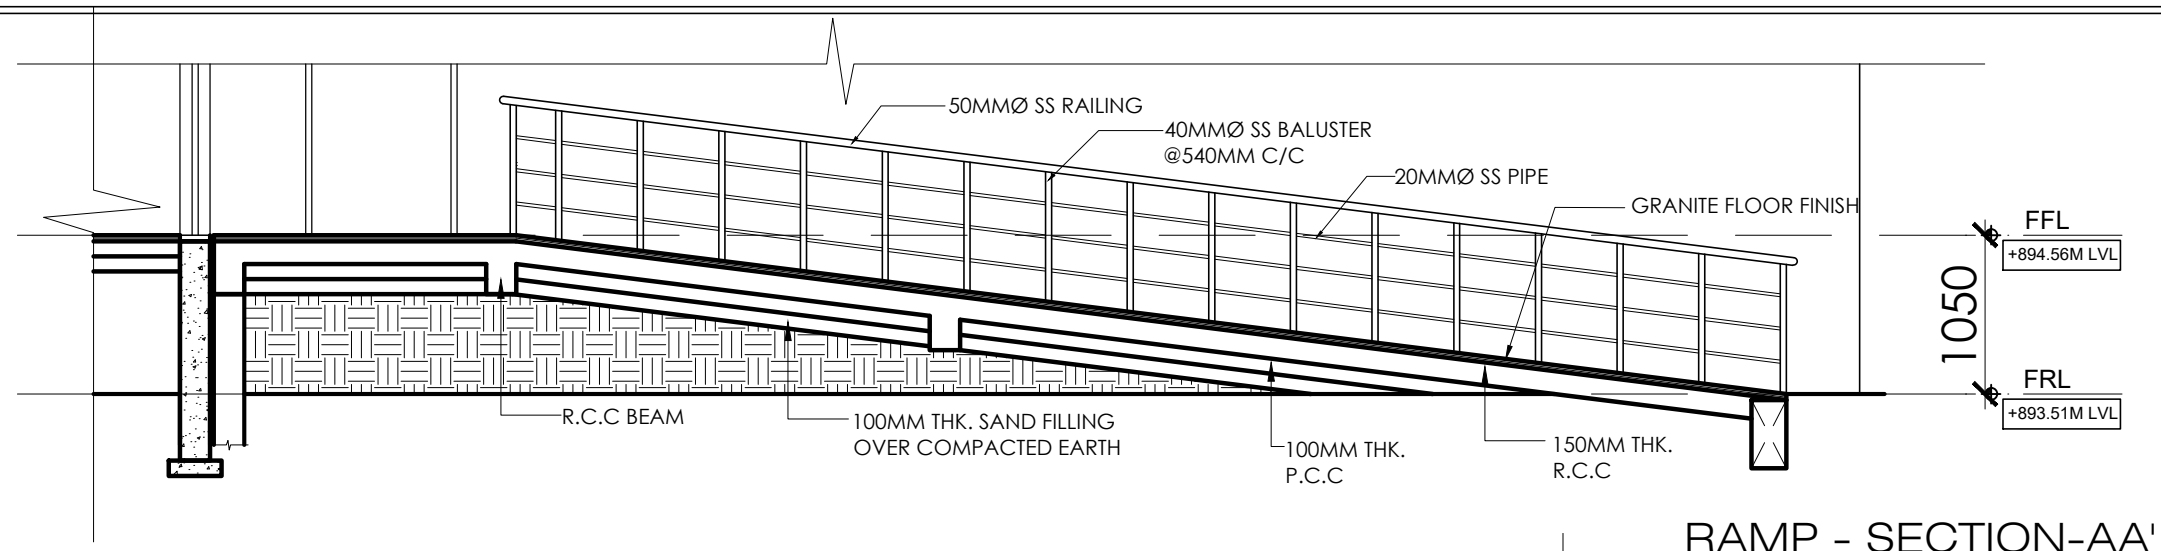

RAMP - SECTION-AA'

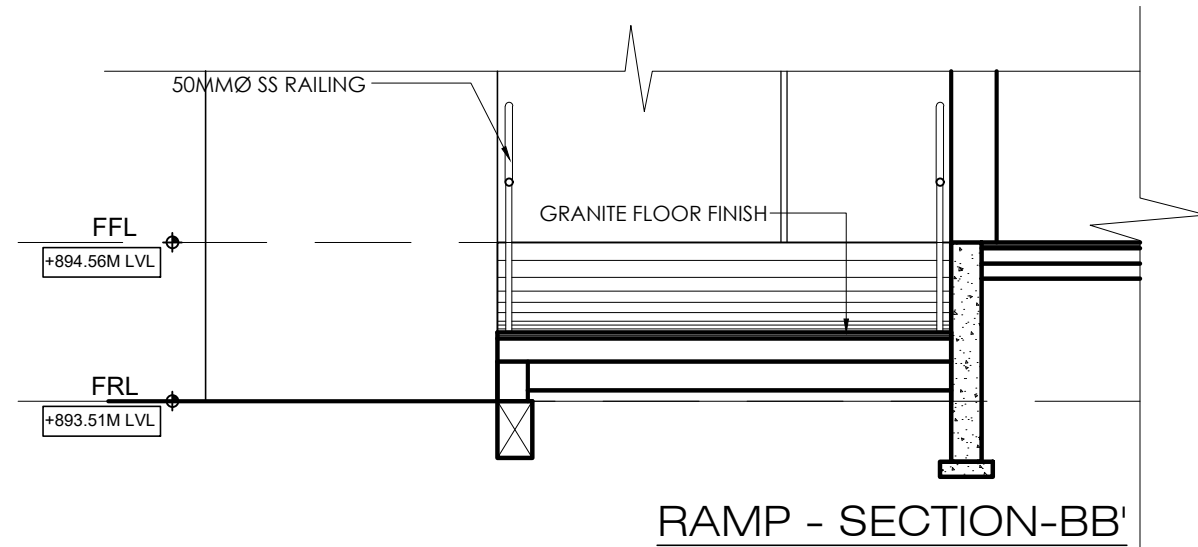


RAMP - SECTION-BB'

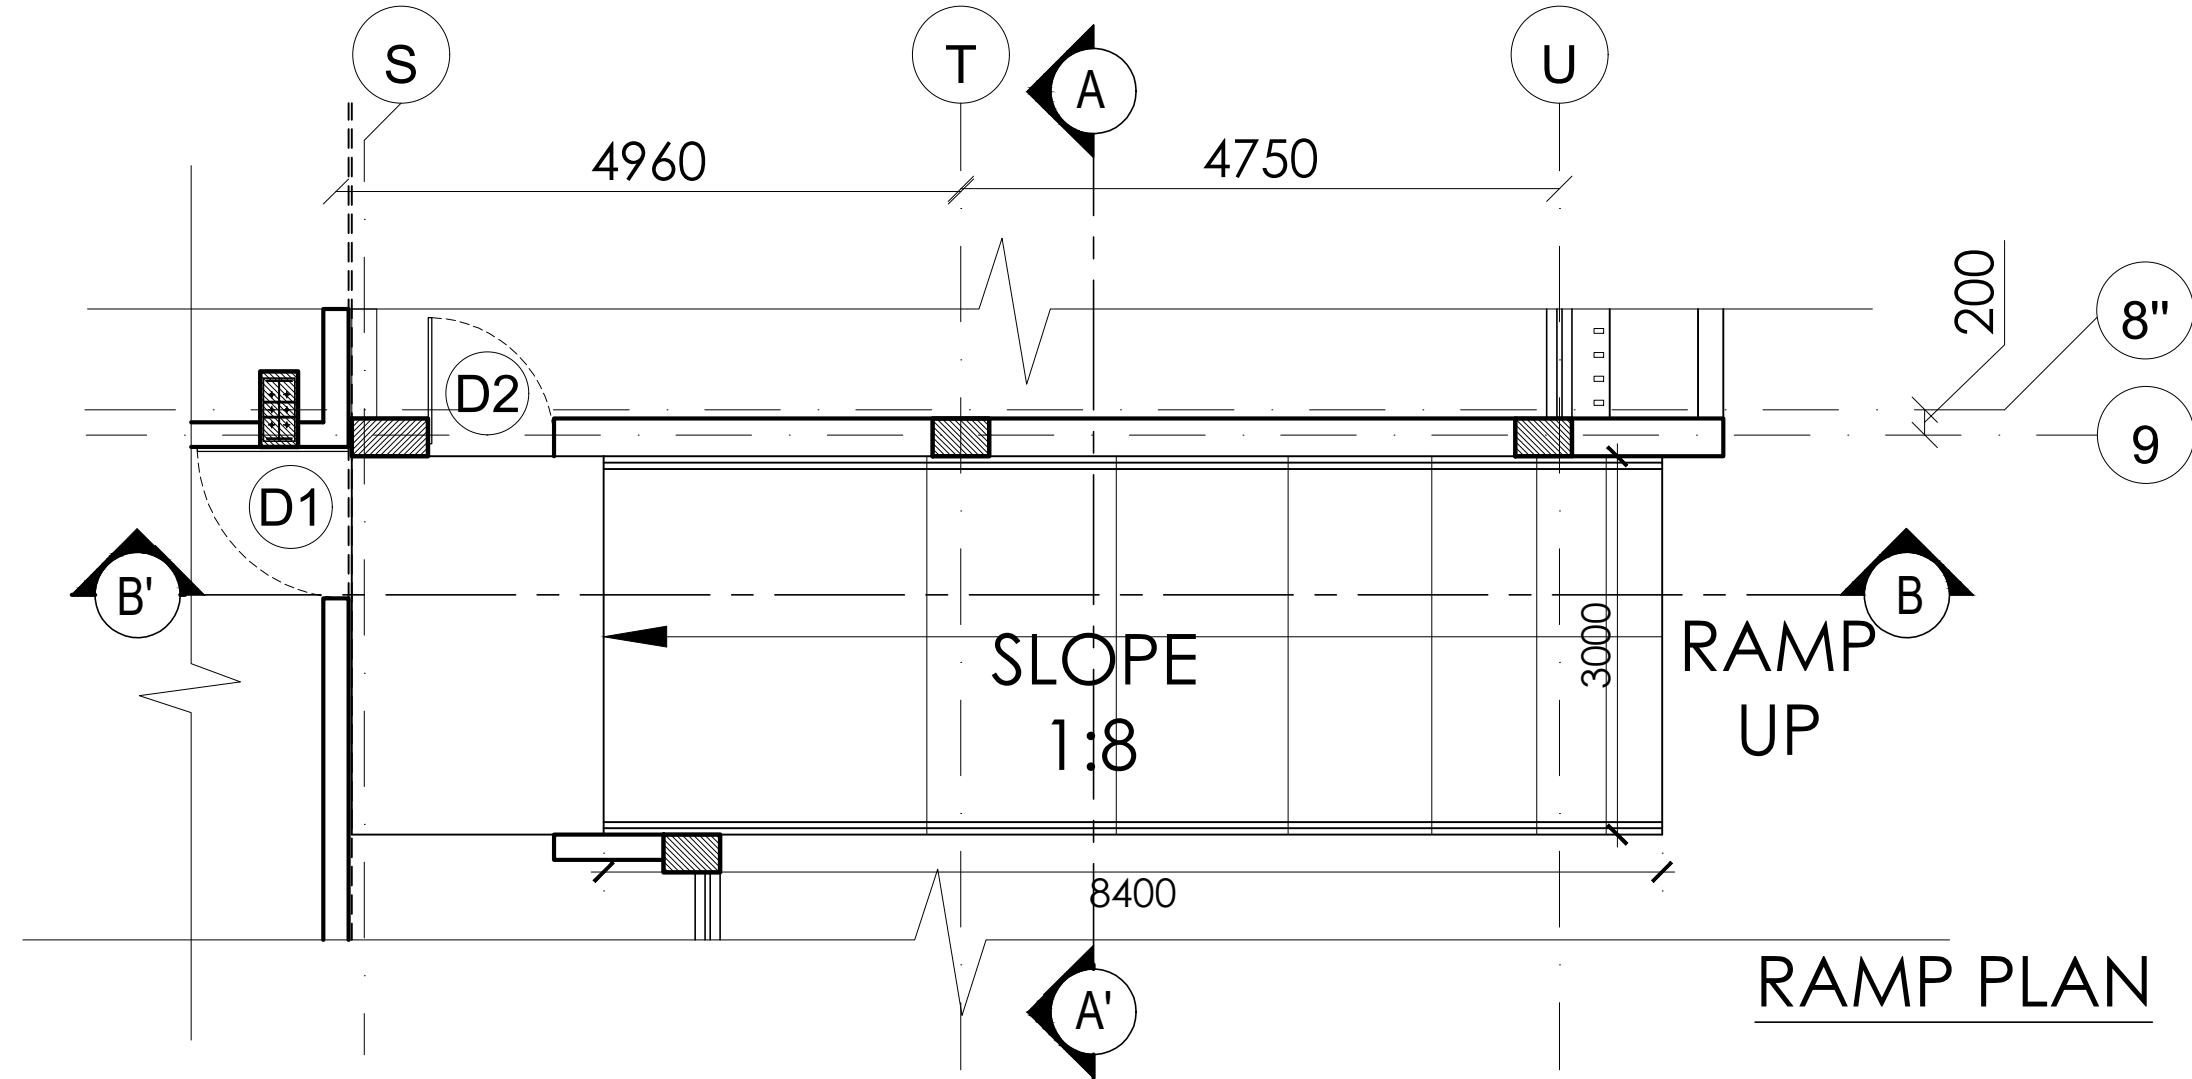


RAMP PLAN


NOTES
1. This drawing is sole property of 'Pithavadian and Partners' and must not be reproduced or altered either in full or in part by anyone without consent from us or be passed to any individual or company not authorized by us.
2. Any discrepancy in the drawing should be brought to the immediate attention of the Architect.
3. All dimensions in millimeters and levels in meters.
4. Dimensions to be followed as indicated and not to be scaled.

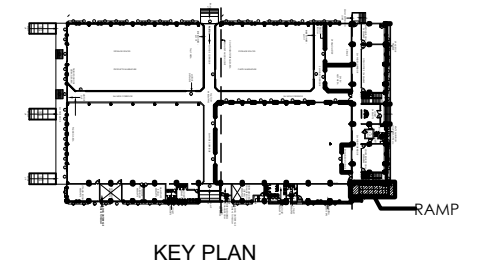


REV.	DATE	DESCRIPTION	DRAWN	CHKD.
REVISIONS				
AS BUILT		INFORMATION		
CONSTRUCTION				
APPROVAL				
INFORMATION	*			
TENDER				
SCHEME				
ISSUED FOR				
NAME OF THE PROJECT: PROPOSED FACTORY FOR M/S TEMICO AT BENGALURU				
CLIENT: M/S TEMICO MOTOR INDIA PRIVATE LIMITED				
	DRAWING TITLE: RAMP DETAIL PLAN AND SECTIONS			
	STRUCTURAL CONSULTANT: ZACHARIA GEORGE F.I.E			
SCALE: 1:50 @ A3	DESIGN BY: PDG	DRAWN BY: SHREYA	CHECKED BY: PDG	
DATE: 19.10.2022	SIGN:	SIGN:	SIGN:	
ARCHITECTURE * INTERIORS * PLANNING * ENGINEERING * MANAGEMENT				
PITHAVADIAN AND PARTNERS Chennai ▪ Bengaluru ▪ Kochi ▪ Hyderabad 10, MURUGAPPA ROAD, NAWAB GARDENS, KOTTURPURAM, CHENNAI - 600 085 Phone : +91 (0) 44 2447 0033 /44 /66 Fax : +91 (0) 44 2447 0888/4213 2797 email : mail@paparchitect.com website : www.paparchitect.com				
DWG NO: 02-07A		(SHT 01 OF 02)	REV NO: 0	

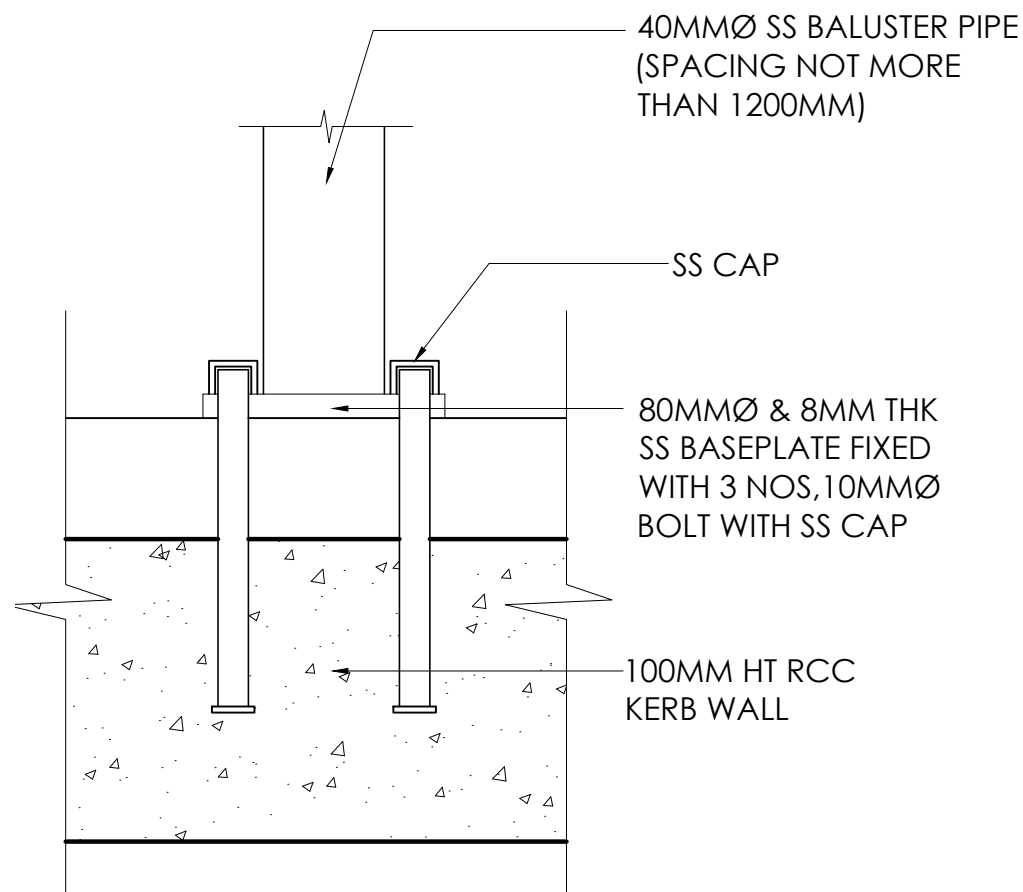


DETAIL OF FIXING BALUSTERS

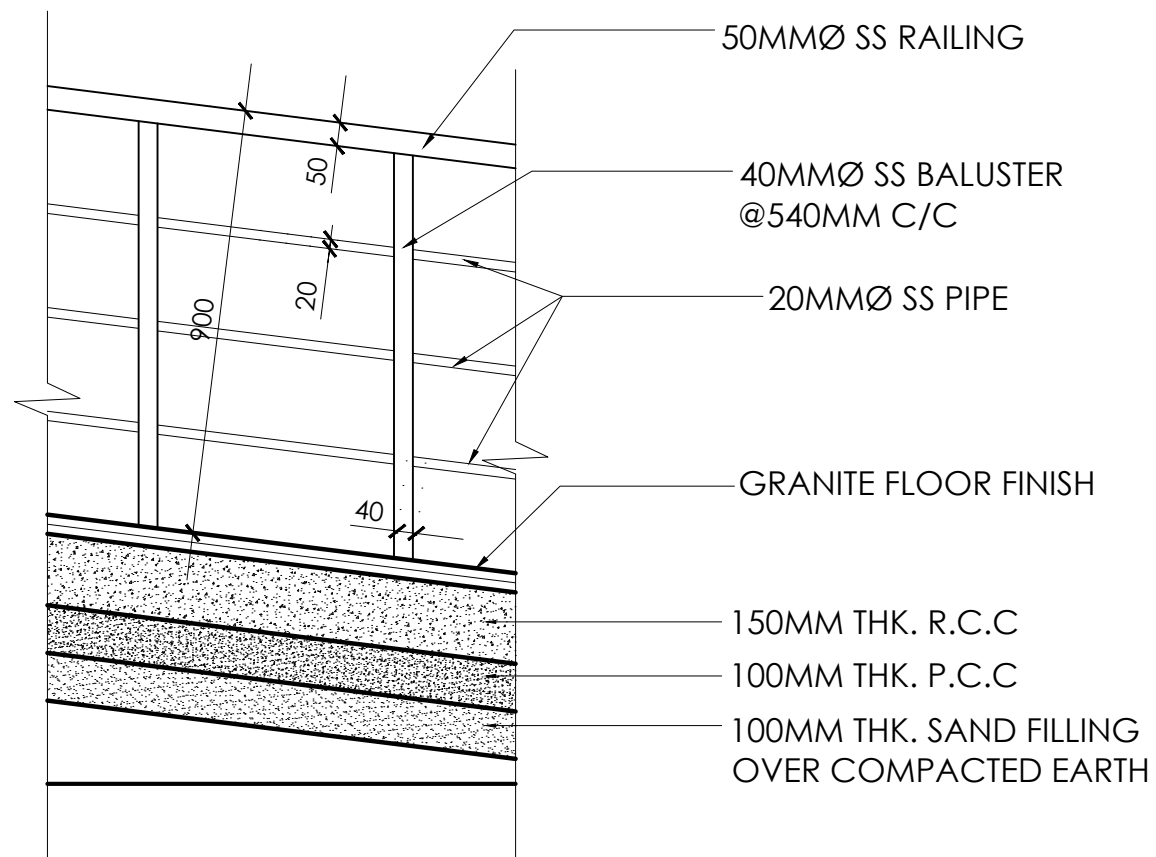


DETAIL OF RAILING
SCALE-1:20

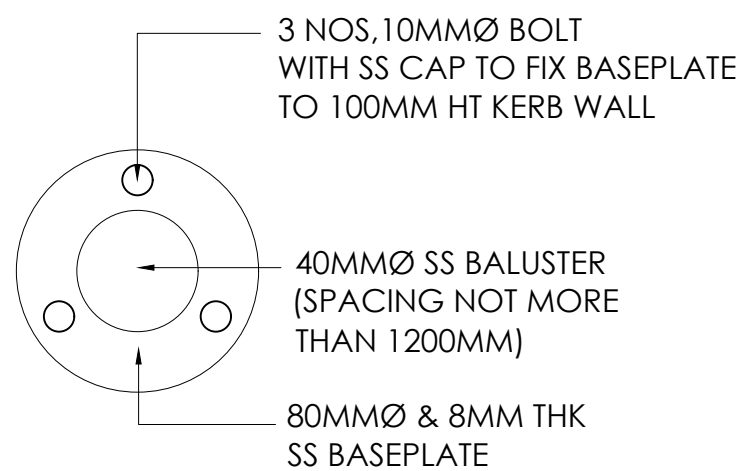

DETAIL OF BASE PLATE

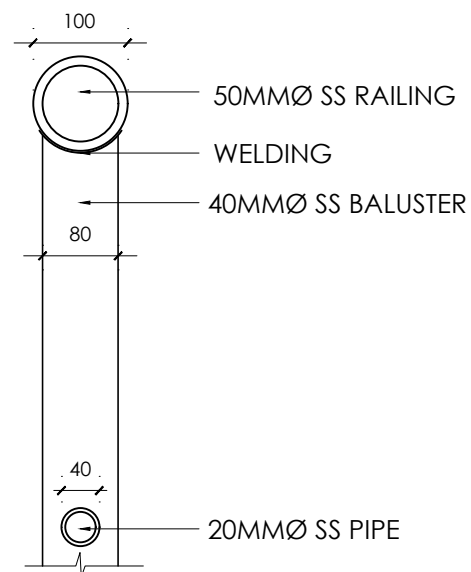

DETAIL OF SS HANDRAIL

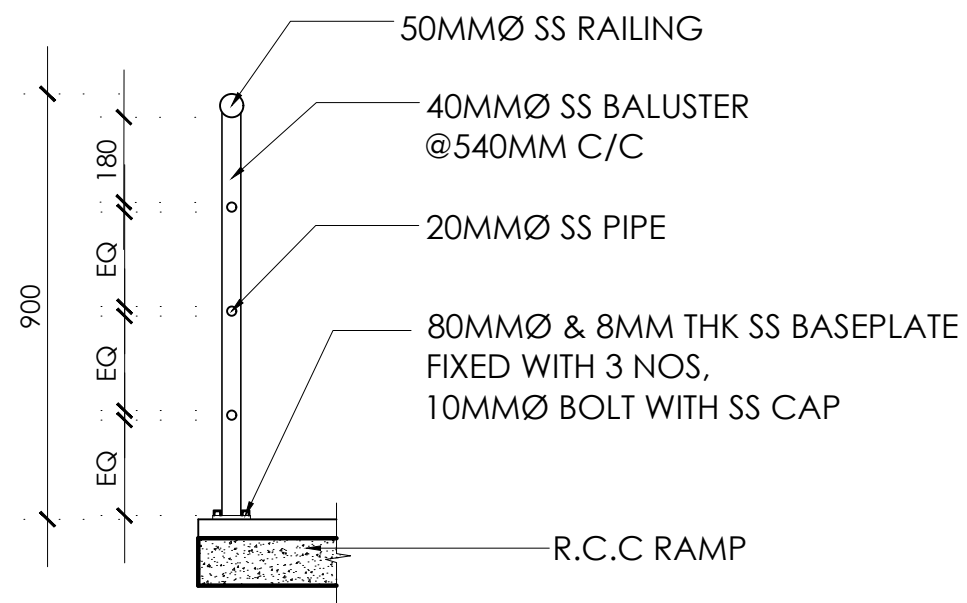

DETAIL OF FIXING BALUSTER ON RAMP
SCALE-1:20




NOTES






1. This drawing is sole property of 'Pithavadian and Partners' and must not be reproduced or altered either in full or in part by anyone without consent from us or be passed to any individual or company not authorized by us.
2. Any discrepancy in the drawing should be brought to the immediate attention of the Architect.
3. All dimensions in millimeters and levels in meters.
4. Dimensions to be followed as indicated and not to be scaled.

REV.	DATE	DESCRIPTION	DRAWN	CHKD.
REVISIONS				
AS BUILT		INFORMATION		
CONSTRUCTION				
APPROVAL				
INFORMATION	*			
TENDER				
SCHEME				
ISSUED FOR				
NAME OF THE PROJECT:				
PROPOSED FACTORY FOR M/S TEMICO AT BENGALURU				
CLIENT:				
M/S TEMICO MOTOR INDIA PRIVATE LIMITED				
		DRAWING TITLE:		
		RAMP DETAIL		
		RAILING DETAIL		
		STRUCTURAL CONSULTANT:		
		ZACHARIA GEORGE F.I.E		
SCALE:	DESIGN BY:	DRAWN BY:	CHECKED BY:	
1:5 @ A3	PDG	SHREYA	PDG	
DATE:	SIGN:	SIGN:	SIGN:	
19.10.2022				
ARCHITECTURE * INTERIORS * PLANNING * ENGINEERING * MANAGEMENT				
PITHAVADIAN AND PARTNERS				
Chennai • Bengaluru • Kochi • Hyderabad				
10, MURUGAPPA ROAD, NAWAB GARDENS, KOTTURPURAM, CHENNAI - 600 085				
Phone : +91 (0) 44 2447 0033 /44 /66				
Fax : +91 (0) 44 2447 0888/4213 2797				
email : mail@paparchitect.com				
website : www.paparchitect.com				
DWG NO: 02-07B		(SHT 02 OF 02)		REV NO: 0




TIDEL PARK TIRUPPUR

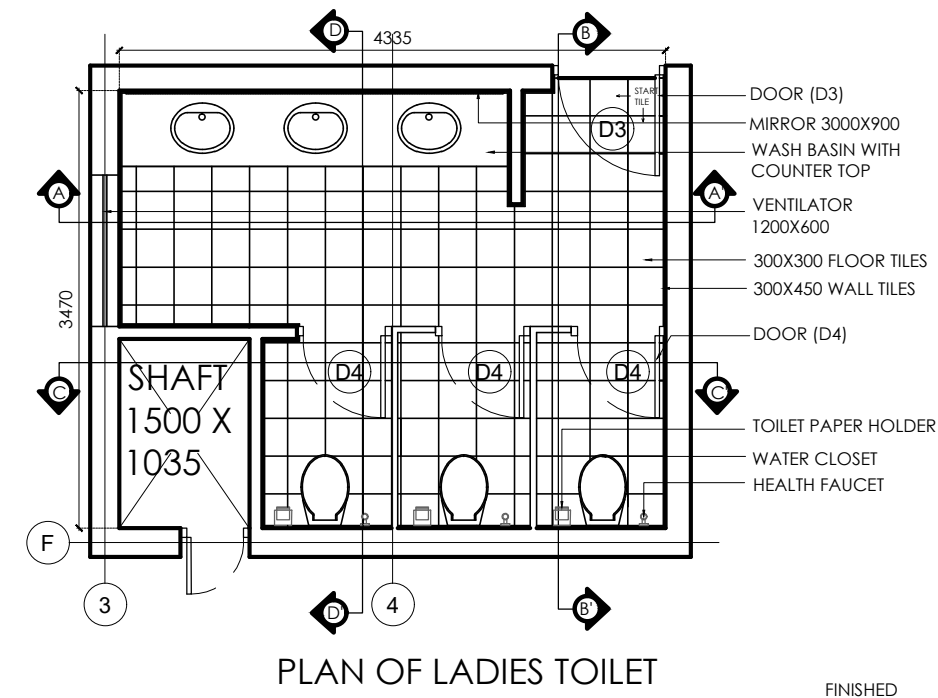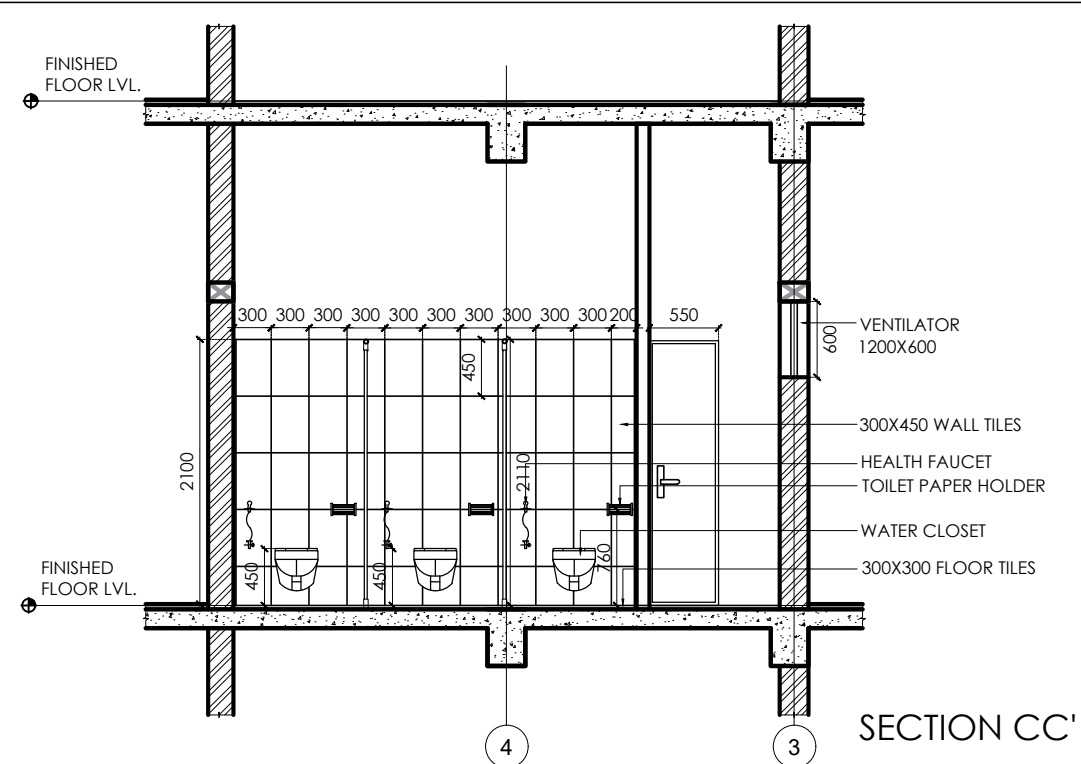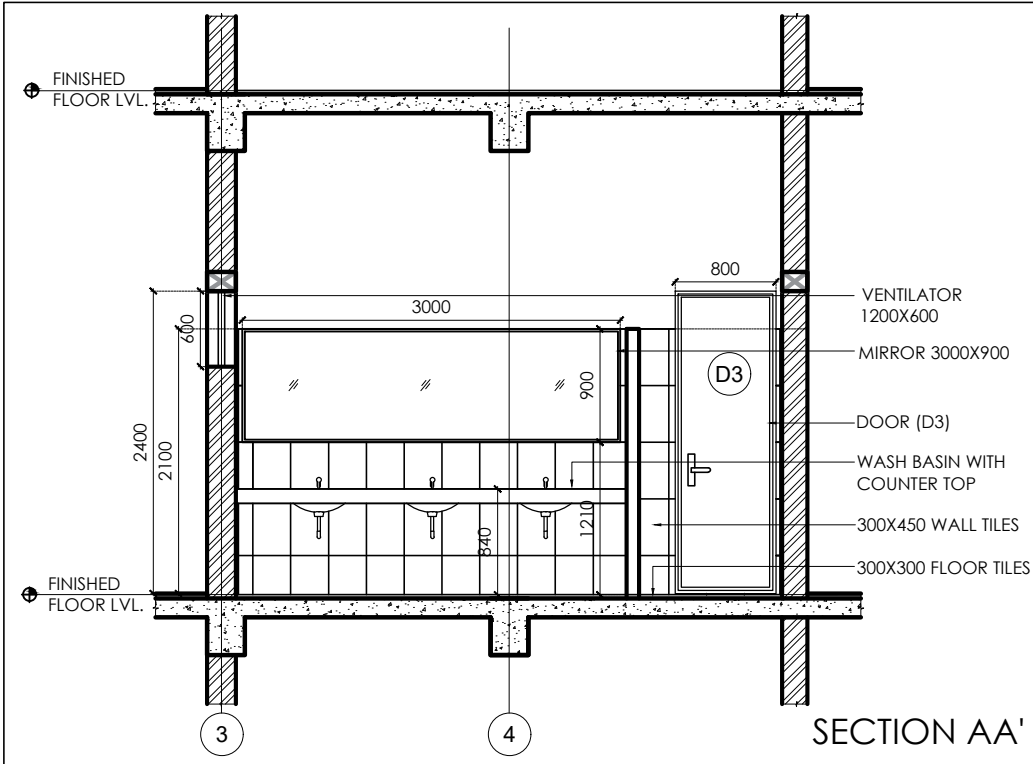

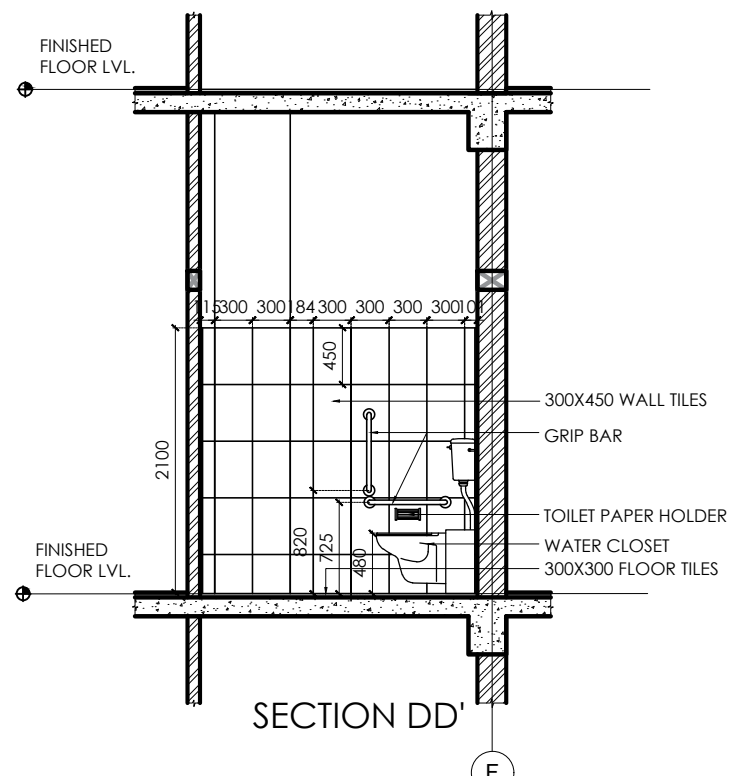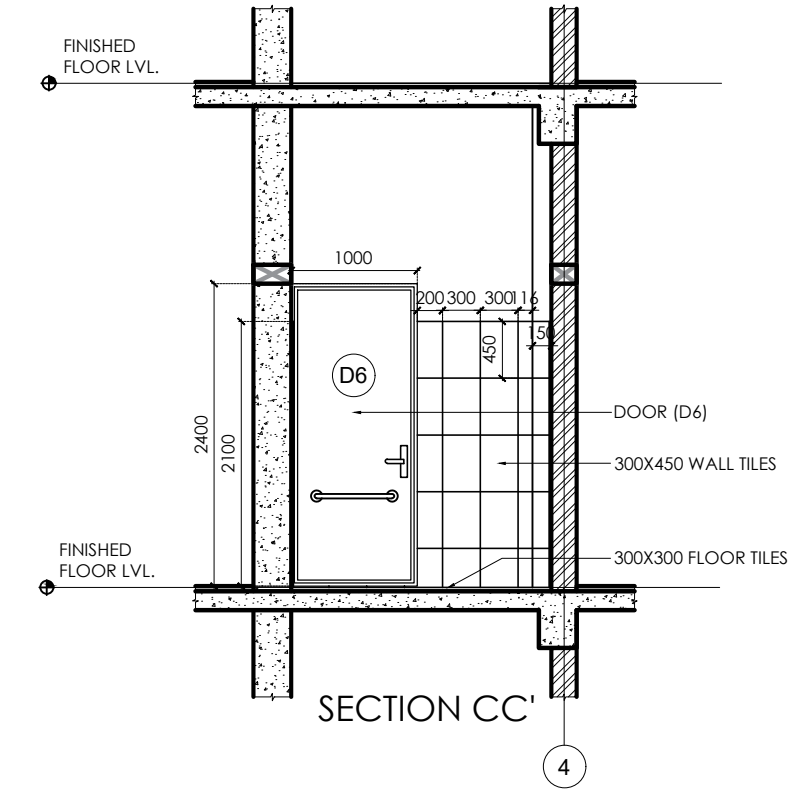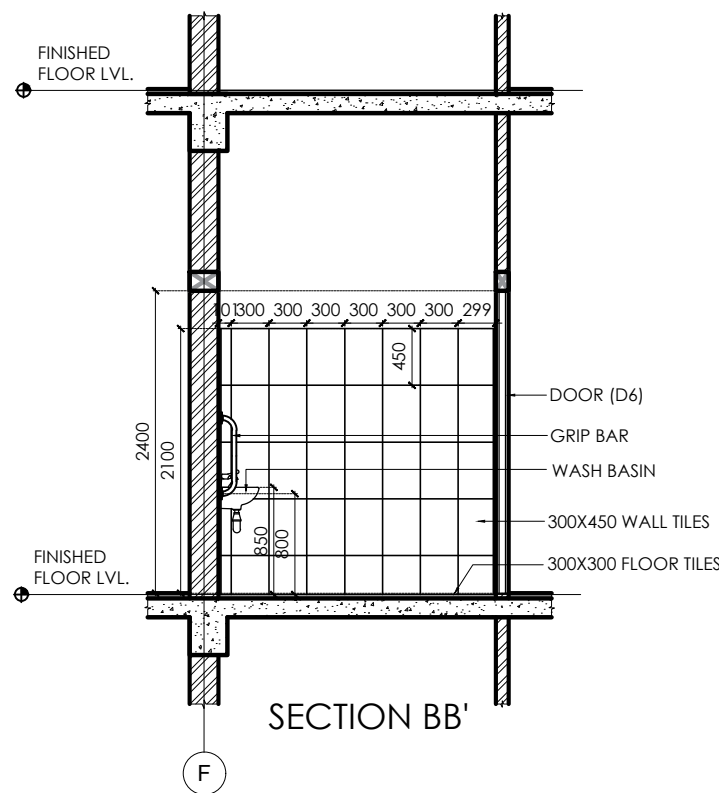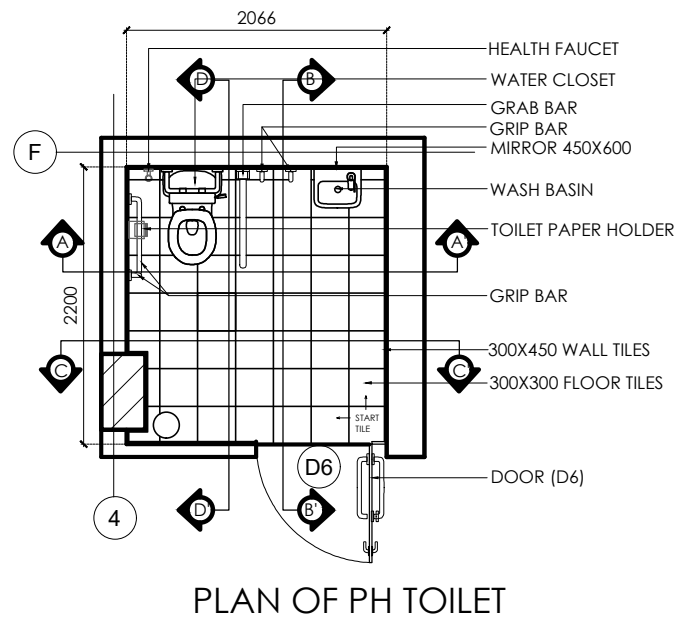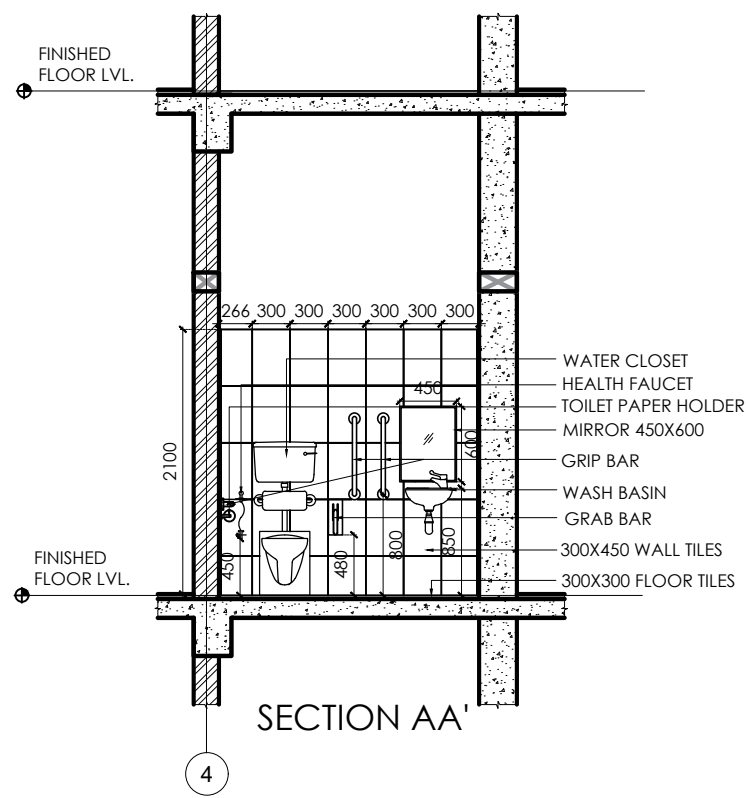


NOTES

1. This drawing is sole property of 'Pithavadian and Partners' and must not be reproduced or altered either in full or in part by anyone without consent from us or be passed to any individual or company not authorized by us.
2. Any discrepancy in the drawing should be brought to the immediate attention of the Architect.
3. All dimensions in millimeters and levels in meters.
4. Dimensions to be followed as indicated and not to be scaled.





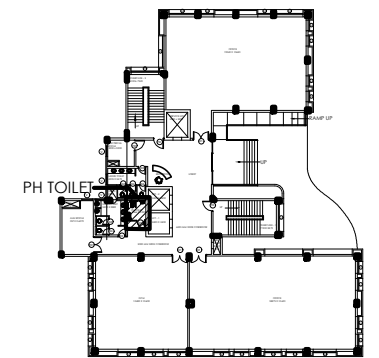


KEY PLAN

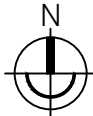REV.	DATE	DESCRIPTION		DRAWN	CHKD.
REVISIONS					
AS BUILT		APPROVAL			
CONSTRUCTION					
APPROVAL *					
INFORMATION					
TENDER					
SCHEME					
ISSUED FOR					
NAME OF THE PROJECT: PROPOSED IT OFFICE FOR TIDEL PARK AT TIRUPPUR					
CLIENT: TIDEL PARK 4, RAJIV GANDHI SALAI, TARAMANI					
		DRAWING TITLE: TOILET DETAIL GENTS TOILET			
		STRUCTURAL CONSULTANT:			
		ZACHARIA GEORGE F.I.E			
SCALE: 1:50 @ A3		DESIGN BY: PDG		DRAWN BY: SHREYA	
DATE: 26.07.2022		SIGN:		SIGN:	
				CHECKED BY: PDG	
				SIGN:	
ARCHITECTURE * INTERIORS * PLANNING * ENGINEERING * MANAGEMENT					
PITHAVADIAN AND PARTNERS					
Chennai • Bengaluru • Kochi • Hyderabad					
10, MURUGAPPA ROAD, NAWAB GARDENS, KOTTURPURAM, CHENNAI - 600 085					
Phone : +91 (0) 44 2447 0033 / 44 / 66					
Fax : +91 (0) 44 2447 0888/4213 2797					
email : mail@paparchitect.com					
website : www.paparchitect.com					
					
DWG NO: 03-01C (SHT 03 OF 03) REV NO: 0					



TIDEL PARK VILLUPURAM

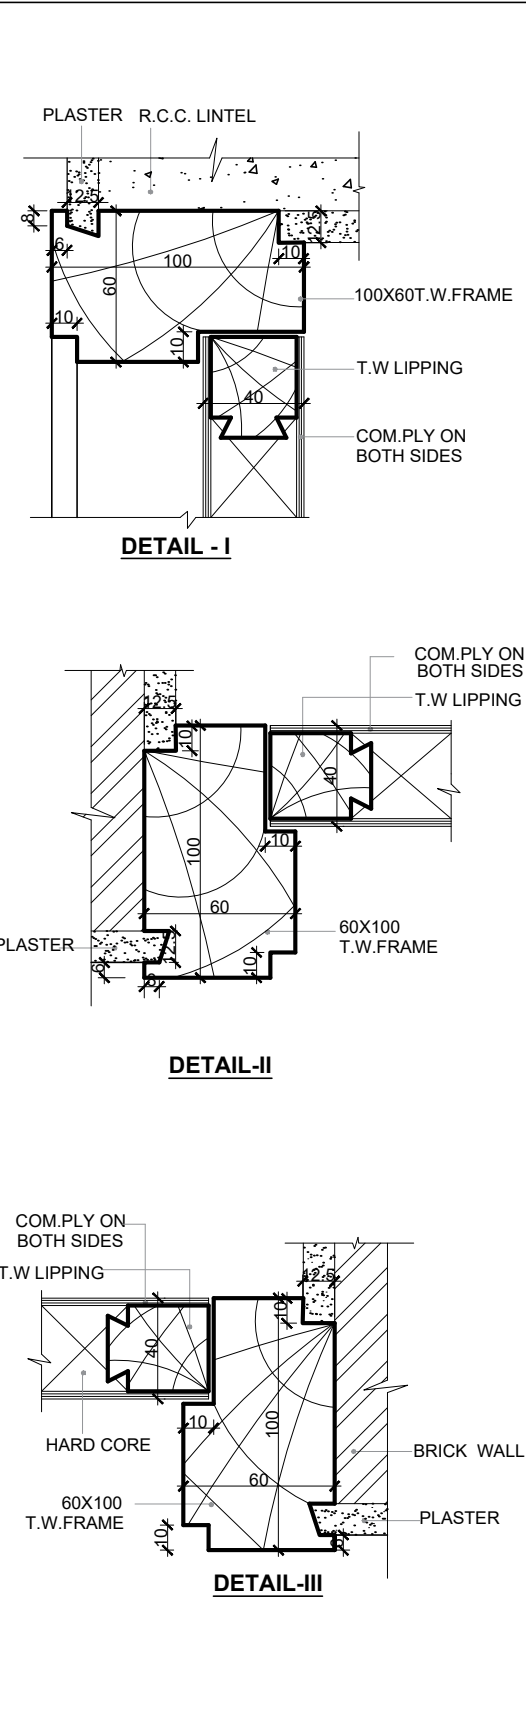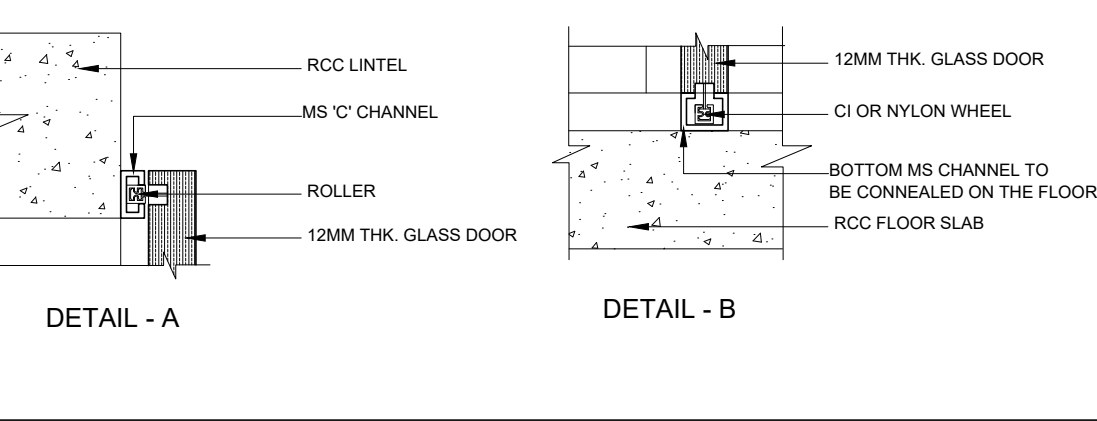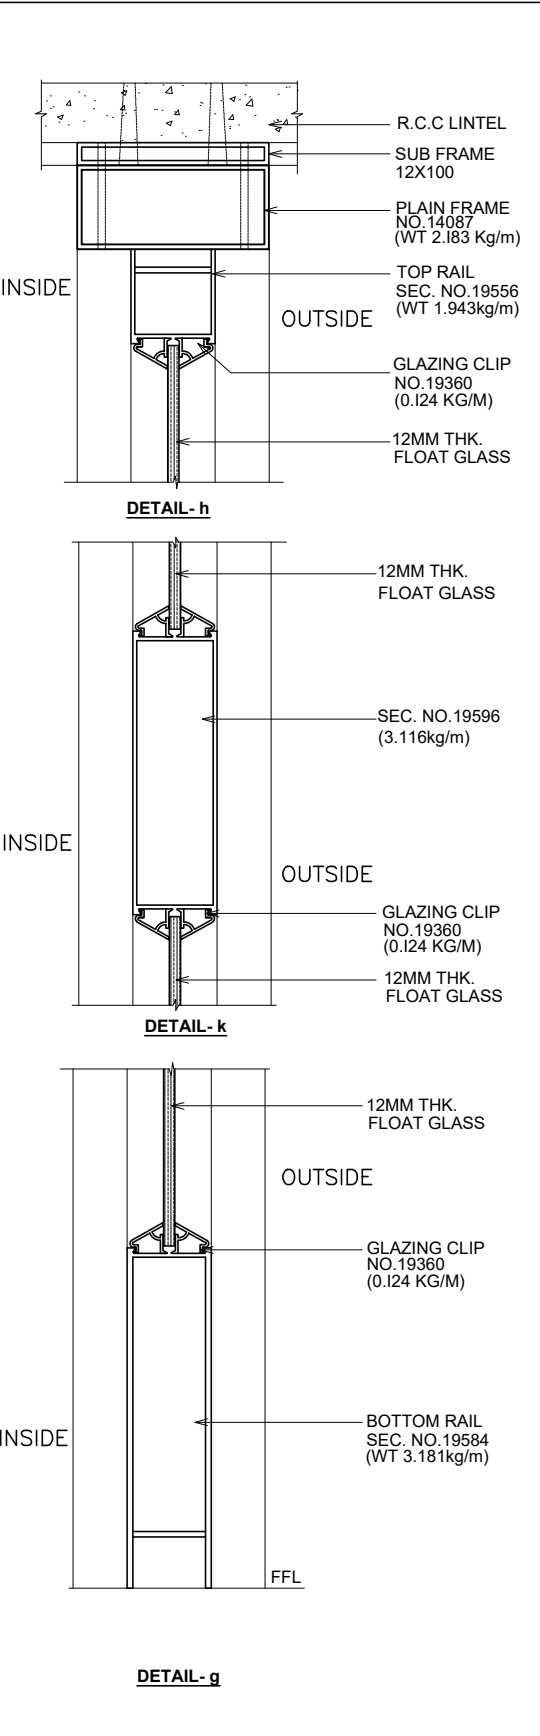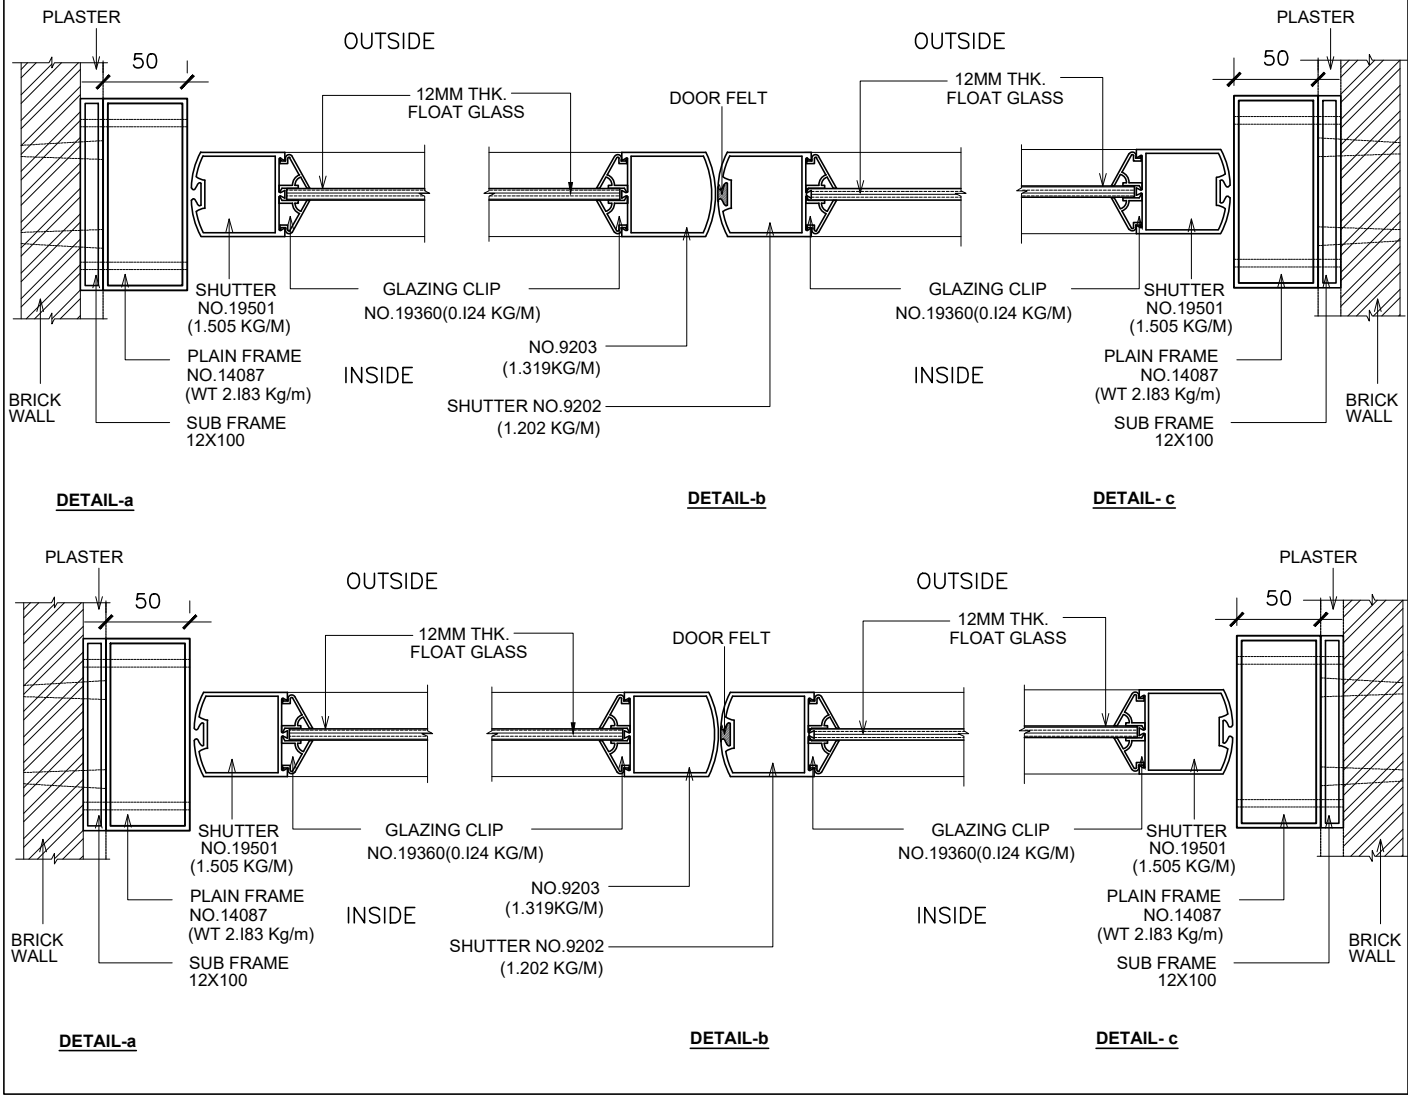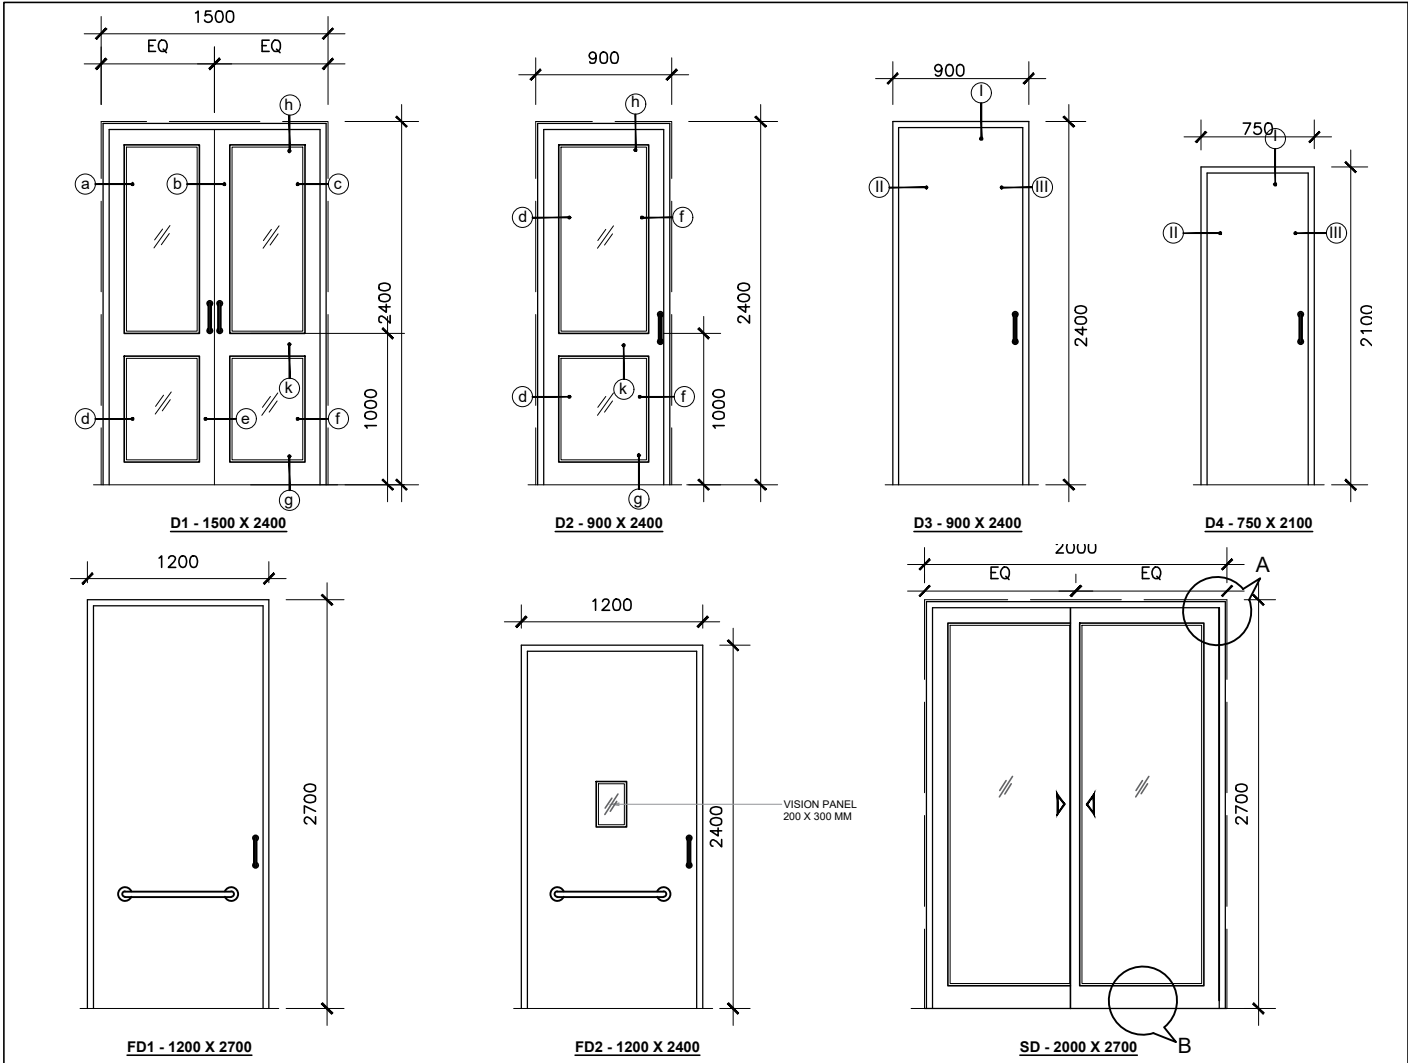

NOTES

1. This drawing is sole property of 'Pithavadian and Partners' and must not be reproduced or altered either in full or in part by anyone without consent from us or be passed to any individual or company not authorised by us.

2. Any discrepancy in the drawing should be brought to the immediate attention of the Architect.

3. All dimensions in millimeters and levels in meters.

4. Dimensions to be followed as indicated and not to be scaled.

REV.	DATE	DESCRIPTION	DRAWN	CHKD.
1	04.07.2022	AS BUILT		
2		CONSTRUCTION		
3		APPROVAL		
4		INFORMATION		
5		TENDER		
6		SCHEME		
7		ISSUED FOR		

NAME OF THE PROJECT:

PROPOSED CONSTRUCTION OF IT BUILDING AT THIRUCHITRAMBALAM , VANUR TALUK , VILLUPURAM

CLIENT:

TIDEL PARK
4, RAJIV GANDHI SALAI, TARAMANI

DRAWING TITLE:

DOOR JOINERY DETAIL

STRUCTURAL CONSULTANT:

ZACHARIA GEORGE F.I.E

SCALE:	DESIGN BY:	DRAWN BY:	CHECKED BY:
1:50 @ A3	PDG	SHREYA	PDG
DATE:	SIGN:	SIGN:	SIGN:
04.07.2022			

ARCHITECTURE * INTERIORS * PLANNING * ENGINEERING * MANAGEMENT

PITHAVADIAN AND PARTNERS

Chennai • Bengaluru • Kochi • Hyderabad

10, MURUGAPPA ROAD, NAWAB GARDENS, KOTURPURAM, CHENNAI - 600 085

Phone : +91 (0) 44 2447 0033 / 44 / 66

Fax : +91 (0) 44 2447 0888/4213 2797


email : mail@paparchitect.com

website : www.paparchitect.com


DWG NO: 04-01A (SHT 01 OF 02) REV NO: 0

NOTES


1. This drawing is sole property of 'Pithavadian And Partners' and must not be reproduced or altered either in full or in part by anyone without consent from us or be passed to any individual or company not authorised by us.
2. Any discrepancy in the drawing should be brought to the immediate attention of the Architect.
3. All dimensions in millimeters and levels in meters.
4. Dimensions to be followed as indicated and not to be scaled.

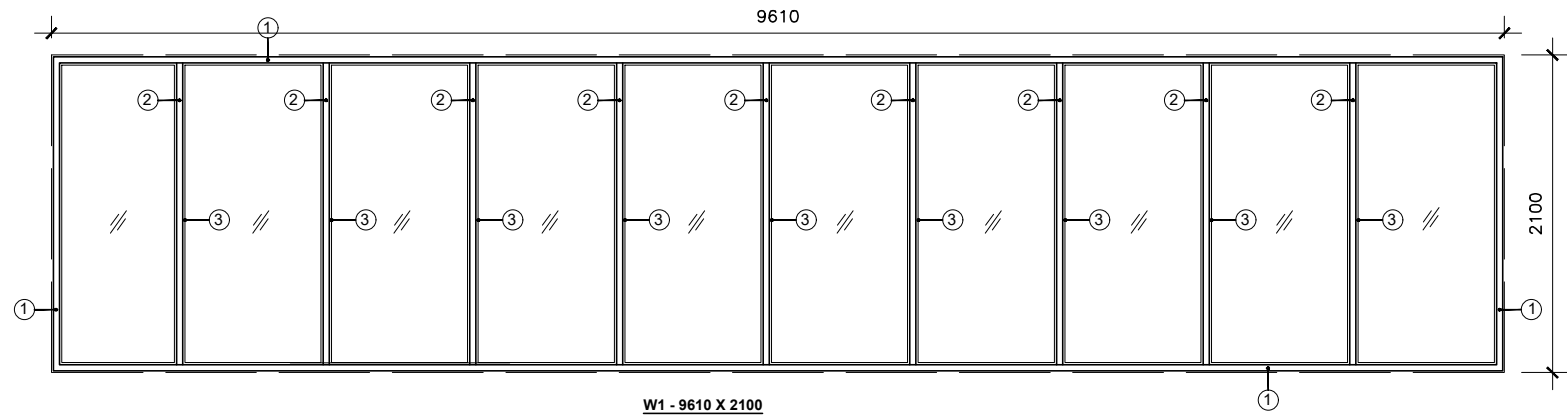


W1 - 9610 X 2100

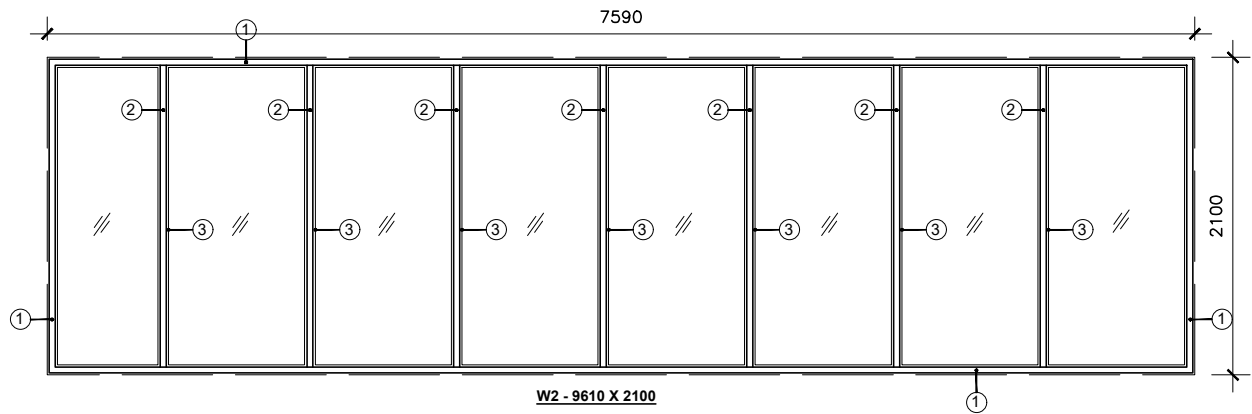


W2 - 9610 X 2100

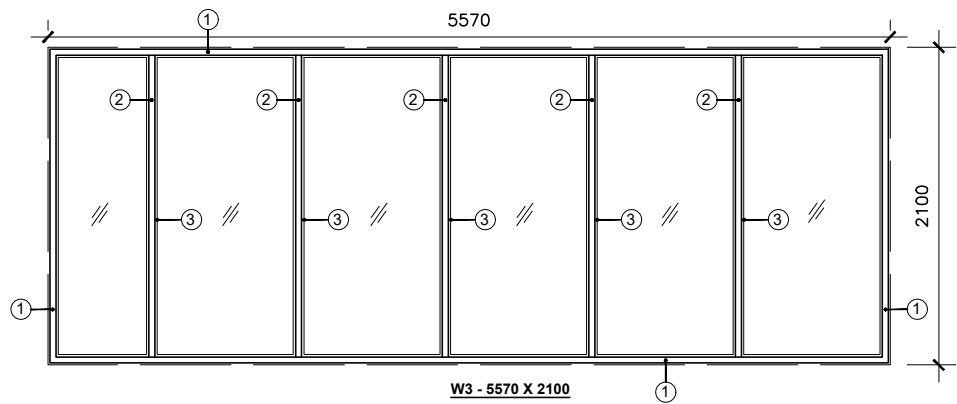


W3 - 5570 X 2100

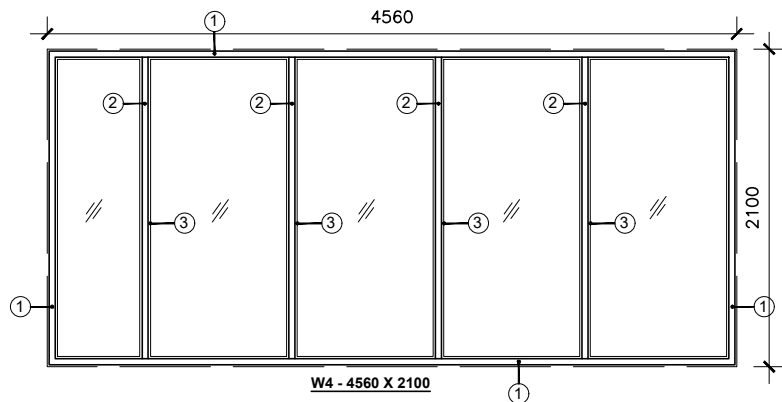


W4 - 4560 X 2100

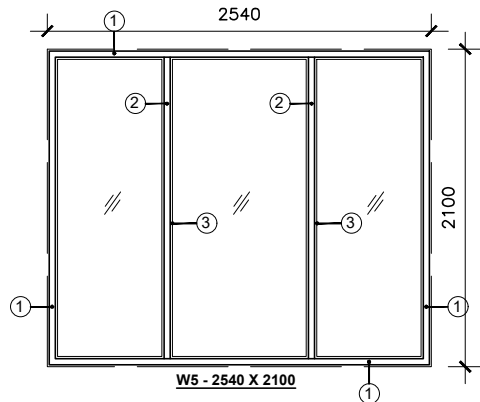


W5 - 2540 X 2100

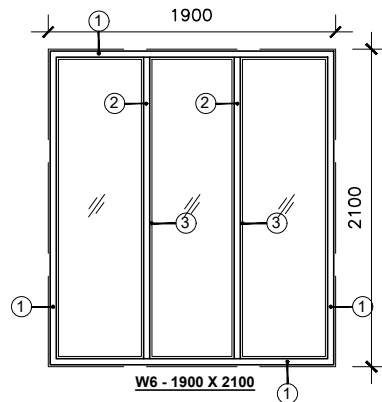


W6 - 1900 X 2100

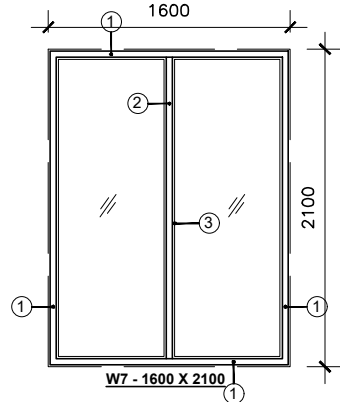

W7 - 1600 X 2100

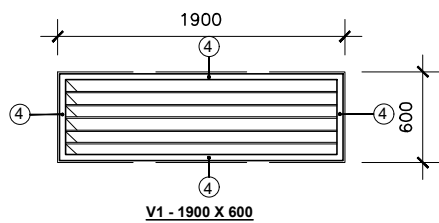

V1 - 1900 X 600

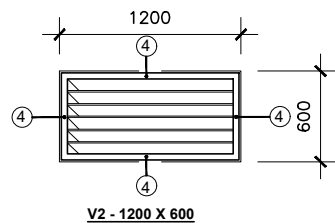

V2 - 1200 X 600

S.NO.	DESCRIPTION	JINDAL SEC. NO.	WT/KG
FIXED GLAZING			
7	OUTER FRAME FOR FIXED GLAZING	20047	0.942
8	MULLION	20048	0.942
9	CLIP	19360	0.124
VENTILATOR			
10	OUTER FRAME & MULLION FOR LOUVERED VENTILATOR	14070	0.781

REV.	DATE	DESCRIPTION	DRAWN	CHKD.
------	------	-------------	-------	-------

REVISIONS

AS BUILT	
CONSTRUCTION	
APPROVAL	*
INFORMATION	
TENDER	
SCHEME	
ISSUED FOR	


APPROVAL

NAME OF THE PROJECT:

PROPOSED CONSTRUCTION OF IT BUILDING
AT THIRUCHITRAMBALAM ,
VANUR TALUK , VILLUPURAM

CLIENT:

TIDEL PARK
4, RAJIV GANDHI SALAI, TARAMANI

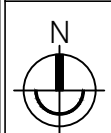

DRAWING TITLE:
WINDOW JOINERY DETAIL

STRUCTURAL CONSULTANT:

ZACHARIA GEORGE F.I.E

SCALE:
1:50 @ A3
DATE:
04.07.2022

DESIGN BY:
PDG
SIGN:

DRAWN BY:
SHREYA
SIGN:

CHECKED BY:
PDG
SIGN:

ARCHITECTURE * INTERIORS * PLANNING * ENGINEERING * MANAGEMENT

PITHAVADIAN AND PARTNERS

Chennai • Bengaluru • Kochi • Hyderabad


10, MURUGAPPA ROAD, NAWAB GARDENS,
KOTTURPURAM, CHENNAI - 600 085

Phone : +91 (0) 44 2447 0033 / 44 166
Fax : +91 (0) 44 2447 0888/4213 2797
email : mail@paparchitect.com
website : www.paparchitect.com




DWG NO: 04-01B


(SHT 02 OF 02) REV NO: 0

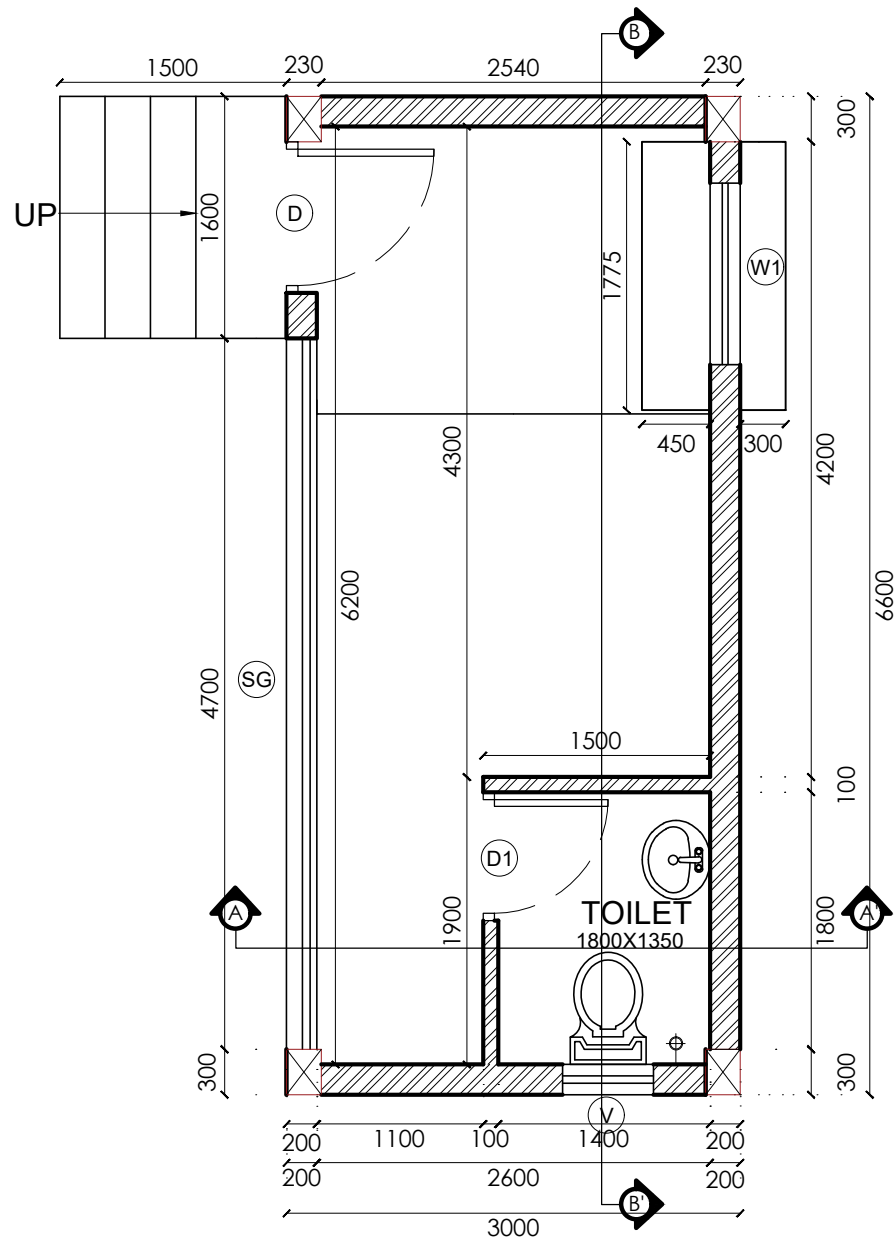

PLAN

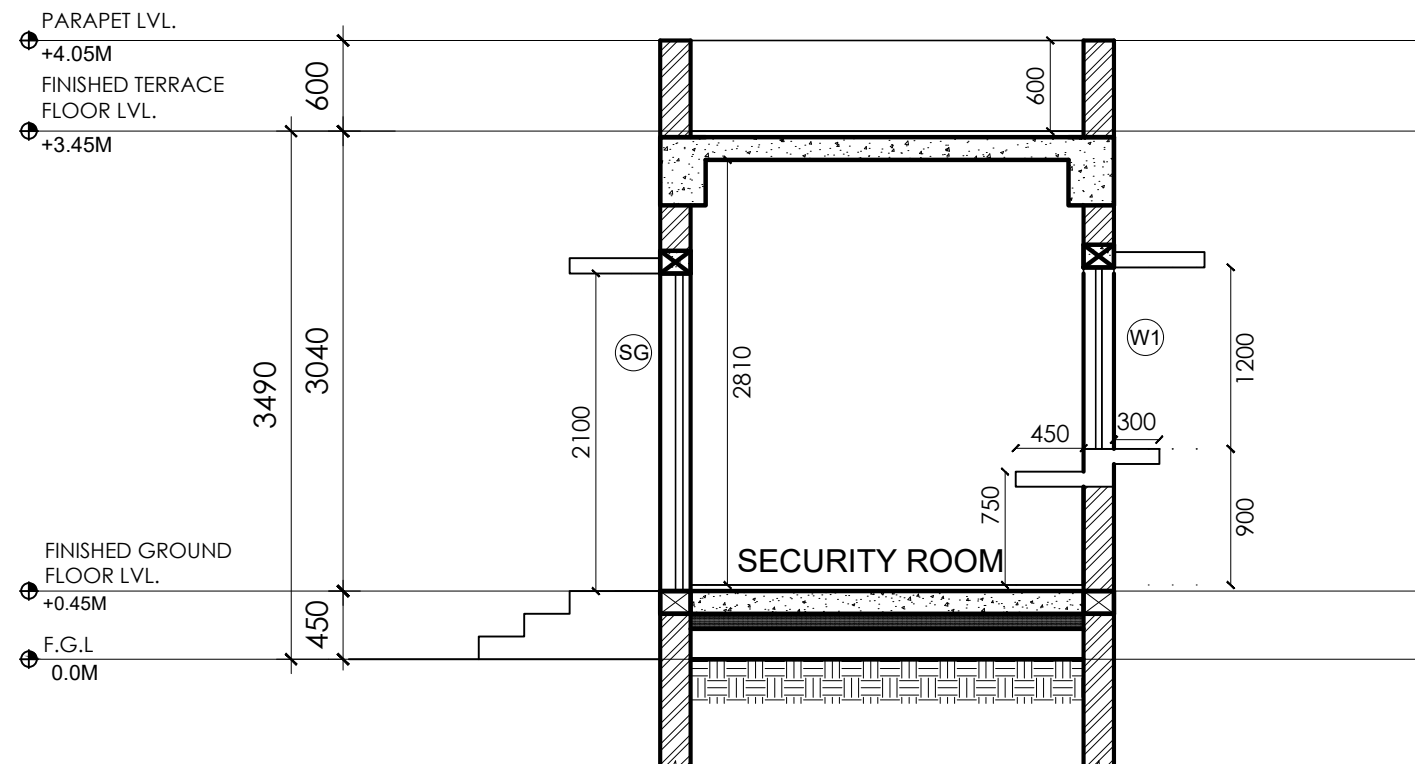

SECTION AA'

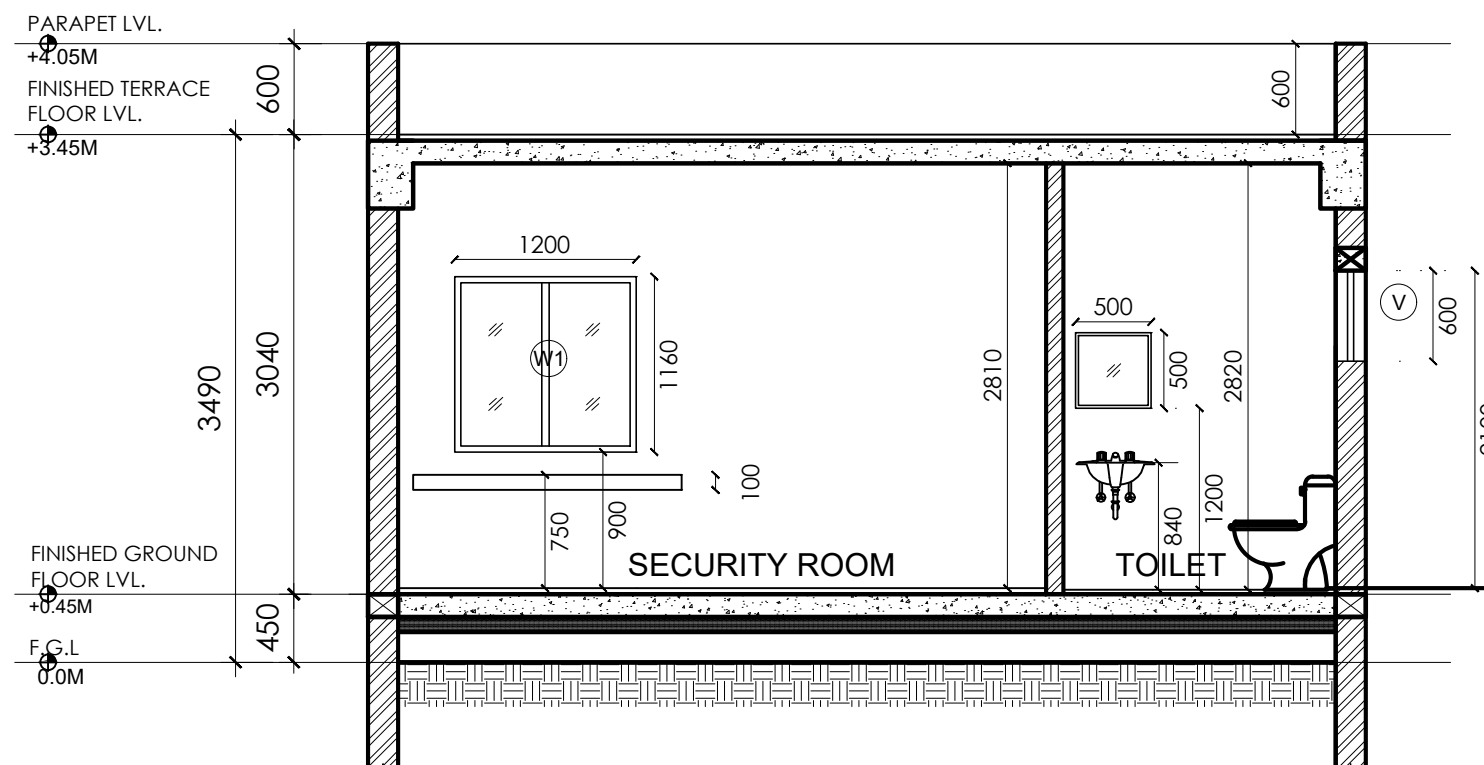

SECTION BB'

NOTES

1. This drawing is sole property of 'Pithavadian And Partners' and must not be reproduced or altered either in full or in part by anyone without consent from us or be passed to any individual or company not authorized by us.
2. Any discrepancy in the drawing should be brought to the immediate attention of the Architect.
3. All dimensions in millimeters and levels in meters.
4. Dimensions to be followed as indicated and not to be scaled.

REV.	DATE	DESCRIPTION	DRAWN	CHKD.
REVISIONS				
AS BUILT				
CONSTRUCTION				
APPROVAL				
INFORMATION				
TENDER				
SCHEME				
ISSUED FOR				
APPROVAL				
NAME OF THE PROJECT:				
PROPOSED CONSTRUCTION OF IT BUILDING				
AT THIRUCHITRAMBALAM ,				
VANUR TALUK , VILLUPURAM				
CLIENT:				
TIDEL PARK				
4, RAJIV GANDHI SALAI, TARAMANI				
DRAWING TITLE:				
SECURITY CABIN				
STRUCTURAL CONSULTANT:				
ZACHARIA GEORGE F.I.E				
SCALE:	DESIGN BY:	DRAWN BY:	CHECKED BY:	
1:50 @ A3	PDG	SHREYA	PDG	
DATE:	SIGN:	SIGN:	SIGN:	
16.06.2022				

ARCHITECTURE * INTERIORS * PLANNING * ENGINEERING * MANAGEMENT

PITHAVADIAN AND PARTNERS

Chennai • Bengaluru • Kochi • Hyderabad

10, MURUGAPPA ROAD, NAWAB GARDENS,
KOTTURPURAM, CHENNAI - 600 085

Phone : +91 (0) 44 2447 0033 / 44 166

Fax : +91 (0) 44 2447 0888/4213 2797

email : mail@paparchitect.com

website : www.paparchitect.com



DWG NO: 04-02


(SHT 01 OF 01) REV NO: 0



IIT INDORE

NOTES

1. This drawing is sole property of 'Pithavadian And Partners' and must not be reproduced or altered either in full or in part by anyone without consent from us or be passed to any individual or company not authorised by us.
2. Any discrepancy in the drawing should be brought to the immediate attention of the Architect.
3. All dimensions in millimeters and levels in meters.
4. Dimensions to be followed as indicated and not to be scaled.

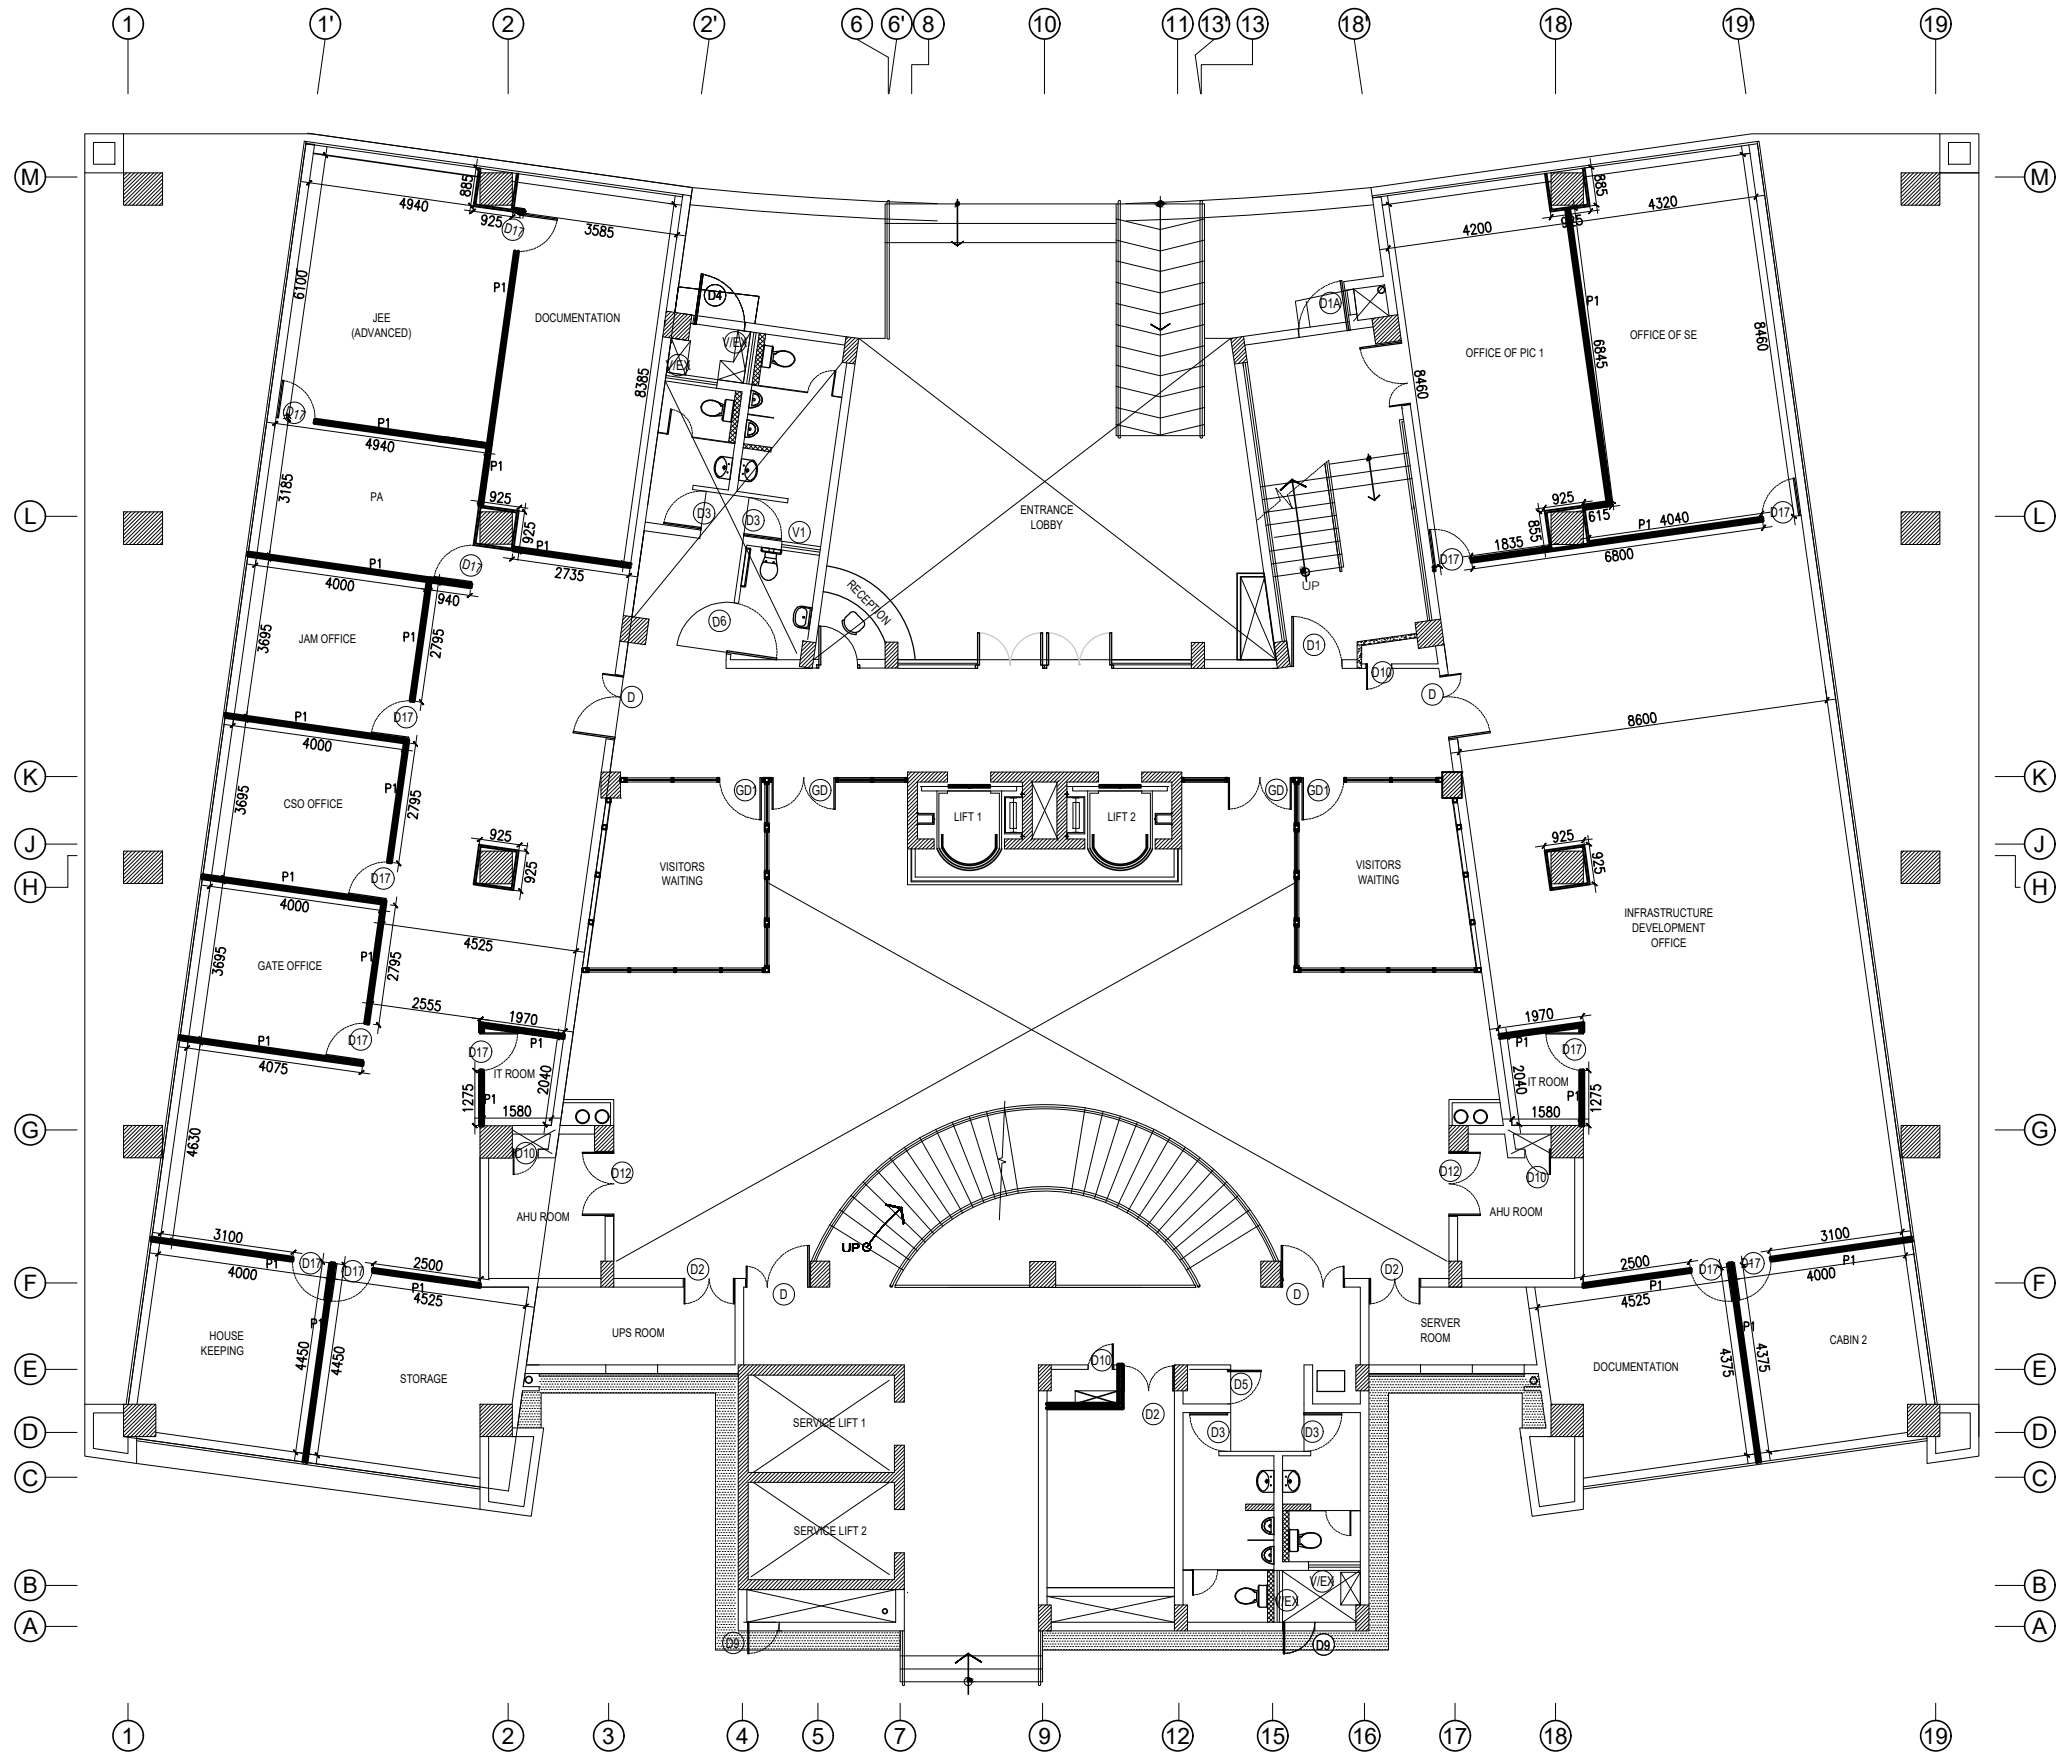

GROUND FLOOR

REV.	DATE	DESCRIPTION	DRAWN	CHKD.
------	------	-------------	-------	-------

REVISIONS				
AS BUILT	*			
CONSTRUCTION				
APPROVAL				
INFORMATION				
TENDER				
SCHEME				
ISSUED FOR				

AS BUILT

NAME OF THE PROJECT:
PLAN SHOWING CONSTRUCTION OF
ADMINISTRATION BLOCK AT IIT INDORE

CLIENT:
IIT INDORE


DRAWING TITLE:
GROUND FLOOR PLAN
INTERIOR LAYOUT
STRUCTURAL CONSULTANT:
ZACHARIA GEORGE F.I.E

SCALE: 1:150 @ A3	DESIGN BY: PDG	DRAWN BY: SHREYA	CHECKED BY: PDG
DATE: 06.08.2022	SIGN:	SIGN:	SIGN:

ARCHITECTURE * INTERIORS * PLANNING * ENGINEERING * MANAGEMENT

PITHAVADIAN AND PARTNERS
Chennai • Bengaluru • Kochi • Hyderabad
10, MURUGAPPA ROAD, NAWAB GARDENS,
KOTTURPURAM, CHENNAI - 600 085
Phone : +91 (0) 44 2447 0033 / 44 166
Fax : +91 (0) 44 2447 0888/4213 2797
email : mail@paparchitect.com
website : www.paparchitect.com



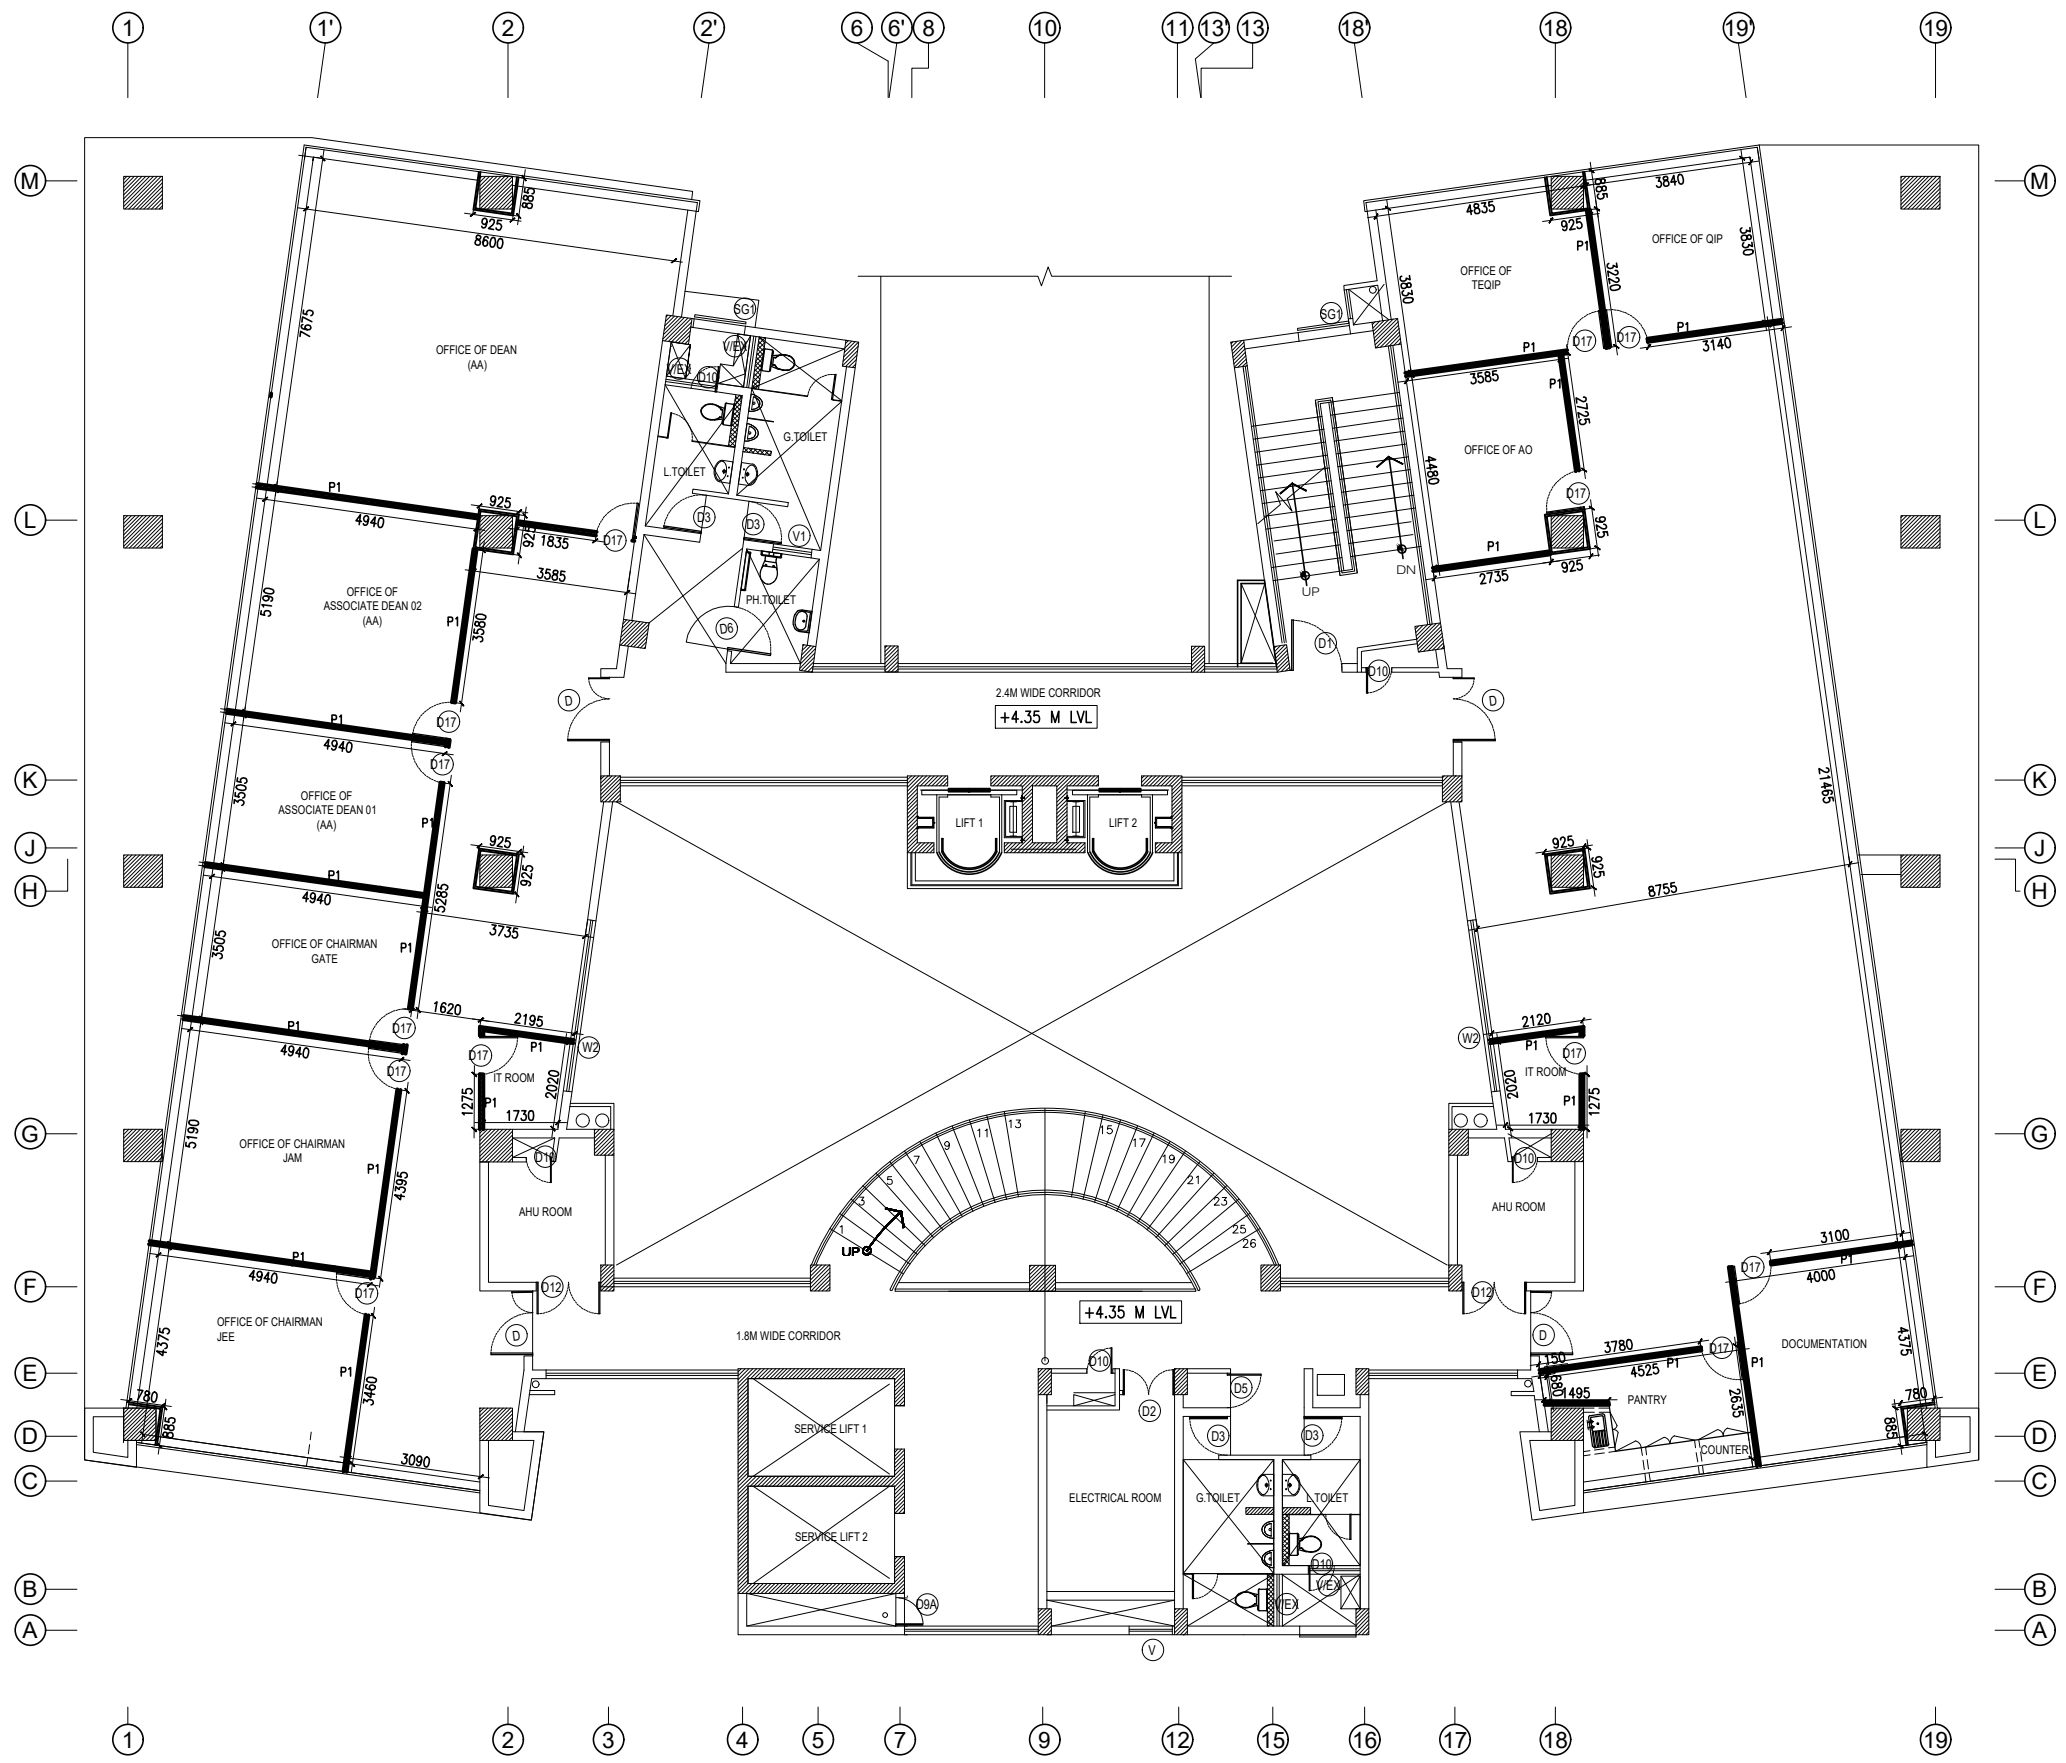

FIRST FLOOR

NOTES

1. This drawing is sole property of 'Pithavadian and Partners' and must not be reproduced or altered either in full or in part by anyone without consent from us or be passed to any individual or company not authorised by us.
2. Any discrepancy in the drawing should be brought to the immediate attention of the Architect.
3. All dimensions in millimeters and levels in meters.
4. Dimensions to be followed as indicated and not to be scaled.

REV.	DATE	DESCRIPTION	DRAWN	CHKD.
REVISIONS				
AS BUILT	*	AS BUILT		
CONSTRUCTION				
APPROVAL				
INFORMATION				
TENDER				
SCHEME				
ISSUED FOR				
NAME OF THE PROJECT:				
PLAN SHOWING CONSTRUCTION OF ADMINISTRATION BLOCK AT IIT INDORE				
CLIENT:				
IIT INDORE				
		DRAWING TITLE:		
		FIRST FLOOR PLAN INTERIOR LAYOUT		
		STRUCTURAL CONSULTANT:		
		ZACHARIA GEORGE F.I.E		
SCALE:	DESIGN BY:	DRAWN BY:	CHECKED BY:	
1:150 @ A3	PDG	SHREYA	PDG	
DATE:	SIGN:	SIGN:	SIGN:	
06.08.2022				
ARCHITECTURE * INTERIORS * PLANNING * ENGINEERING * MANAGEMENT				
PITHAVADIAN AND PARTNERS				
Chennai ▪ Bengaluru ▪ Kochi ▪ Hyderabad				
10, MURUGAPPA ROAD, NAWAB GARDENS, KOTTURPURAM, CHENNAI - 600 085				
Phone : +91 (0) 44 2447 0033 / 44 166				
Fax : +91 (0) 44 2447 0888/4213 2797				
email : mail@paparchitect.com				
website : www.paparchitect.com				
				
DWG NO: 05-01B		(SHT 02 OF 10)	REV NO: 0	

NOTES

1. This drawing is sole property of 'Pithavadian and Partners' and must not be reproduced or altered either in full or in part by anyone without consent from us or be passed to any individual or company not authorized by us.
2. Any discrepancy in the drawing should be brought to the immediate attention of the Architect.
3. All dimensions in millimeters and levels in meters.
4. Dimensions to be followed as indicated and not to be scaled.

REV.	DATE	DESCRIPTION	DRAWN	CHKD.
------	------	-------------	-------	-------

REVISIONS				
AS BUILT	*			
CONSTRUCTION				
APPROVAL				
INFORMATION				
TENDER				
SCHEME				
ISSUED FOR				

AS BUILT

NAME OF THE PROJECT:
PLAN SHOWING CONSTRUCTION OF
ADMINISTRATION BLOCK AT IIT INDORE

CLIENT:
IIT INDORE

DRAWING TITLE:
SECOND FLOOR PLAN
INTERIOR LAYOUT

STRUCTURAL CONSULTANT:
ZACHARIA GEORGE F.I.E

SCALE: 1:150 @ A3	DESIGN BY: PDG	DRAWN BY: SHREYA	CHECKED BY: PDG
DATE: 06.08.2022	SIGN:	SIGN:	SIGN:

ARCHITECTURE * INTERIORS * PLANNING * ENGINEERING * MANAGEMENT


PITHAVADIAN AND PARTNERS
Chennai • Bengaluru • Kochi • Hyderabad

10, MURUGAPPA ROAD, NAWAB GARDENS,
KOTTURPURAM, CHENNAI - 600 085

Phone : +91 (0) 44 2447 0033 / 44 166
Fax : +91 (0) 44 2447 0888/4213 2797
email : mail@paparchitect.com
website : www.paparchitect.com



DWG NO: 05-01C (SHT 03 OF 10) REV NO: 0

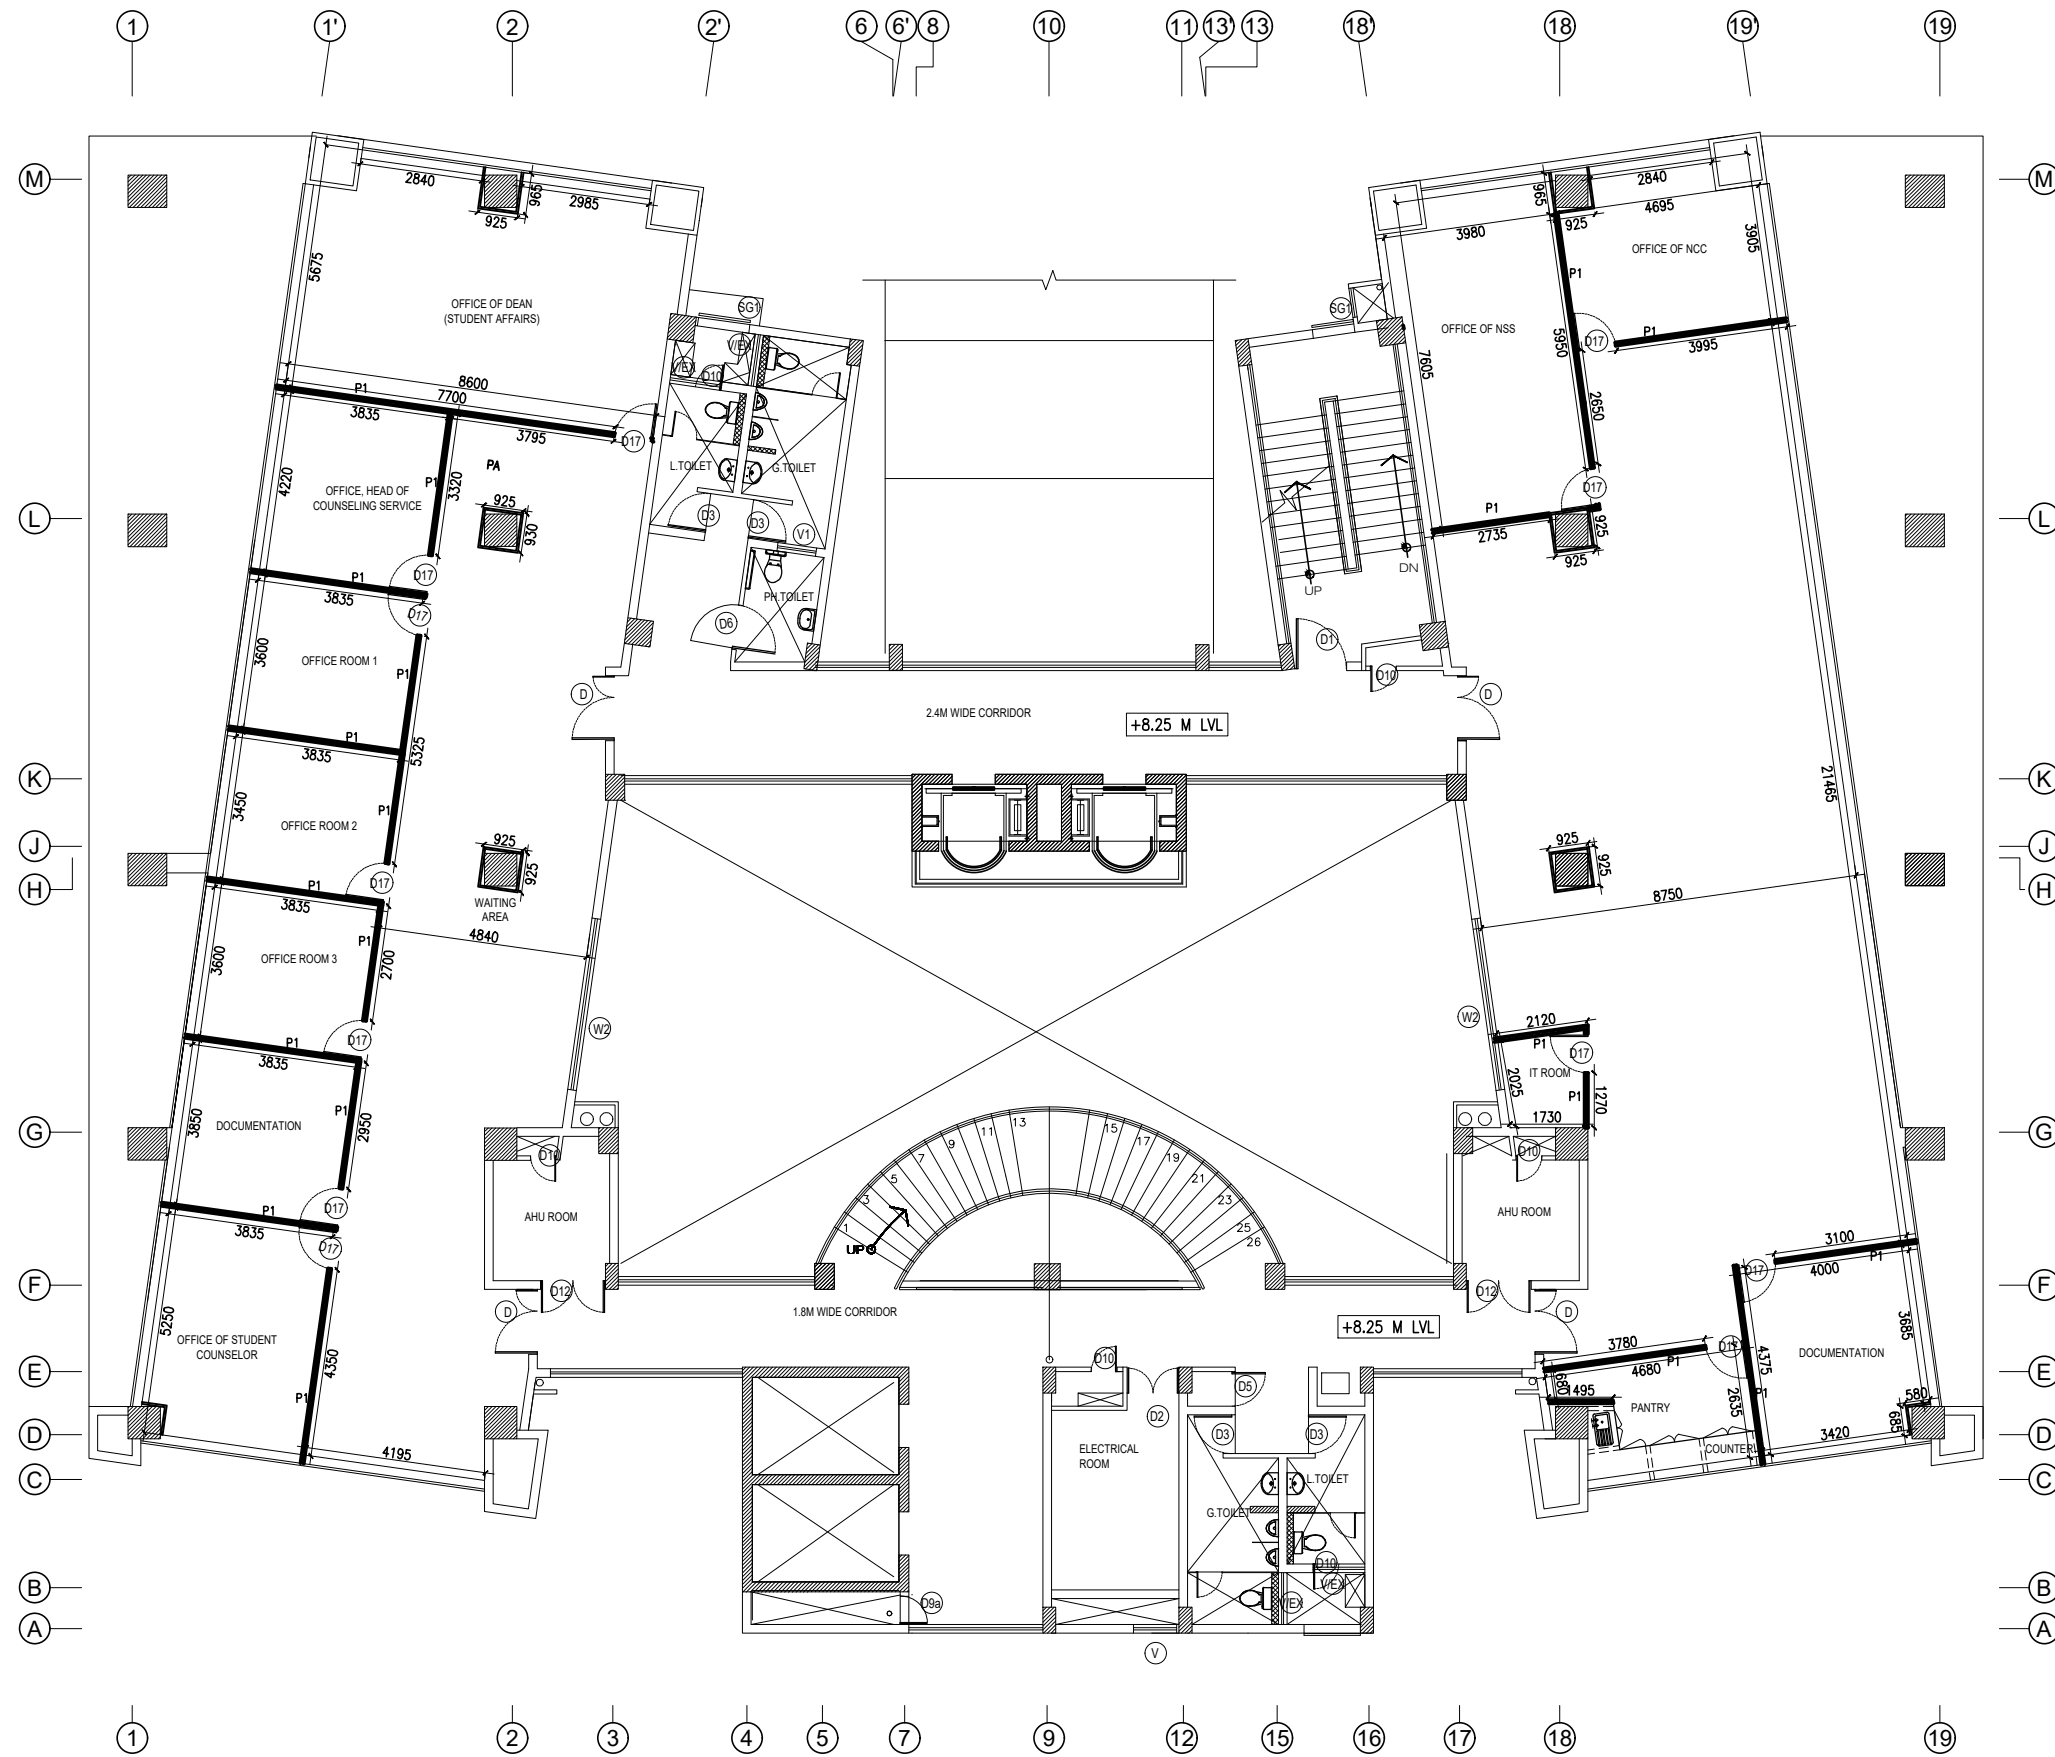

SECOND FLOOR

NOTES

1. This drawing is sole property of 'Pithavadian and Partners' and must not be reproduced or altered either in full or in part by anyone without consent from us or be passed to any individual or company not authorised by us.
2. Any discrepancy in the drawing should be brought to the immediate attention of the Architect.
3. All dimensions in millimeters and levels in meters.
4. Dimensions to be followed as indicated and not to be scaled.

REV.	DATE	DESCRIPTION	DRAWN	CHKD.
------	------	-------------	-------	-------

REVISIONS				
AS BUILT	*			
CONSTRUCTION				
APPROVAL				
INFORMATION				
TENDER				
SCHEME				
ISSUED FOR				

AS BUILT

NAME OF THE PROJECT:
PLAN SHOWING CONSTRUCTION OF
ADMINISTRATION BLOCK AT IIT INDORE

CLIENT:
IIT INDORE

DRAWING TITLE:
THIRD FLOOR PLAN
INTERIOR LAYOUT
STRUCTURAL CONSULTANT:
ZACHARIA GEORGE F.I.E


SCALE: 1:150 @ A3	DESIGN BY: PDG	DRAWN BY: SHREYA	CHECKED BY: PDG
DATE: 06.08.2022	SIGN:	SIGN:	SIGN:

ARCHITECTURE * INTERIORS * PLANNING * ENGINEERING * MANAGEMENT

PITHAVADIAN AND PARTNERS
Chennai • Bengaluru • Kochi • Hyderabad
10, MURUGAPPA ROAD, NAWAB GARDENS,
KOTURPURAM, CHENNAI - 600 085
Phone : +91 (0) 44 2447 0033 / 44 166
Fax : +91 (0) 44 2447 0888/4213 2797
email : mail@paparchitect.com
website : www.paparchitect.com



DWG NO: 05-01D (SHT 04 OF 10) REV NO: 0

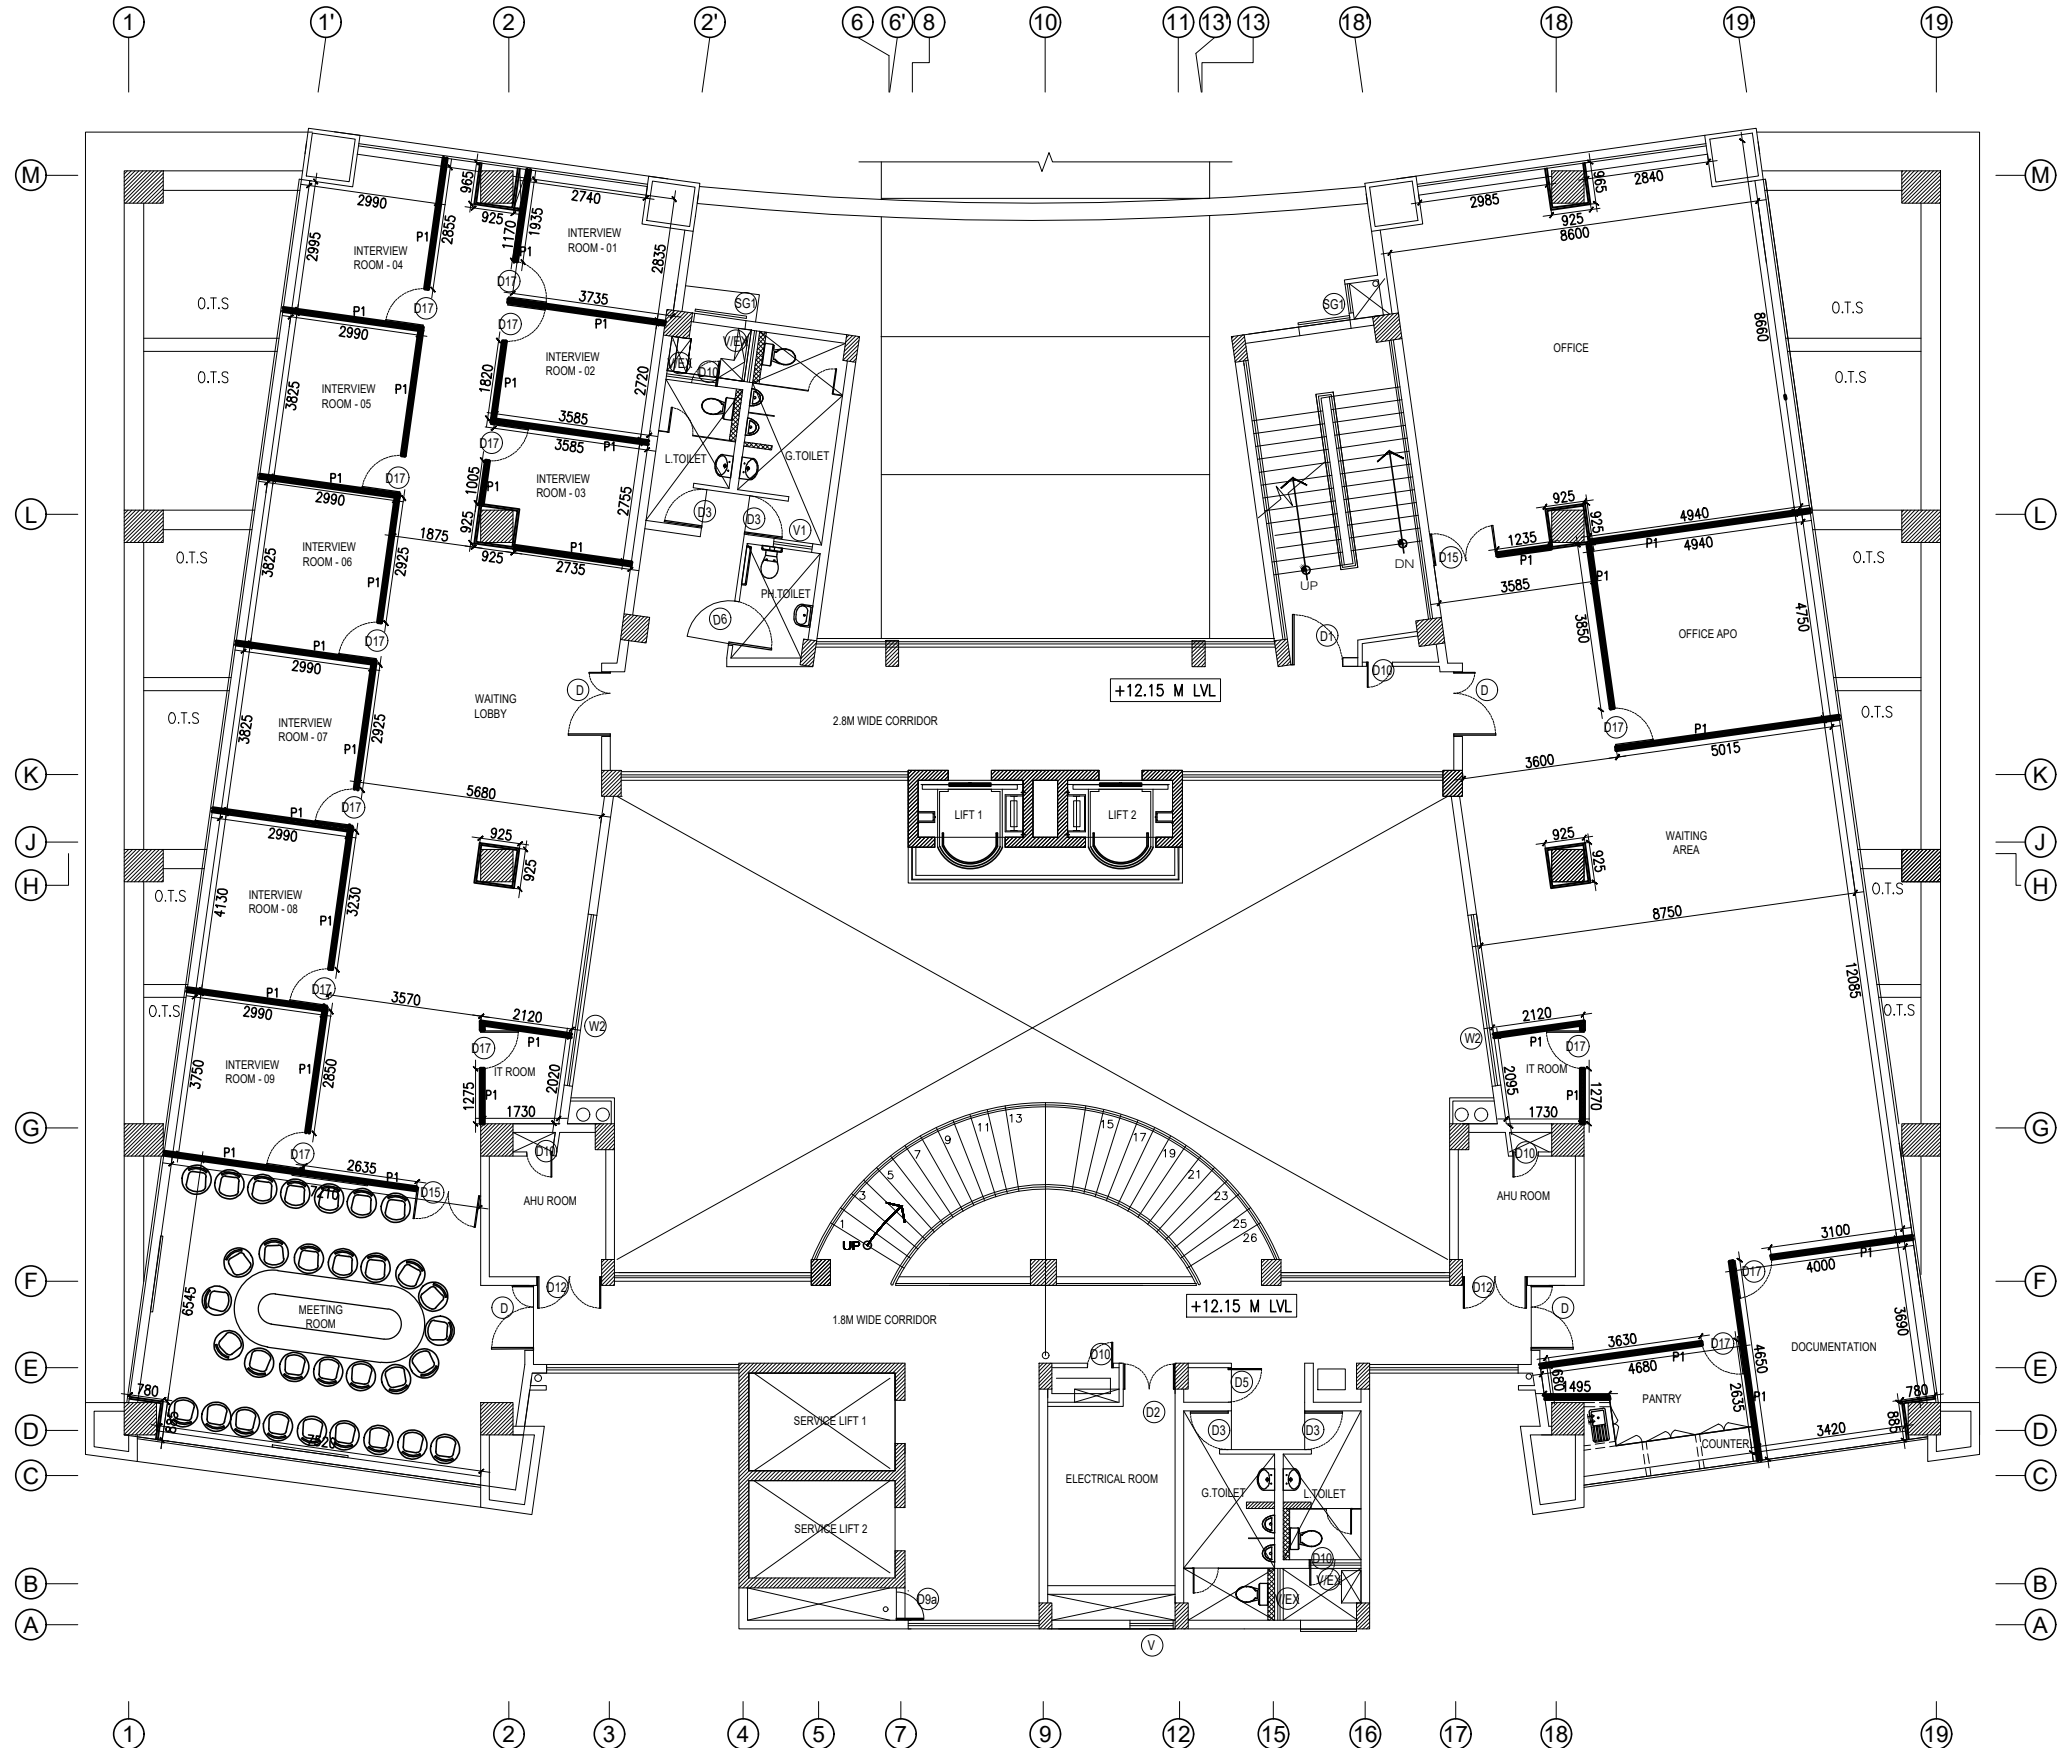

THIRD FLOOR

NOTES

1. This drawing is sole property of 'Pithavadian and Partners' and must not be reproduced or altered either in full or in part by anyone without consent from us or be passed to any individual or company not authorized by us.
2. Any discrepancy in the drawing should be brought to the immediate attention of the Architect.
3. All dimensions in millimeters and levels in meters.
4. Dimensions to be followed as indicated and not to be scaled.

REV.	DATE	DESCRIPTION	DRAWN	CHKD.
------	------	-------------	-------	-------

REVISIONS

AS BUILT	*
CONSTRUCTION	
APPROVAL	
INFORMATION	
TENDER	
SCHEME	
ISSUED FOR	

AS BUILT

NAME OF THE PROJECT:
PLAN SHOWING CONSTRUCTION OF
ADMINISTRATION BLOCK AT IIT INDORE

CLIENT:
IIT INDORE

DRAWING TITLE:
FOURTH FLOOR PLAN
INTERIOR LAYOUT

STRUCTURAL CONSULTANT:
ZACHARIA GEORGE F.I.E

SCALE: 1:150 @ A3	DESIGN BY: PDG	DRAWN BY: SHREYA	CHECKED BY: PDG
DATE: 06.08.2022	SIGN:	SIGN:	SIGN:

ARCHITECTURE * INTERIORS * PLANNING * ENGINEERING * MANAGEMENT


PITHAVADIAN AND PARTNERS
Chennai • Bengaluru • Kochi • Hyderabad

10, MURUGAPPA ROAD, NAWAB GARDENS,
KOTURPURAM, CHENNAI - 600 085

Phone : +91 (0) 44 2447 0033 / 44 166
Fax : +91 (0) 44 2447 0888 / 4213 2797
email : mail@paparchitect.com
website : www.paparchitect.com



DWG NO: 05-01E (SHT 05 OF 10) REV NO: 0

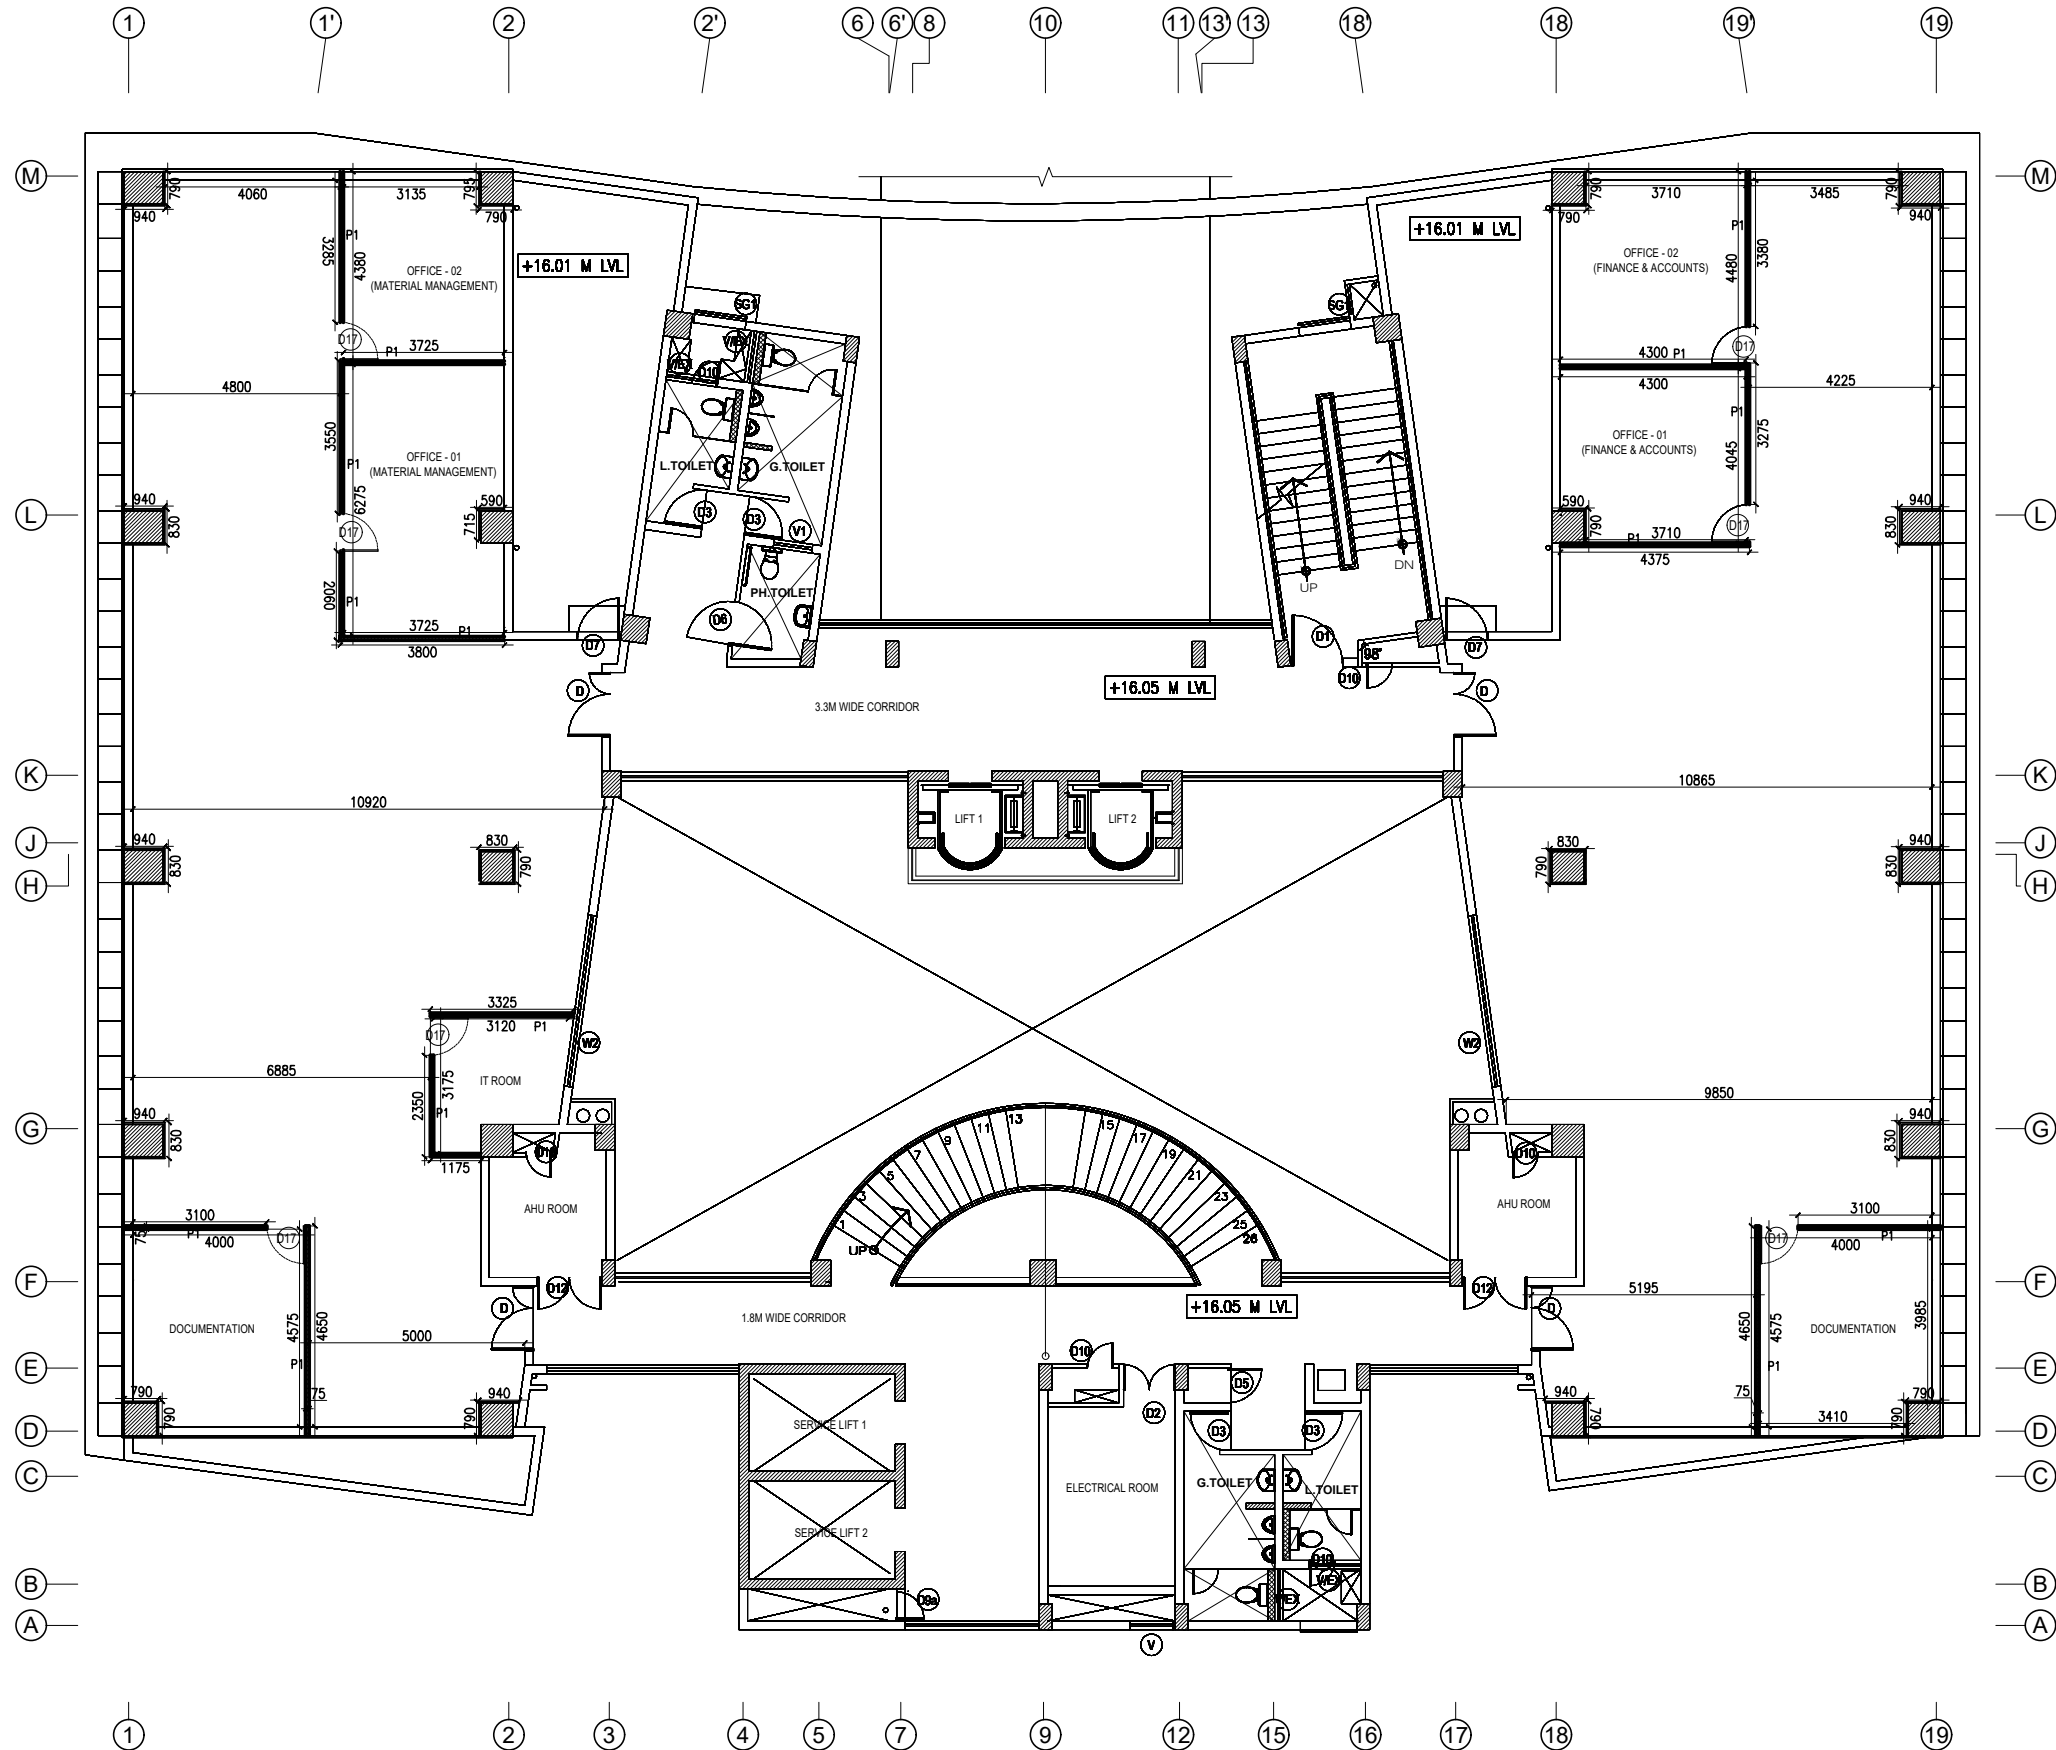

FOURTH FLOOR

NOTES

1. This drawing is sole property of 'Pithavadian And Partners' and must not be reproduced or altered either in full or in part by anyone without consent from us or be passed to any individual or company not authorised by us.
2. Any discrepancy in the drawing should be brought to the immediate attention of the Architect.
3. All dimensions in millimeters and levels in meters.
4. Dimensions to be followed as indicated and not to be scaled.

REV.	DATE	DESCRIPTION	DRAWN	CHKD.
------	------	-------------	-------	-------

REVISIONS				
AS BUILT	*			
CONSTRUCTION				
APPROVAL				
INFORMATION				
TENDER				
SCHEME				
ISSUED FOR				

NAME OF THE PROJECT:
PLAN SHOWING CONSTRUCTION OF
ADMINISTRATION BLOCK AT IIT INDORE

CLIENT:
IIT INDORE

DRAWING TITLE:
FIFTH FLOOR PLAN
INTERIOR LAYOUT
STRUCTURAL CONSULTANT:
ZACHARIA GEORGE F.I.E


SCALE: 1:150 @ A3	DESIGN BY: PDG	DRAWN BY: SHREYA	CHECKED BY: PDG
DATE: 06.08.2022	SIGN:	SIGN:	SIGN:

ARCHITECTURE * INTERIORS * PLANNING * ENGINEERING * MANAGEMENT

PITHAVADIAN AND PARTNERS
Chennai • Bengaluru • Kochi • Hyderabad
10, MURUGAPPA ROAD, NAWAB GARDENS,
KOTURPURAM, CHENNAI - 600 085
Phone : +91 (0) 44 2447 0033 / 44 166
Fax : +91 (0) 44 2447 0888/4213 2797
email : mail@paparchitect.com
website : www.paparchitect.com




DWG NO: 05-01F (SHT 06 OF 10) REV NO: 0

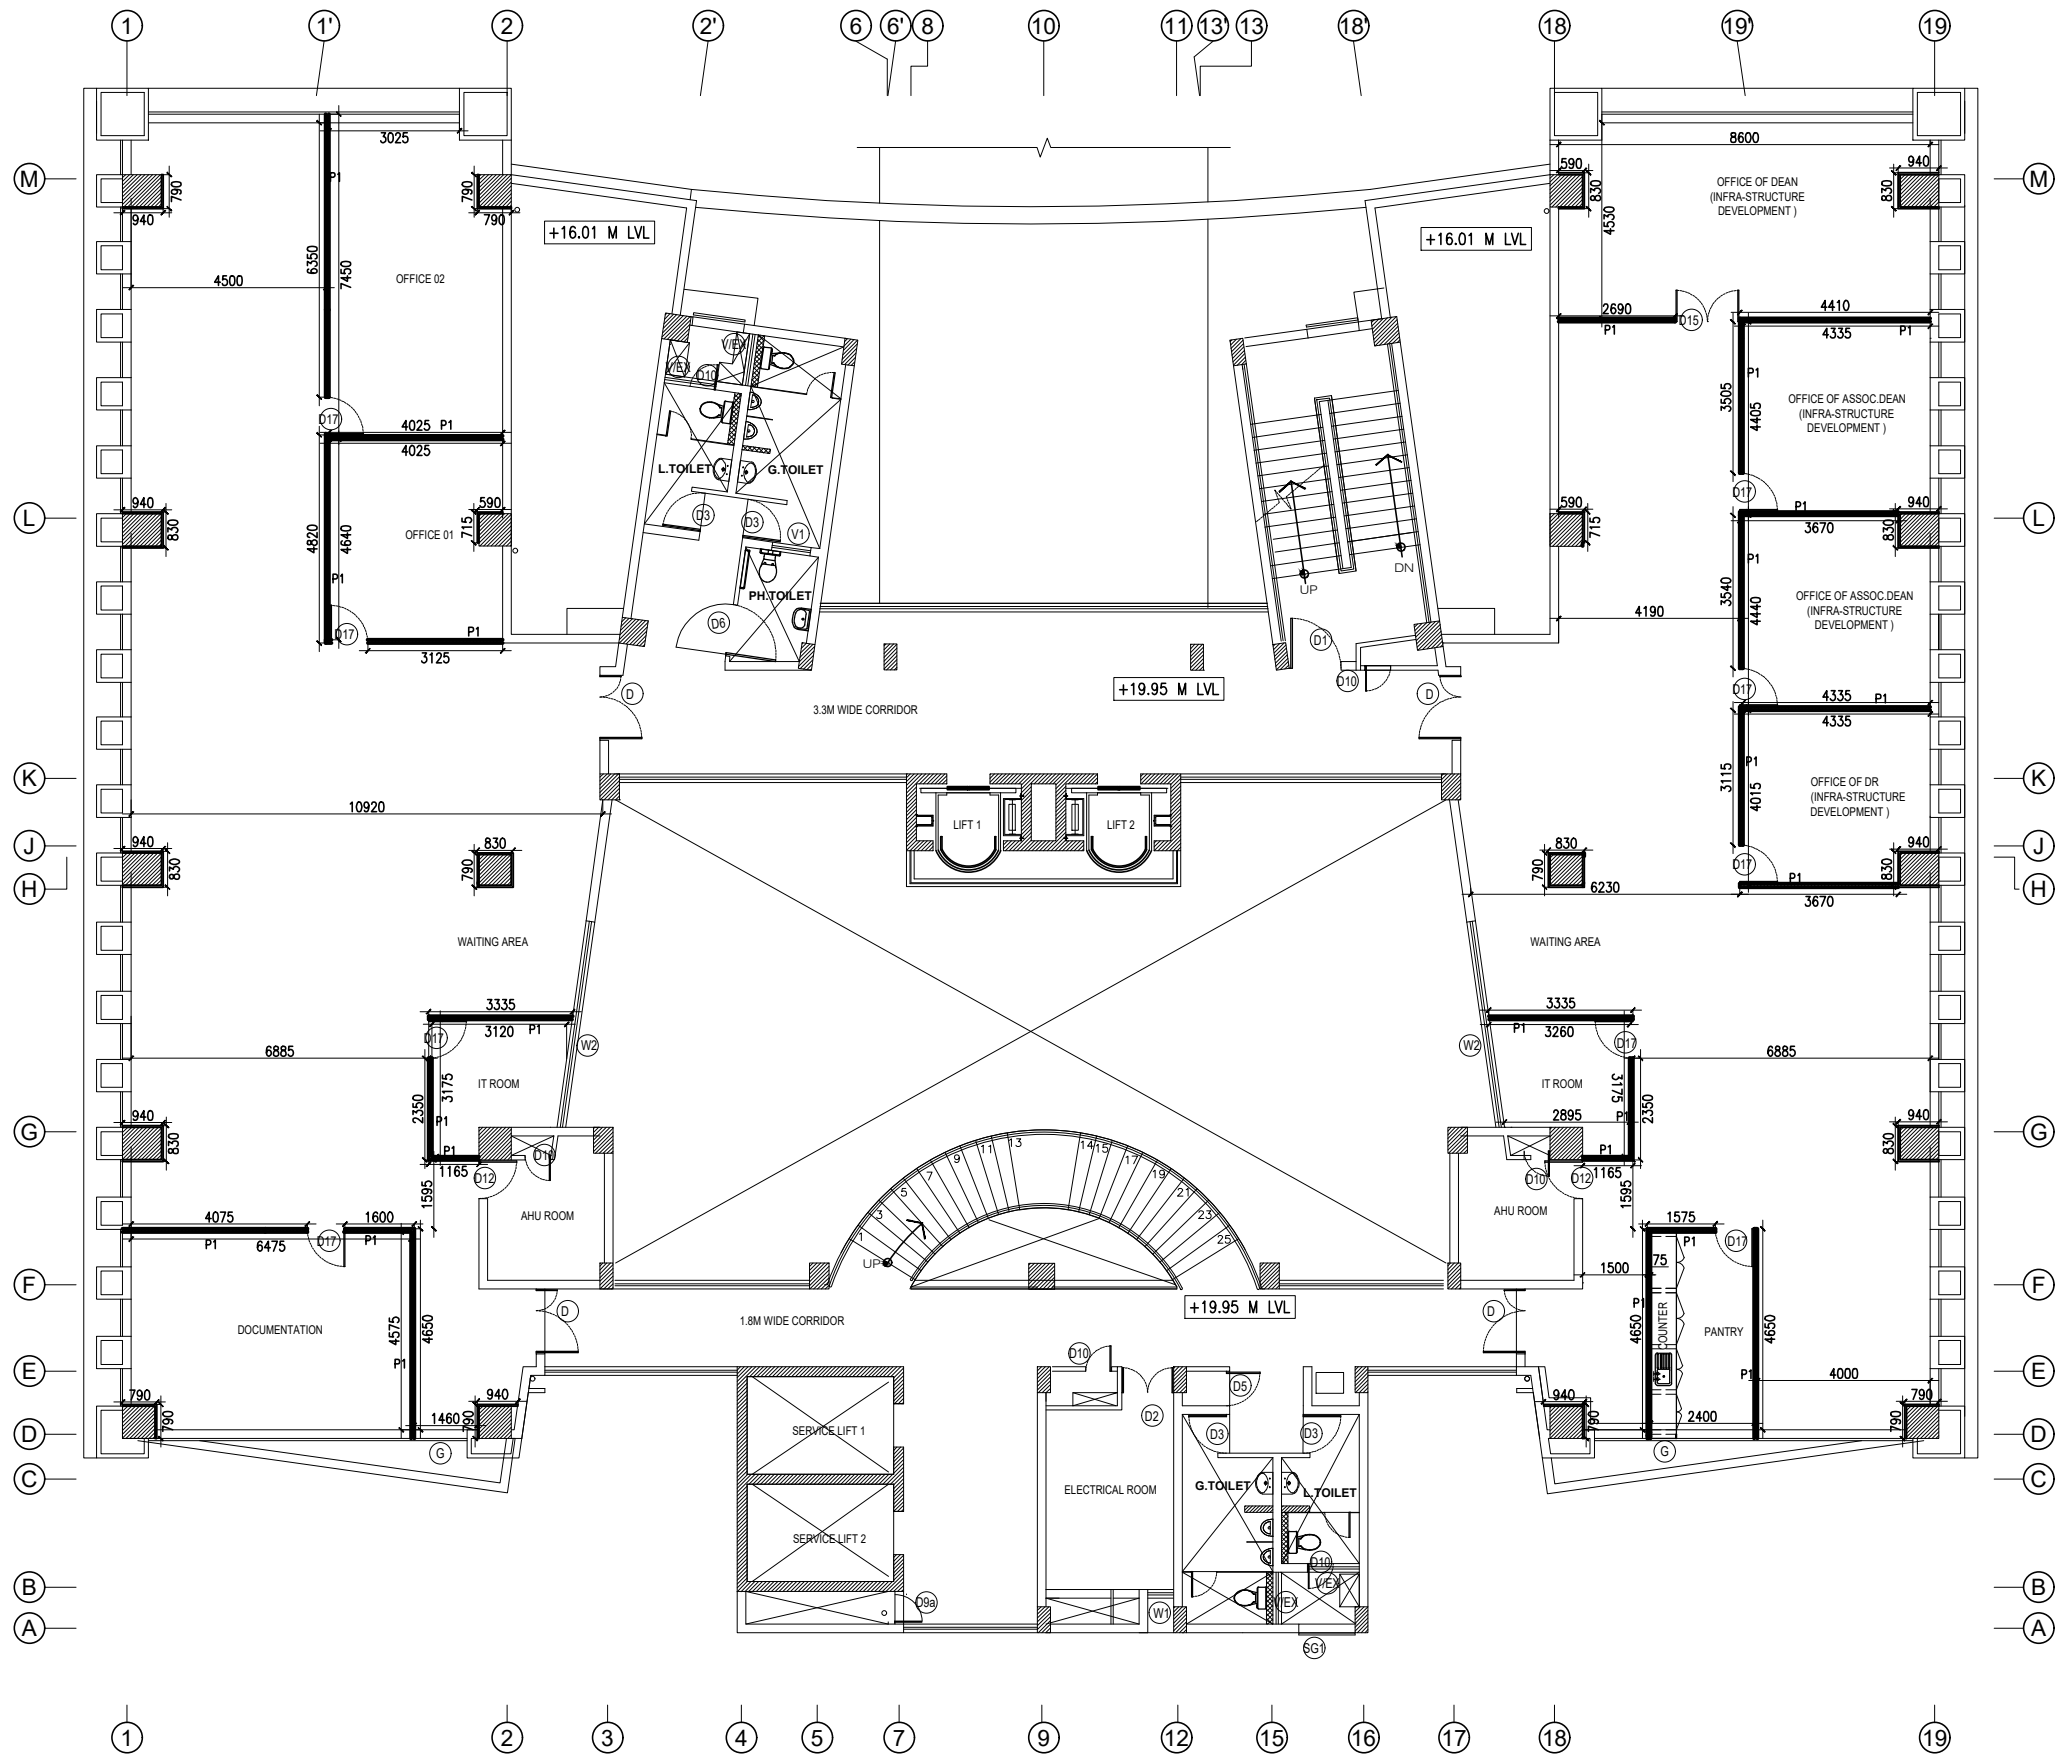

FIFTH FLOOR

NOTES

1. This drawing is sole property of 'Pithavadian and Partners' and must not be reproduced or altered either in full or in part by anyone without consent from us or be passed to any individual or company not authorized by us.
2. Any discrepancy in the drawing should be brought to the immediate attention of the Architect.
3. All dimensions in millimeters and levels in meters.
4. Dimensions to be followed as indicated and not to be scaled.

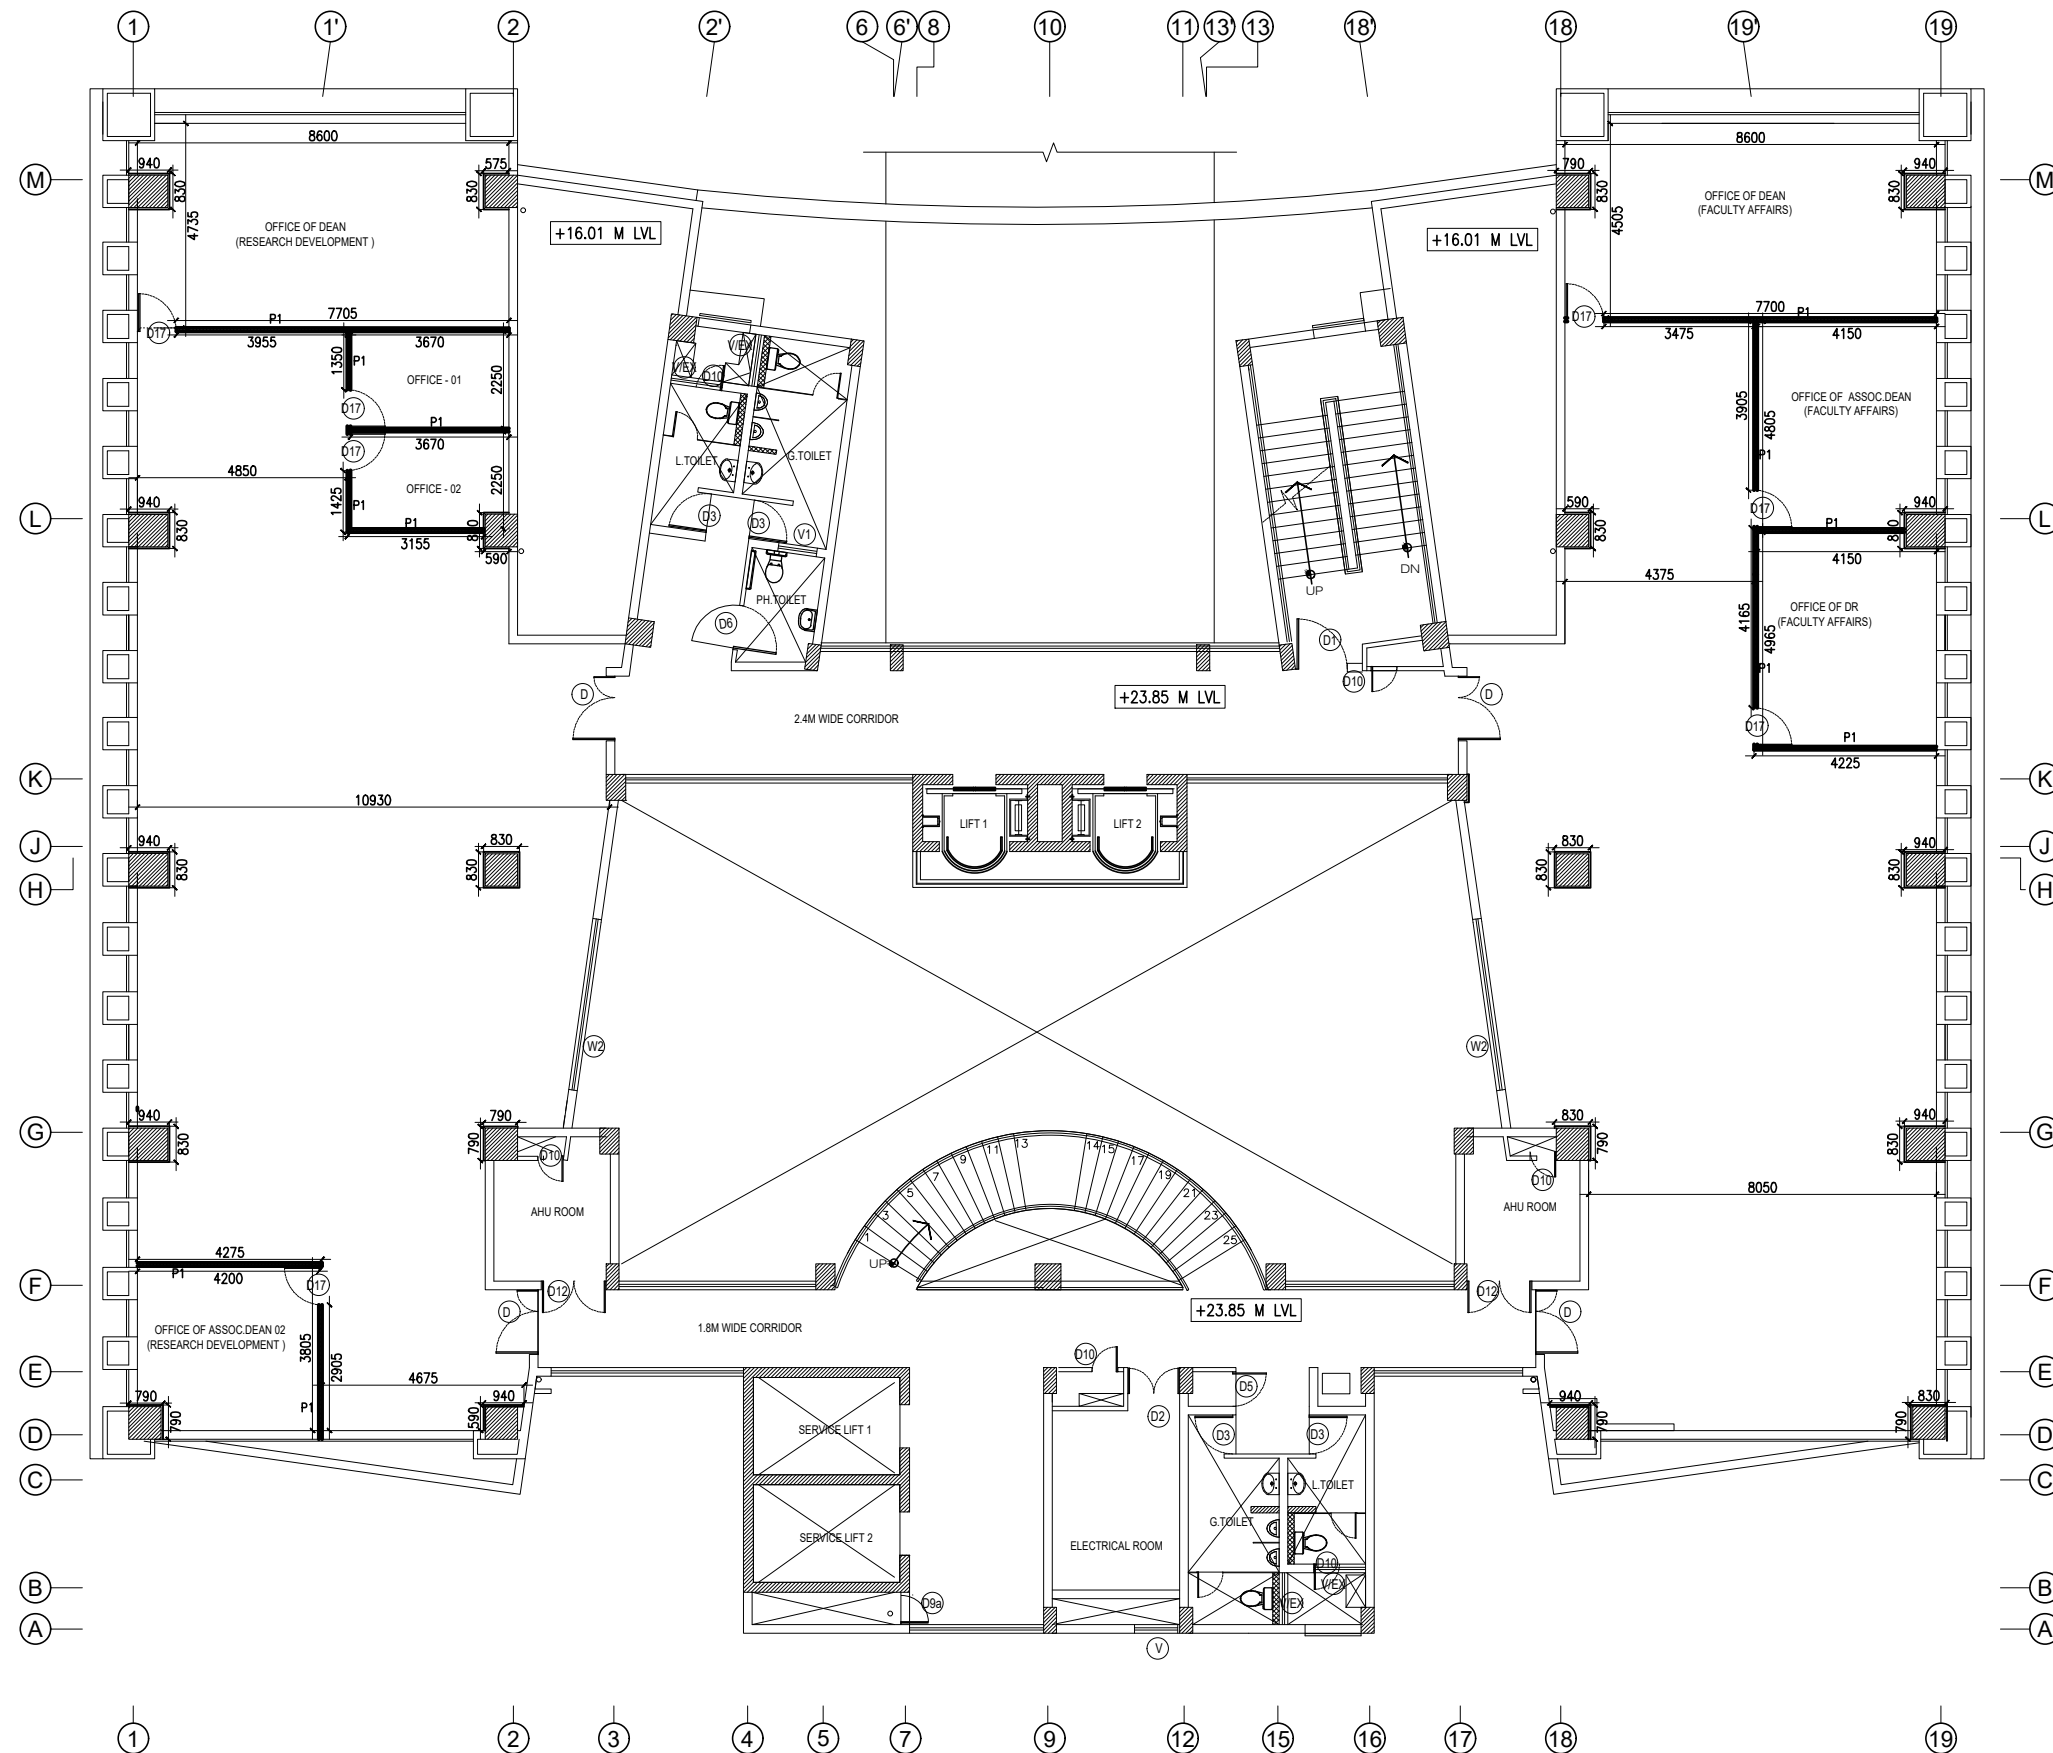

SIXTH FLOOR

REV.	DATE	DESCRIPTION	DRAWN	CHKD.
REVISIONS				
AS BUILT				
CONSTRUCTION				
APPROVAL				
INFORMATION				
TENDER				
SCHEME				
ISSUED FOR				
AS BUILT				
NAME OF THE PROJECT:				
PLAN SHOWING CONSTRUCTION OF				
ADMINISTRATION BLOCK AT IIT INDORE				
CLIENT:				
IIT INDORE				
DRAWING TITLE:				
SIXTH FLOOR PLAN				
INTERIOR LAYOUT				
STRUCTURAL CONSULTANT:				
ZACHARIA GEORGE F.I.E				
SCALE:	DESIGN BY:	DRAWN BY:	CHECKED BY:	
1:150 @ A3	PDG	SHREYA	PDG	
DATE:	SIGN:	SIGN:	SIGN:	
06.08.2022				

ARCHITECTURE * INTERIORS * PLANNING * ENGINEERING * MANAGEMENT

PITHAVADIAN AND PARTNERS
Chennai • Bengaluru • Kochi • Hyderabad

10, MURUGAPPA ROAD, NAWAB GARDENS,
KOTURPURAM, CHENNAI - 600 085

Phone : +91 (0) 44 2447 0033 / 44 166

Fax : +91 (0) 44 2447 0888/4213 2797


email : mail@paparchitect.com

website : www.paparchitect.com



DWG NO: 05-01G

(SHT 07 OF 10) REV NO: 0

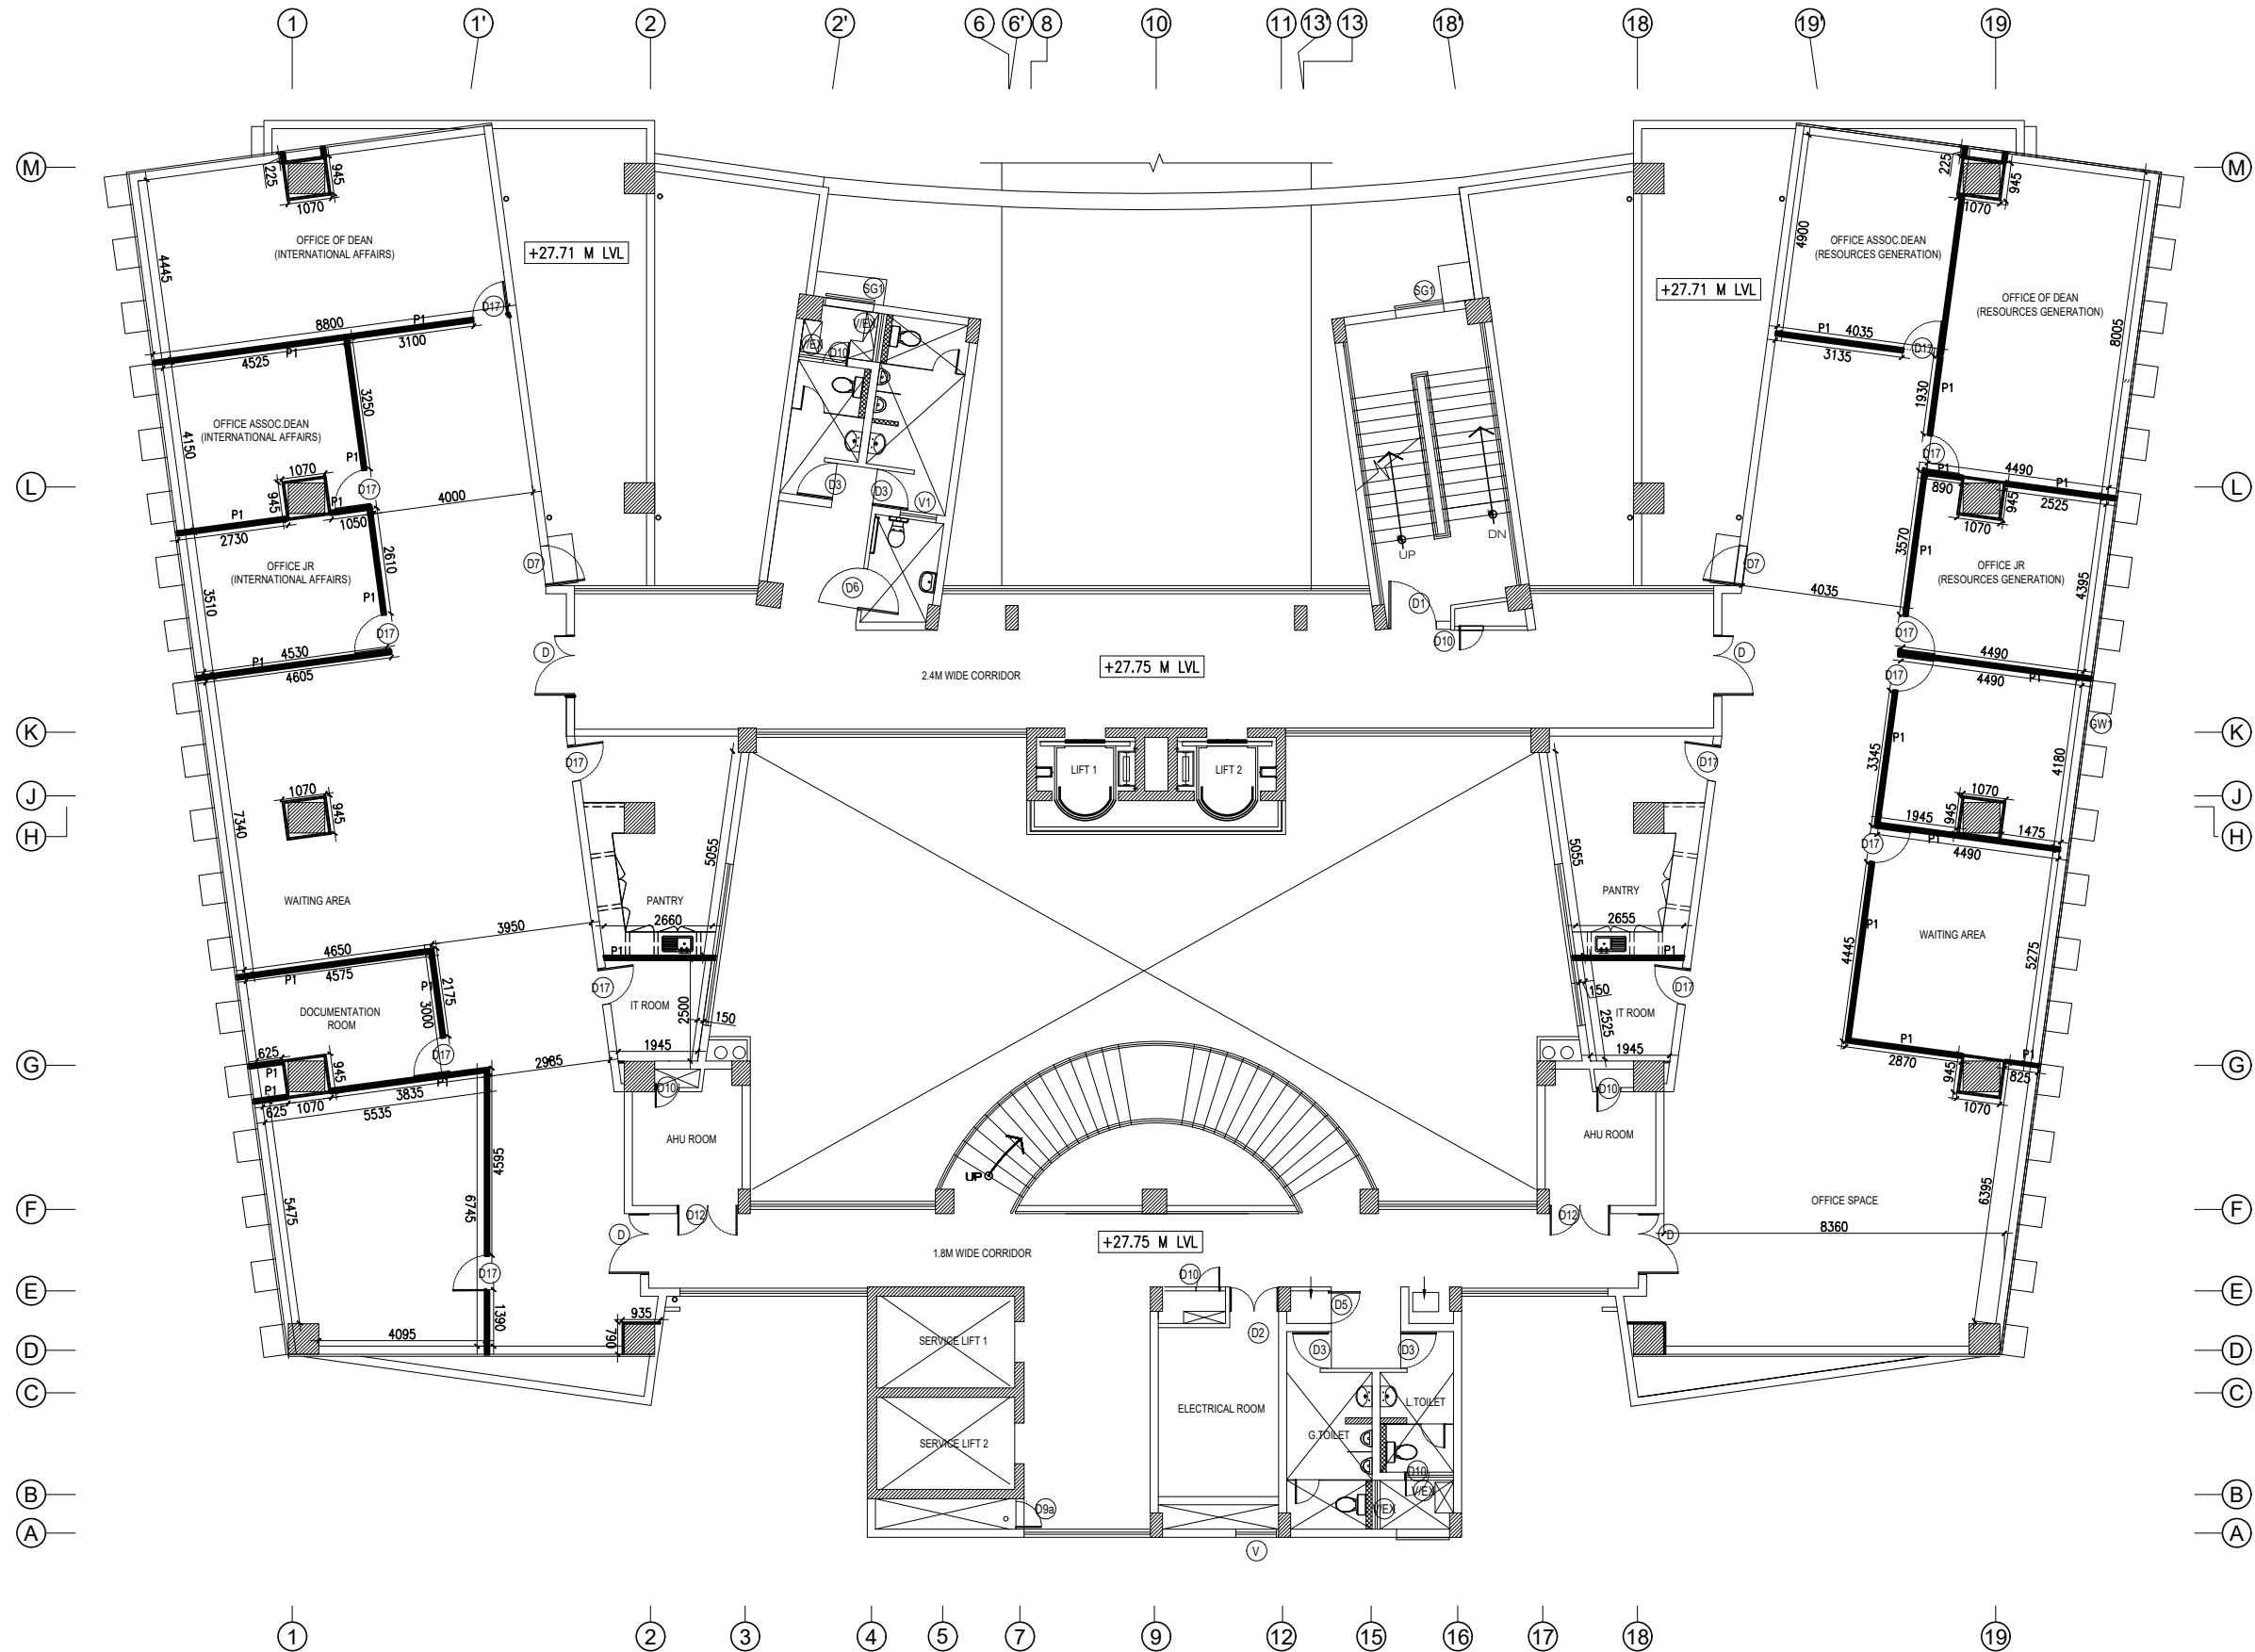

SEVENTH FLOOR

NOTES

1. This drawing is sole property of 'Pithavadian And Partners' and must not be reproduced or altered either in full or in part by anyone without consent from us or be passed to any individual or company not authorized by us.
2. Any discrepancy in the drawing should be brought to the immediate attention of the Architect.
3. All dimensions in millimeters and levels in meters.
4. Dimensions to be followed as indicated and not to be scaled.

REV.	DATE	DESCRIPTION	DRAWN	CHKD.
------	------	-------------	-------	-------

REVISIONS				
AS BUILT	*			
CONSTRUCTION				
APPROVAL				
INFORMATION				
TENDER				
SCHEME				
ISSUED FOR				

AS BUILT

NAME OF THE PROJECT:
PLAN SHOWING CONSTRUCTION OF
ADMINISTRATION BLOCK AT IIT INDORE

CLIENT:
IIT INDORE

DRAWING TITLE:
SEVENTH FLOOR PLAN
INTERIOR LAYOUT
STRUCTURAL CONSULTANT:
ZACHARIA GEORGE F.I.E


SCALE: 1:150 @ A3	DESIGN BY: PDG	DRAWN BY: SHREYA	CHECKED BY: PDG
DATE: 06.08.2022	SIGN:	SIGN:	SIGN:

ARCHITECTURE * INTERIORS * PLANNING * ENGINEERING * MANAGEMENT

PITHAVADIAN AND PARTNERS
Chennai • Bengaluru • Kochi • Hyderabad
10, MURUGAPPA ROAD, NAWAB GARDENS,
KOTURPURAM, CHENNAI - 600 085
Phone : +91 (0) 44 2447 0033 / 44 166
Fax : +91 (0) 44 2447 0888 / 4213 2797
email : mail@paparchitect.com
website : www.paparchitect.com



DWG NO: 05-01H (SHT 08 OF 10) REV NO: 0

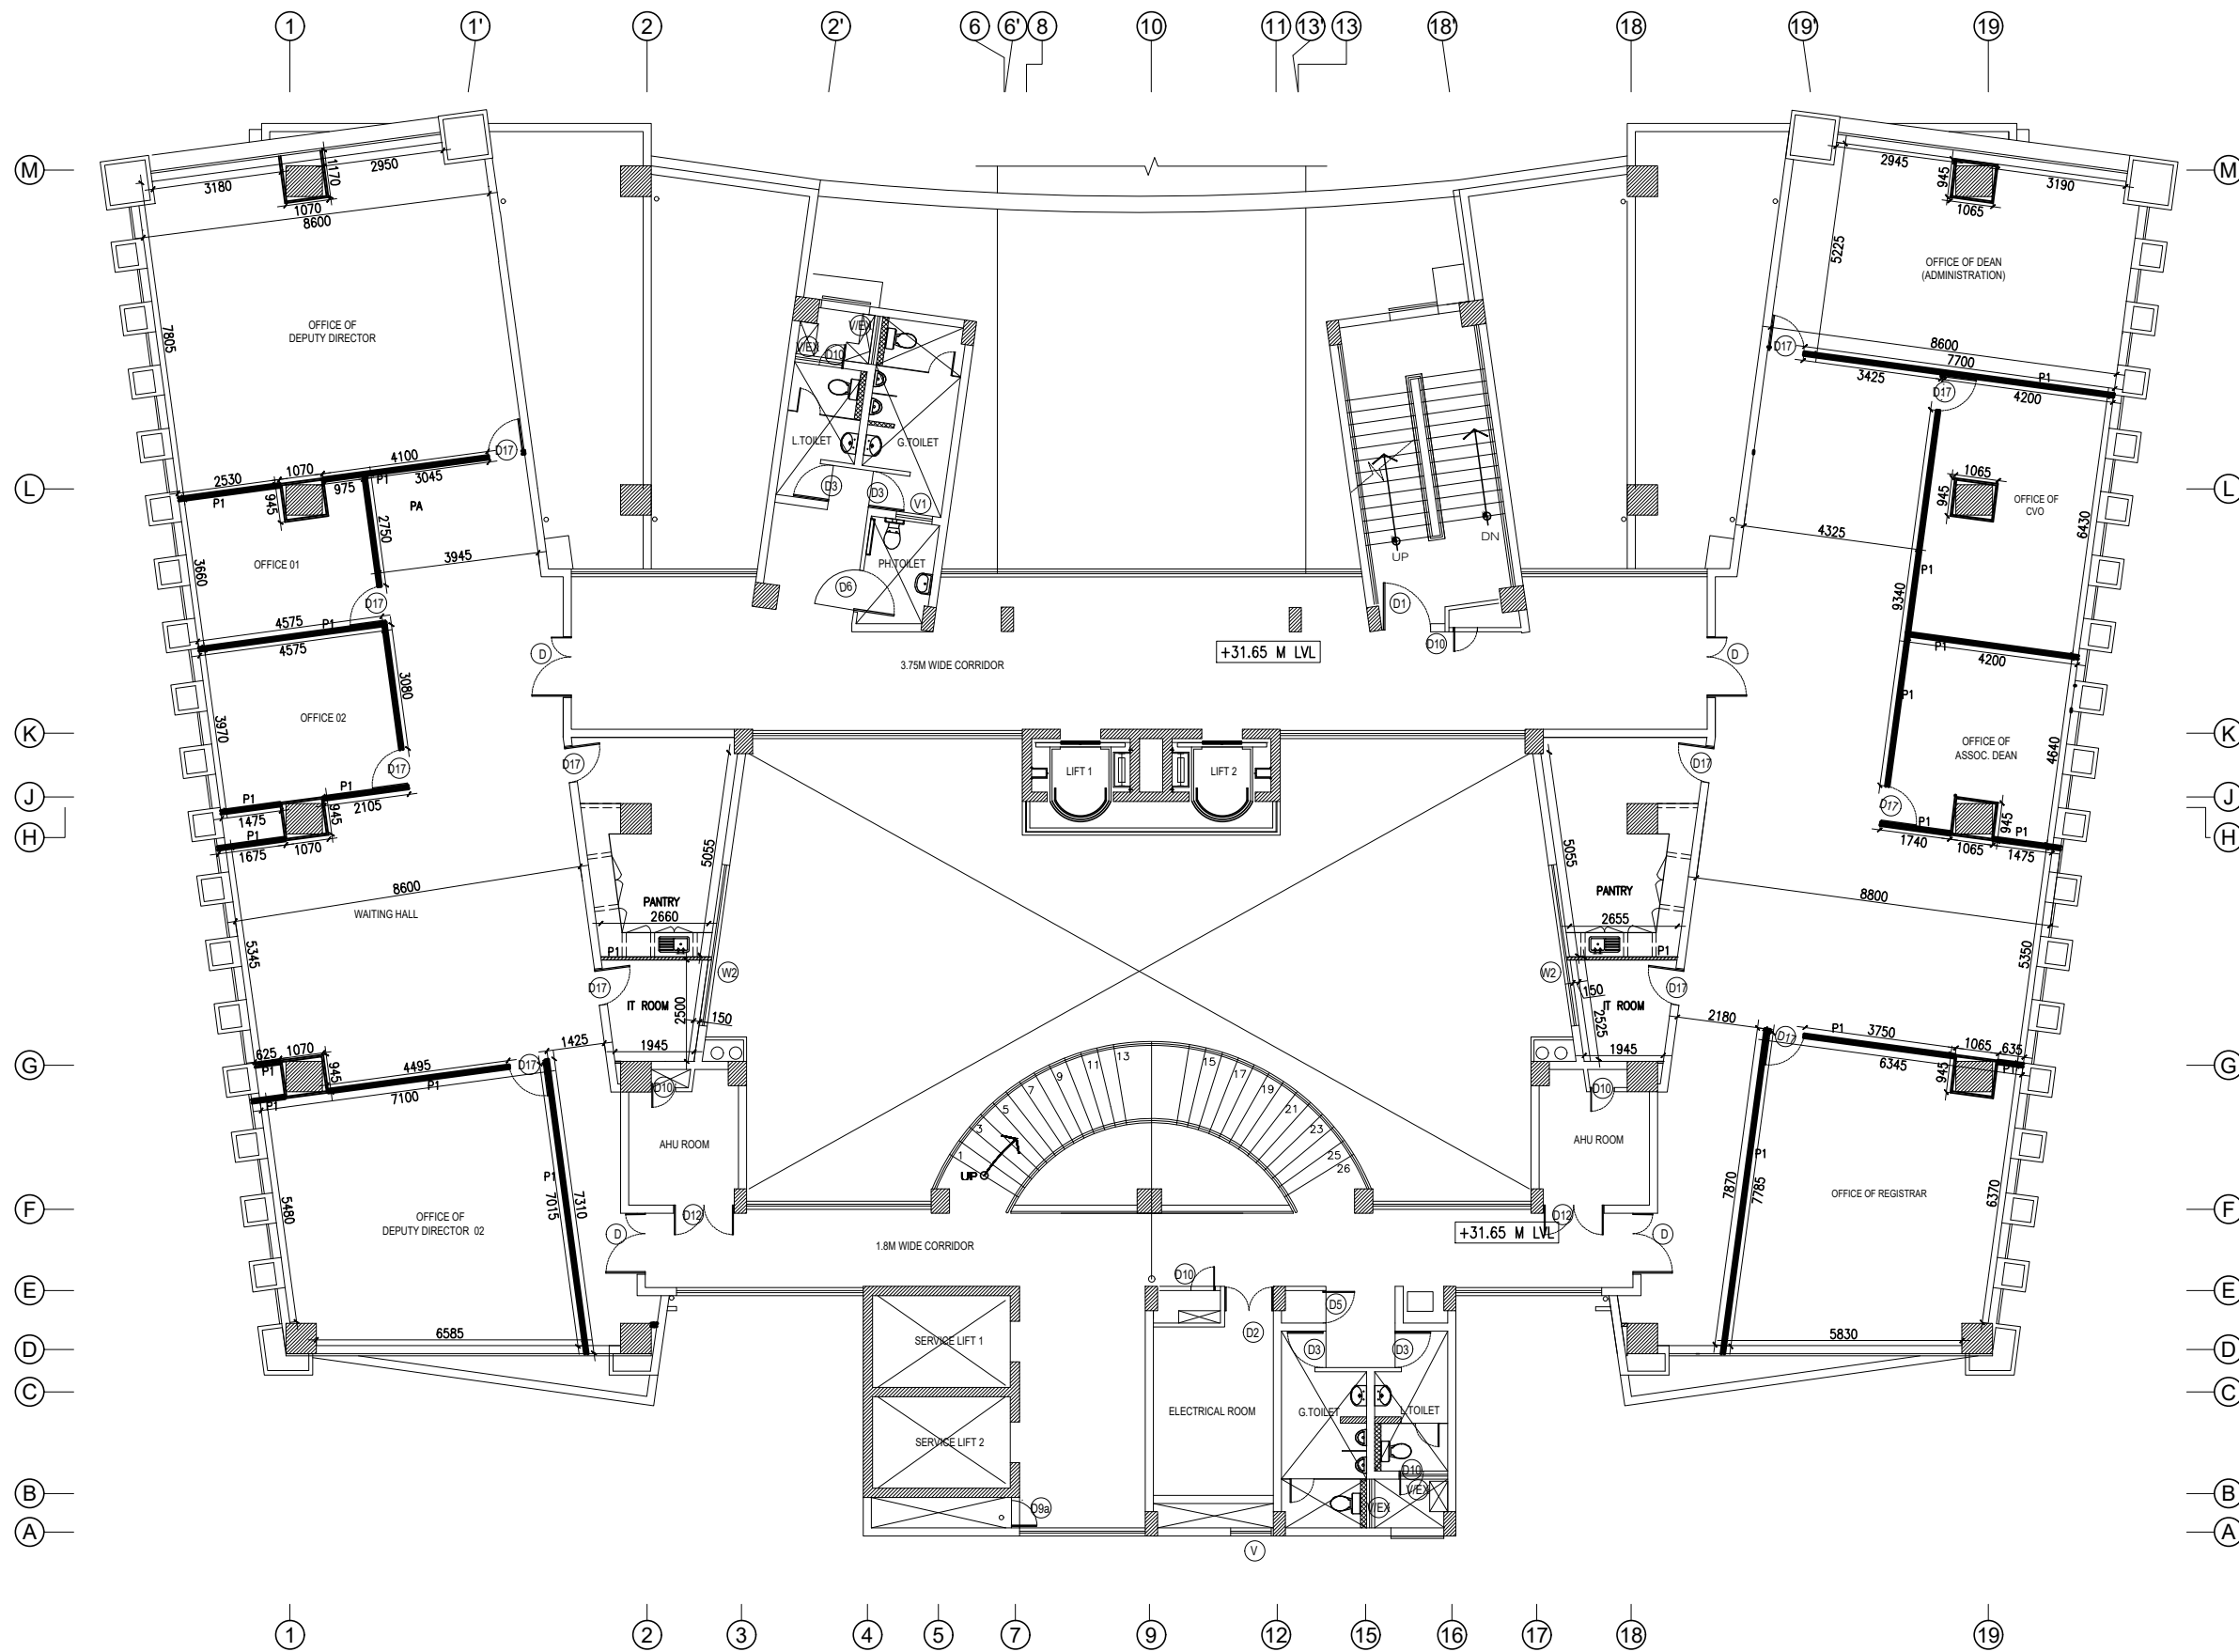

EIGHTH FLOOR

NOTES

1. This drawing is sole property of 'Pithavadian and Partners' and must not be reproduced or altered either in full or in part by anyone without consent from us or be passed to any individual or company not authorized by us.
2. Any discrepancy in the drawing should be brought to the immediate attention of the Architect.
3. All dimensions in millimeters and levels in meters.
4. Dimensions to be followed as indicated and not to be scaled.

REV.	DATE	DESCRIPTION	DRAWN	CHKD.
------	------	-------------	-------	-------

REVISIONS				
AS BUILT	*			
CONSTRUCTION				
APPROVAL				
INFORMATION				
TENDER				
SCHEME				
ISSUED FOR				

AS BUILT

NAME OF THE PROJECT:
PLAN SHOWING CONSTRUCTION OF
ADMINISTRATION BLOCK AT IIT INDORE

CLIENT:
IIT INDORE

DRAWING TITLE:
EIGHTH FLOOR PLAN
INTERIOR LAYOUT
STRUCTURAL CONSULTANT:
ZACHARIA GEORGE F.I.E


SCALE: 1:150 @ A3	DESIGN BY: PDG	DRAWN BY: SHREYA	CHECKED BY: PDG
DATE: 06.08.2022	SIGN:	SIGN:	SIGN:

ARCHITECTURE * INTERIORS * PLANNING * ENGINEERING * MANAGEMENT

PITHAVADIAN AND PARTNERS
Chennai • Bengaluru • Kochi • Hyderabad
10, MURUGAPPA ROAD, NAWAB GARDENS,
KOTTURPURAM, CHENNAI - 600 085
Phone : +91 (0) 44 2447 0033 / 44 166
Fax : +91 (0) 44 2447 0888 / 4213 2797
email : mail@paparchitect.com
website : www.paparchitect.com



DWG NO: 05-011 (SHT 09 OF 10) REV NO: 0

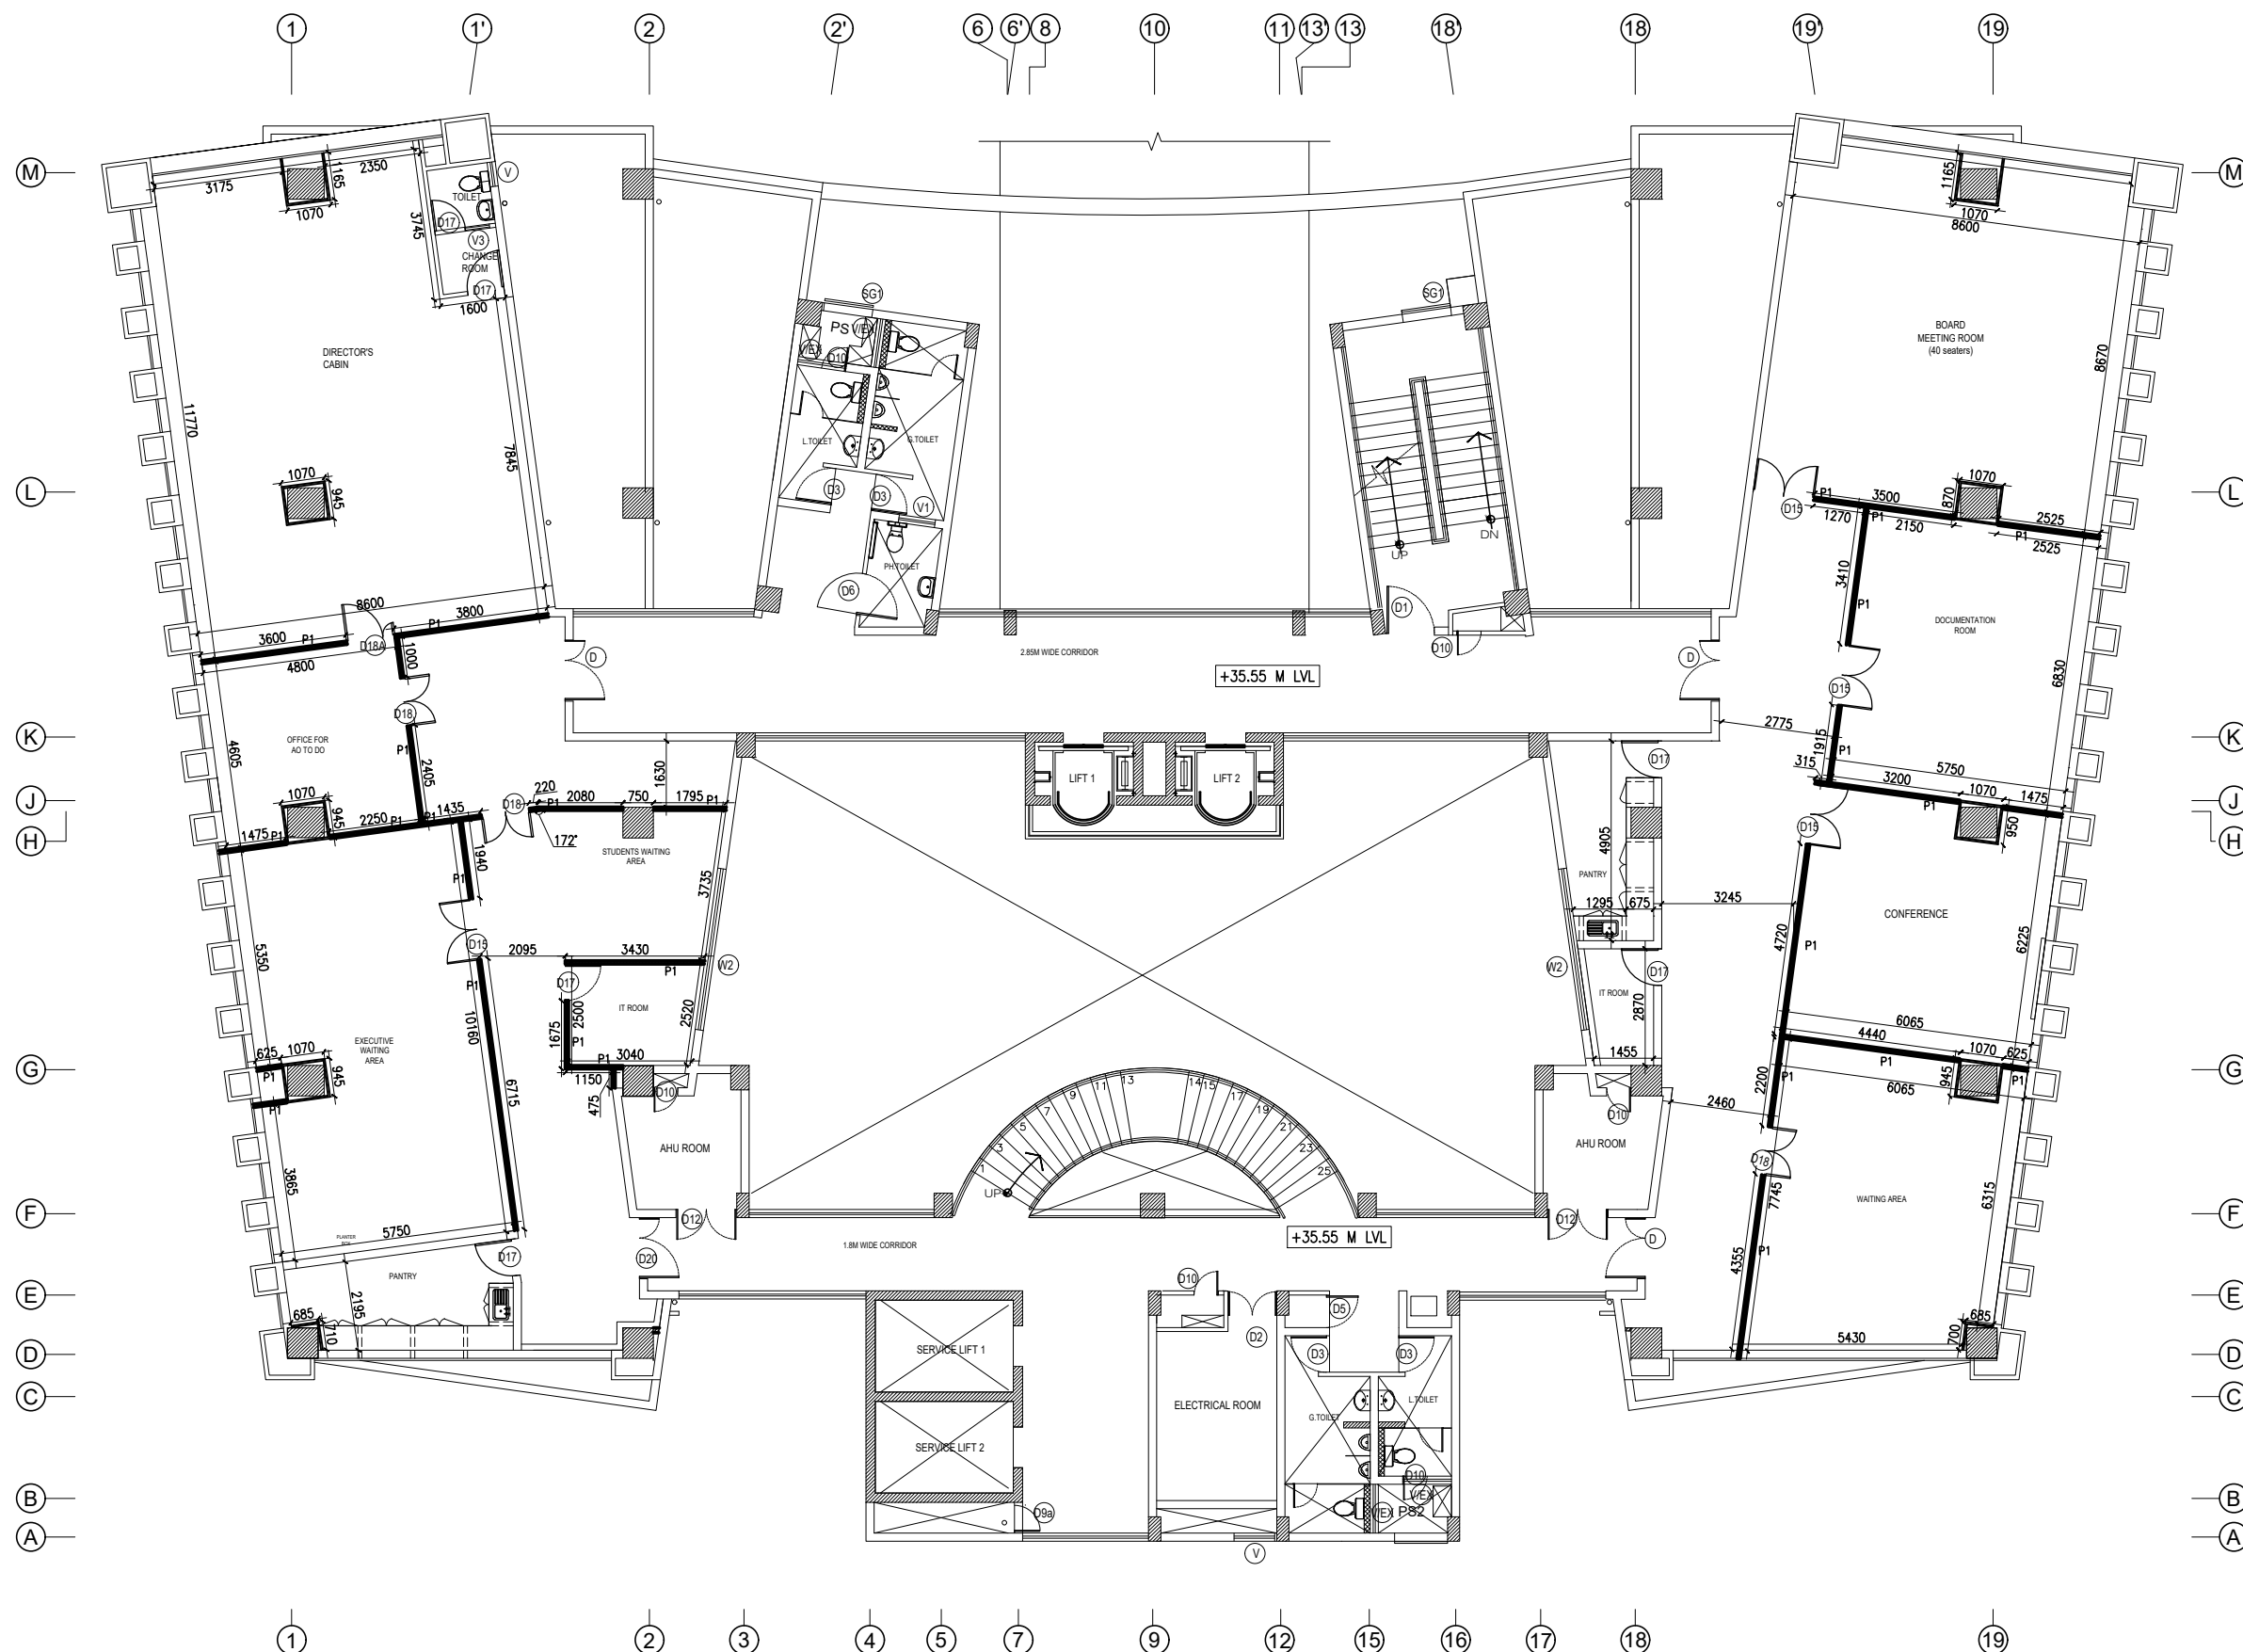

NINTH FLOOR

NOTES

1. This drawing is sole property of 'Pithavadian And Partners' and must not be reproduced or altered either in full or in part by anyone without consent from us or be passed to any individual or company not authorized by us.
2. Any discrepancy in the drawing should be brought to the immediate attention of the Architect.
3. All dimensions in millimeters and levels in meters.
4. Dimensions to be followed as indicated and not to be scaled.

REV.	DATE	DESCRIPTION	DRAWN	CHKD.
REVISIONS				
AS BUILT	*	AS BUILT		
CONSTRUCTION				
APPROVAL				
INFORMATION				
TENDER				
SCHEME				
ISSUED FOR				
NAME OF THE PROJECT: PLAN SHOWING CONSTRUCTION OF ADMINISTRATION BLOCK AT IIT INDORE				
CLIENT: IIT INDORE				
	DRAWING TITLE: NINTH FLOOR PLAN INTERIOR LAYOUT			
	STRUCTURAL CONSULTANT: ZACHARIA GEORGE F.I.E			
SCALE: 1:150 @ A3		DESIGN BY: PDG	DRAWN BY: SHREYA	CHECKED BY: PDG
DATE: 04.08.2022		SIGN:	SIGN:	SIGN:

ARCHITECTURE * INTERIORS * PLANNING * ENGINEERING * MANAGEMENT

PITHAVADIAN AND PARTNERS
Chennai • Bengaluru • Kochi • Hyderabad


10, MURUGAPPA ROAD, NAWAB GARDENS,
KOTTURPURAM, CHENNAI - 600 085
Phone : +91 (0) 44 2447 0033 / 44 166
Fax : +91 (0) 44 2447 0888/4213 2797
email : mail@paparchitect.com
website : www.paparchitect.com



DWG NO: 05-01J (SHT 10 OF 10) REV NO: 0



INSTITUTE OF CHARTERED ACCOUNTANTS OF INDIA

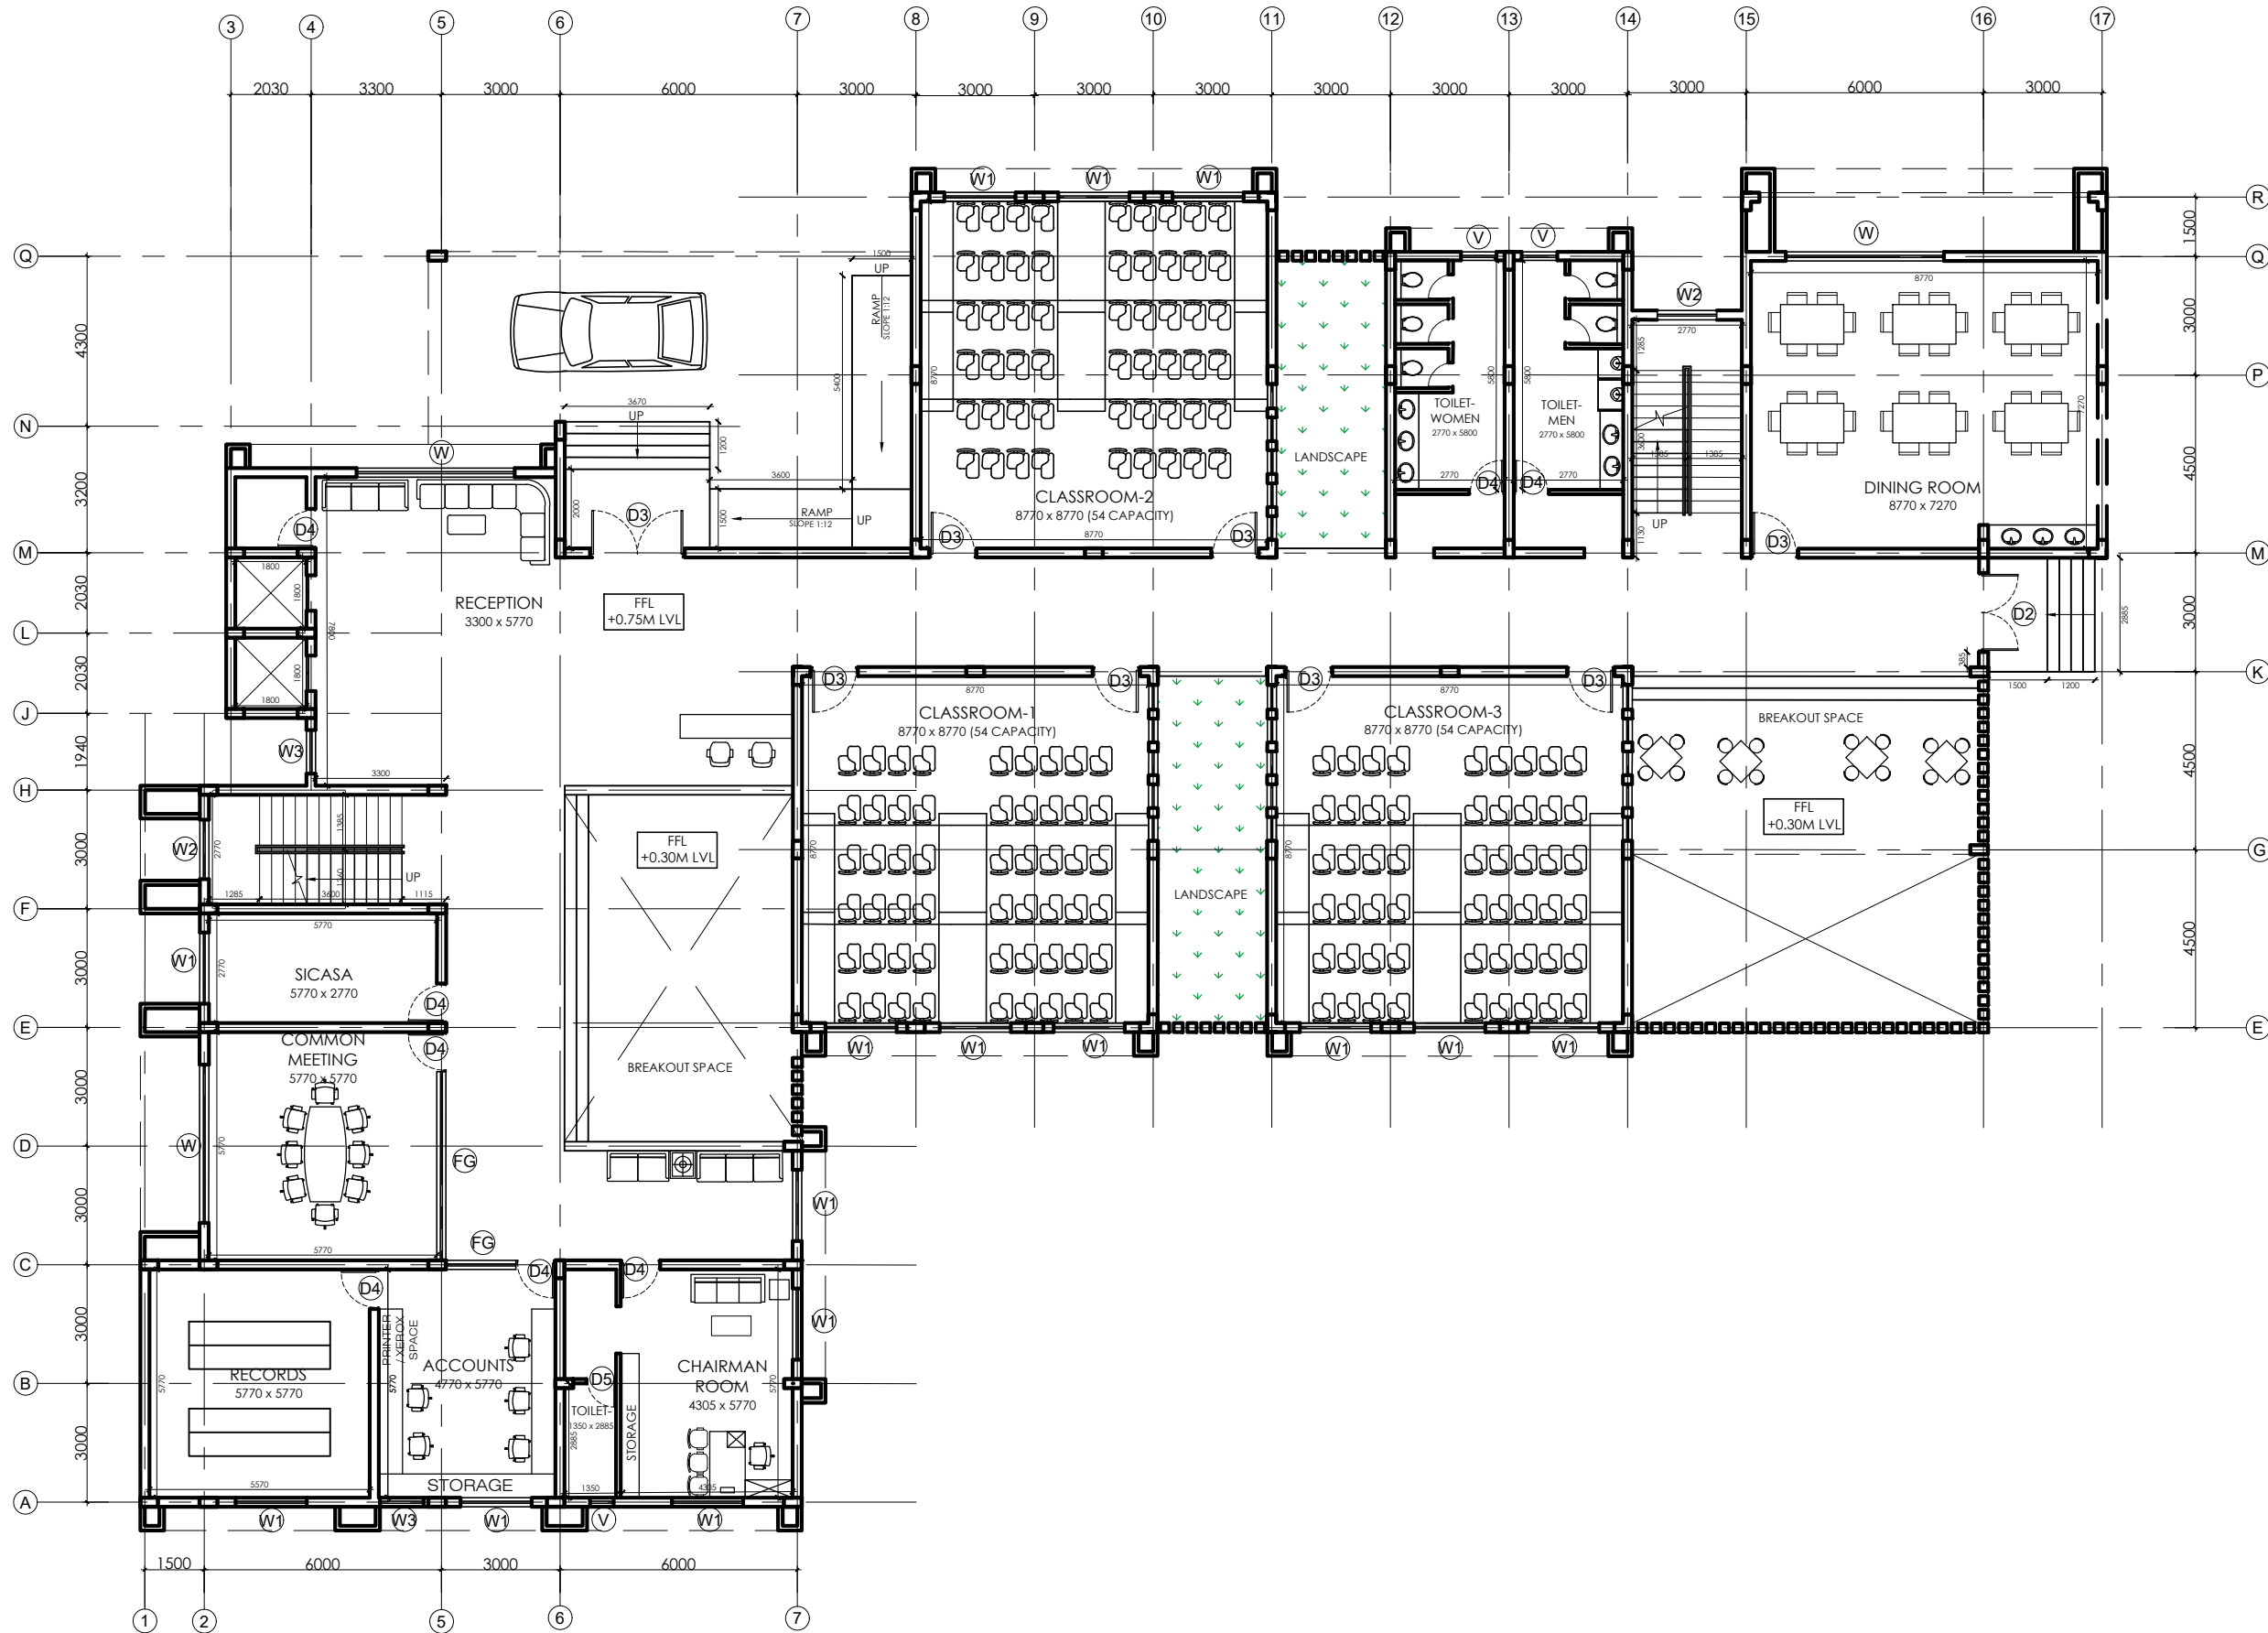

GROUND FLOOR AREA - 991.85 SQ.M.

NOTES

1. This drawing is sole property of 'Pithavadian And Partners' and must not be reproduced or altered either in full or in part by anyone without consent from us or be passed to any individual or company not authorised by us.
2. Any discrepancy in the drawing should be brought to the immediate attention of the Architect.
3. All dimensions in millimeters and levels in meters.
4. Dimensions to be followed as indicated and not to be scaled.

REV.	DATE	DESCRIPTION	DRAWN	CHKD.
------	------	-------------	-------	-------

REVISIONS				
AS BUILT				
CONSTRUCTION				
APPROVAL				
INFORMATION				
TENDER				
SCHEME	*			
ISSUED FOR				

SCHEME

NAME OF THE PROJECT:
PROPOSED CONSTRUCTION OF INSTITUTIONAL BUILDING FOR
M/S. ICAI, Chengalpattu District Branch of SIRC of ICAI

CLIENT:
M/S. INSTITUTE OF CHARTERED ACCOUNTANTS OF INDIA
Chengalpattu District Branch of SIRC of ICAI

DRAWING TITLE:
GROUND FLOOR PLAN

STRUCTURAL CONSULTANT:

ZACHARIA GEORGE F.I.E

SCALE: 1:150 @ A3	DESIGN BY: PDG	DRAWN BY: SHREYA	CHECKED BY: PDG
DATE: 30.09.2022	SIGN:	SIGN:	SIGN:

ARCHITECTURE * INTERIORS * PLANNING * ENGINEERING * MANAGEMENT


PITHAVADIAN AND PARTNERS
Chennai • Bengaluru • Kochi • Hyderabad

10, MURUGAPPA ROAD, NAWAB GARDENS,
KOTTURPURAM, CHENNAI - 600 085

Phone : +91 (0) 44 2447 0033 / 44 166
Fax : +91 (0) 44 2447 0888/4213 2797
email : mail@paparchitect.com
website : www.paparchitect.com



DWG NO: 06-01A (SHT 01 OF 02) REV NO: 0

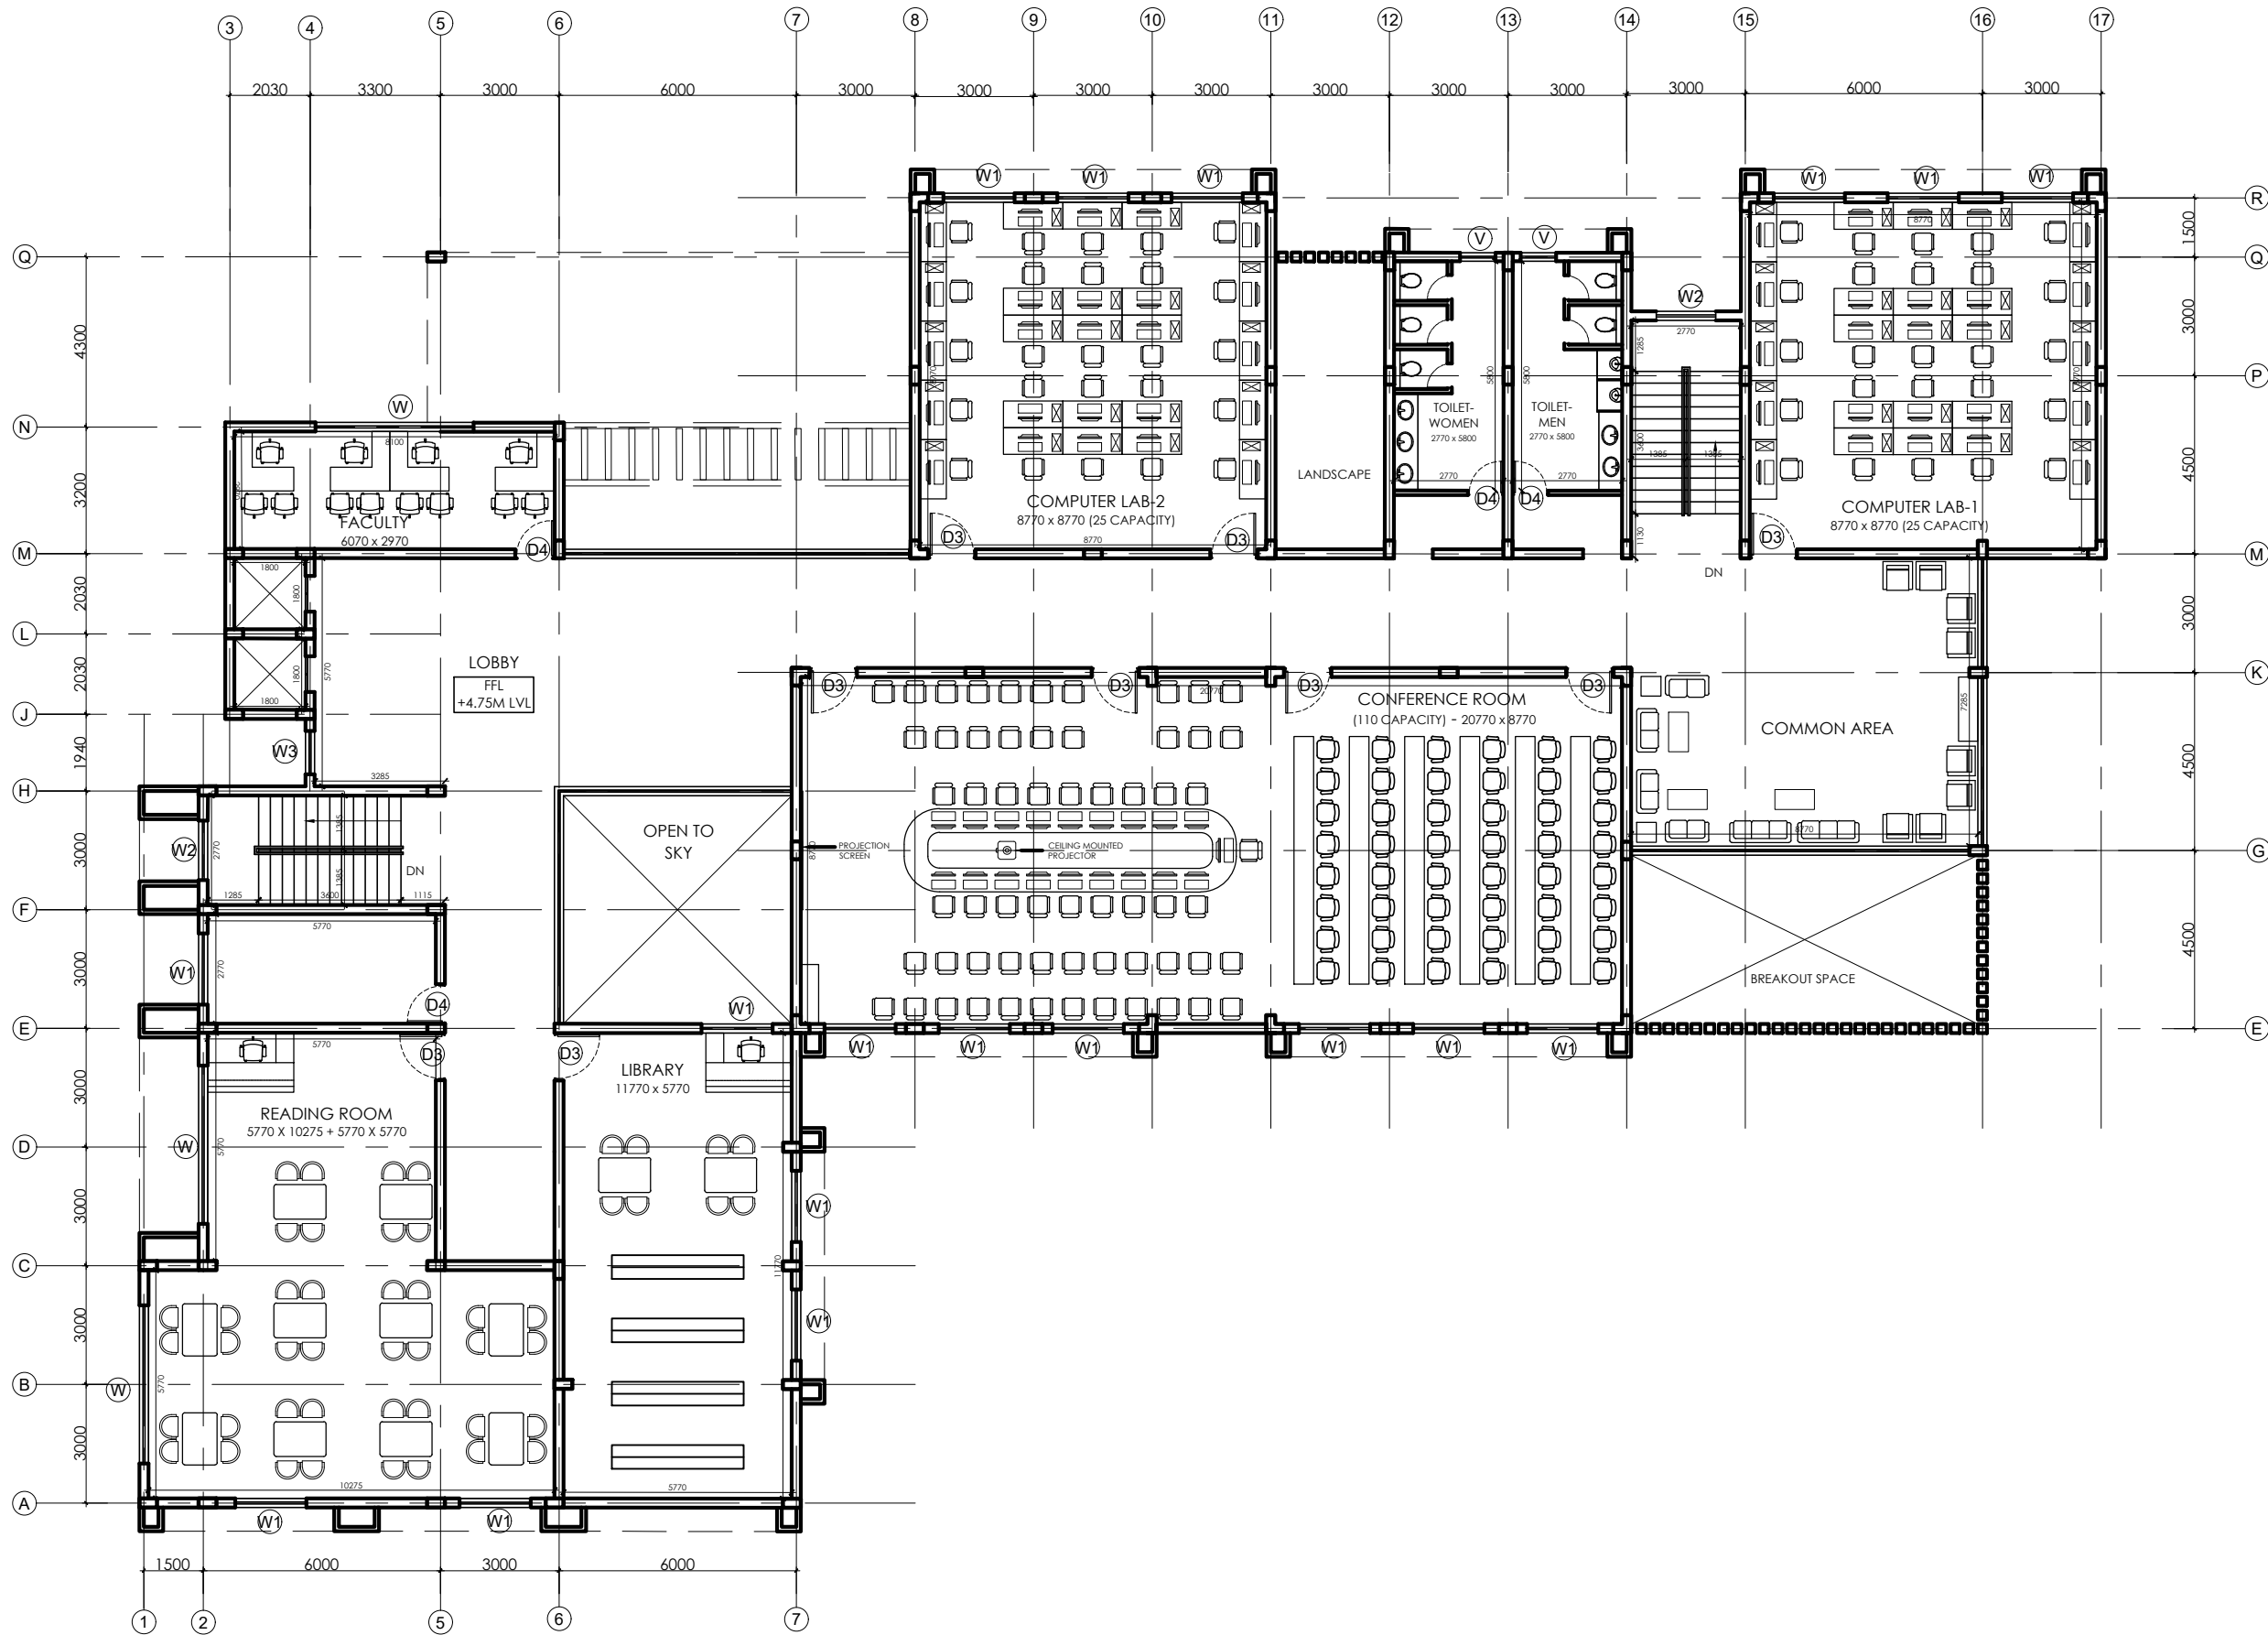

FIRST FLOOR AREA - 923.19 SQ.M.

NOTES

1. This drawing is sole property of 'Pithavadian and Partners' and must not be reproduced or altered either in full or in part by anyone without consent from us or be passed to any individual or company not authorized by us.

2. Any discrepancy in the drawing should be brought to the immediate attention of the Architect.

3. All dimensions in millimeters and levels in meters.

4. Dimensions to be followed as indicated and not to be scaled.

REV.	DATE	DESCRIPTION	DRAWN	CHKD.
AS BUILT				
CONSTRUCTION				
APPROVAL				
INFORMATION				
TENDER				
SCHEME *				
ISSUED FOR				

NAME OF THE PROJECT:

PROPOSED CONSTRUCTION OF INSTITUTIONAL BUILDING FOR M/S. ICAI, Chengalpattu District Branch of SIRC of ICAI

CLIENT:

M/S. INSTITUTE OF CHARTERED ACCOUNTANTS OF INDIA Chengalpattu District Branch of SIRC of ICAI

DRAWING TITLE:

FIRST FLOOR PLAN

STRUCTURAL CONSULTANT:

ZACHARIA GEORGE F.I.E

SCALE:	DESIGN BY:	DRAWN BY:	CHECKED BY:
1:150 @ A3	PDG	SHREYA	PDG
DATE:	SIGN:	SIGN:	SIGN:
30.09.2022			

ARCHITECTURE * INTERIORS * PLANNING * ENGINEERING * MANAGEMENT

PITHAVADIAN AND PARTNERS

Chennai • Bengaluru • Kochi • Hyderabad

10, MURUGAPPA ROAD, NAWAB GARDENS, KOTTURPURAM, CHENNAI - 600 085

Phone : +91 (0) 44 2447 0033 / 44 166


Fax : +91 (0) 44 2447 0888/4213 2797

email : mail@paparchitect.com


website : www.paparchitect.com

DWG NO: 06-01B

(SHT 02 OF 02) REV NO: 0

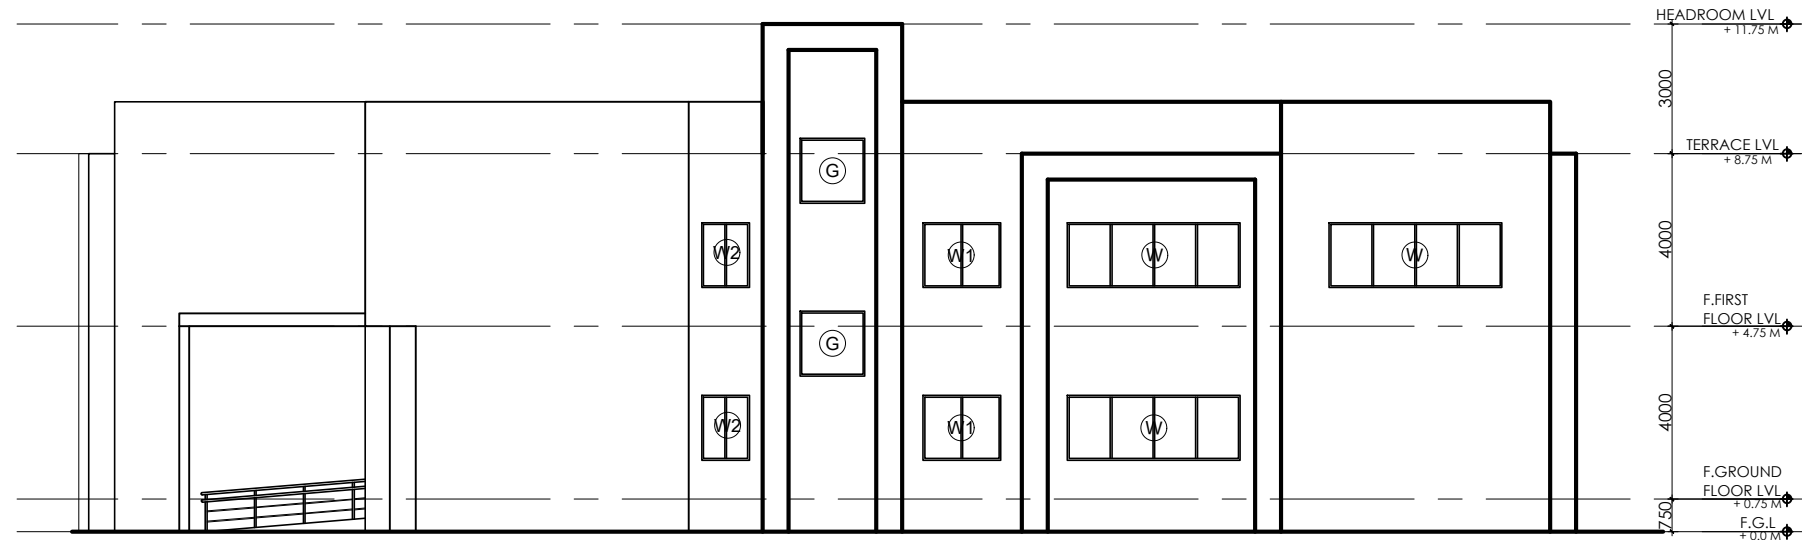

WEST ELEVATION

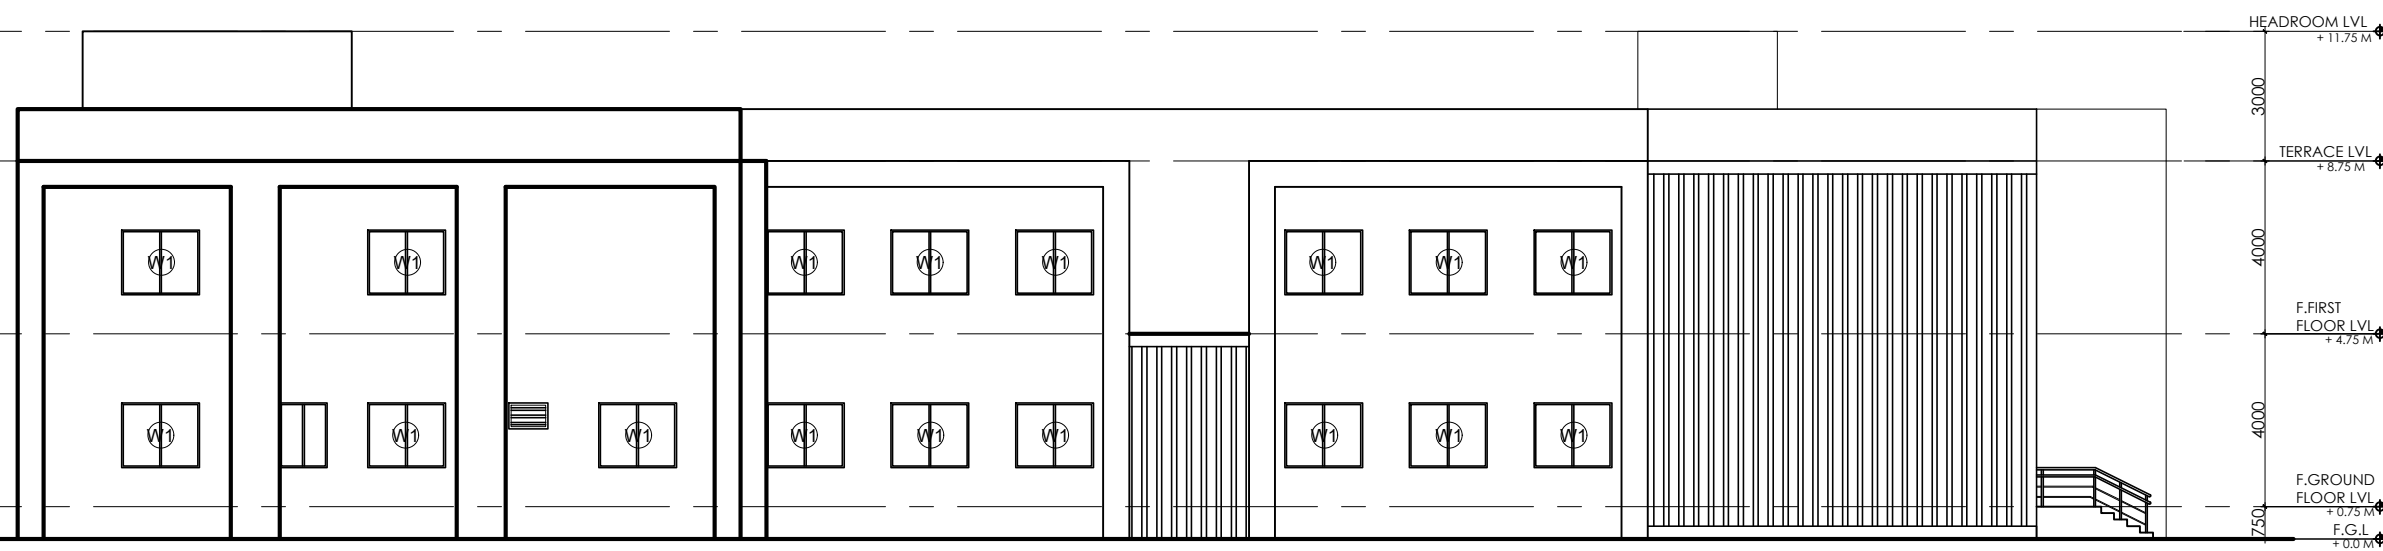

SOUTH ELEVATION


NOTES

- 1. This drawing is sole property of 'Pithavadian and Partners' and must not be reproduced or altered either in full or in part by anyone without consent from us or be passed to any individual or company not authorised by us.
- 2. Any discrepancy in the drawing should be brought to the immediate attention of the Architect.
- 3. All dimensions in millimeters and levels in meters.
- 4. Dimensions to be followed as indicated and not to be scaled.


REV.	DATE	DESCRIPTION	DRAWN	CHKD.
REVISIONS				
AS BUILT		SCHEME		
CONSTRUCTION				
APPROVAL				
INFORMATION				
TENDER				
SCHEME		*		
ISSUED FOR				
NAME OF THE PROJECT: PROPOSED CONSTRUCTION OF INSTITUTIONAL BUILDING FOR M/S. ICAI, Chengalpattu District Branch of SIRC of ICAI				
CLIENT: M/S. INSTITUTE OF CHARTERED ACCOUNTANTS OF INDIA Chengalpattu District Branch of SIRC of ICAI				
DRAWING TITLE: ELEVATIONS-1		STRUCTURAL CONSULTANT: ZACHARIA GEORGE F.I.E		
SCALE: 1:150 @ A3	DESIGN BY: PDG	DRAWN BY: SHREYA	CHECKED BY: PDG	
DATE: 30.09.2022	SIGN:	SIGN:	SIGN:	
ARCHITECTURE * INTERIORS * PLANNING * ENGINEERING * MANAGEMENT				
PITHAVADIAN AND PARTNERS Chennai • Bengaluru • Kochi • Hyderabad 10, MURUGAPPA ROAD, NAWAB GARDENS, KOTTURPURAM, CHENNAI - 600 085 Phone : +91 (0) 44 2447 0033 / 44 166 Fax : +91 (0) 44 2447 0888/4213 2797 email : mail@paparchitect.com website : www.paparchitect.com				
DWG NO: 06-02A		(SHT 01 OF 02) REV NO: 0		

NOTES


1. This drawing is sole property of 'Pithavadian and Partners' and must not be reproduced or altered either in full or in part by anyone without consent from us or be passed to any individual or company not authorised by us.
2. Any discrepancy in the drawing should be brought to the immediate attention of the Architect.
3. All dimensions in millimeters and levels in meters.
4. Dimensions to be followed as indicated and not to be scaled.

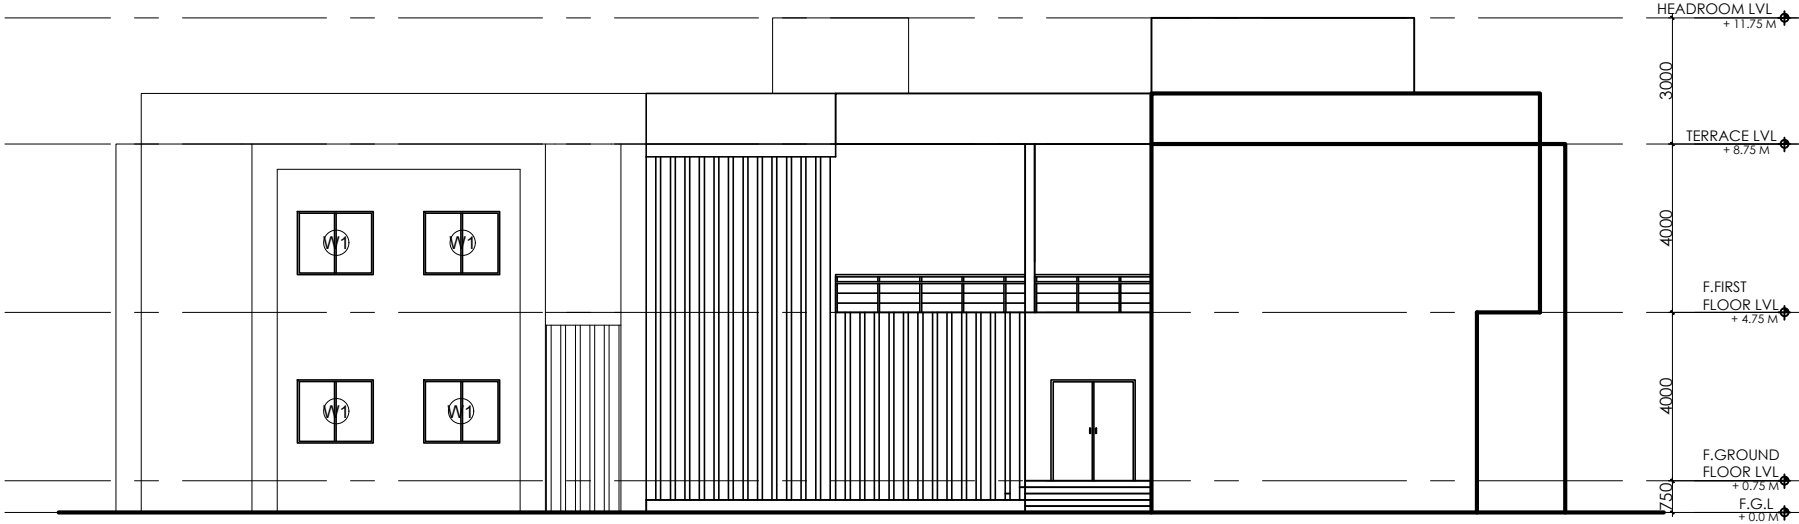


EAST ELEVATION

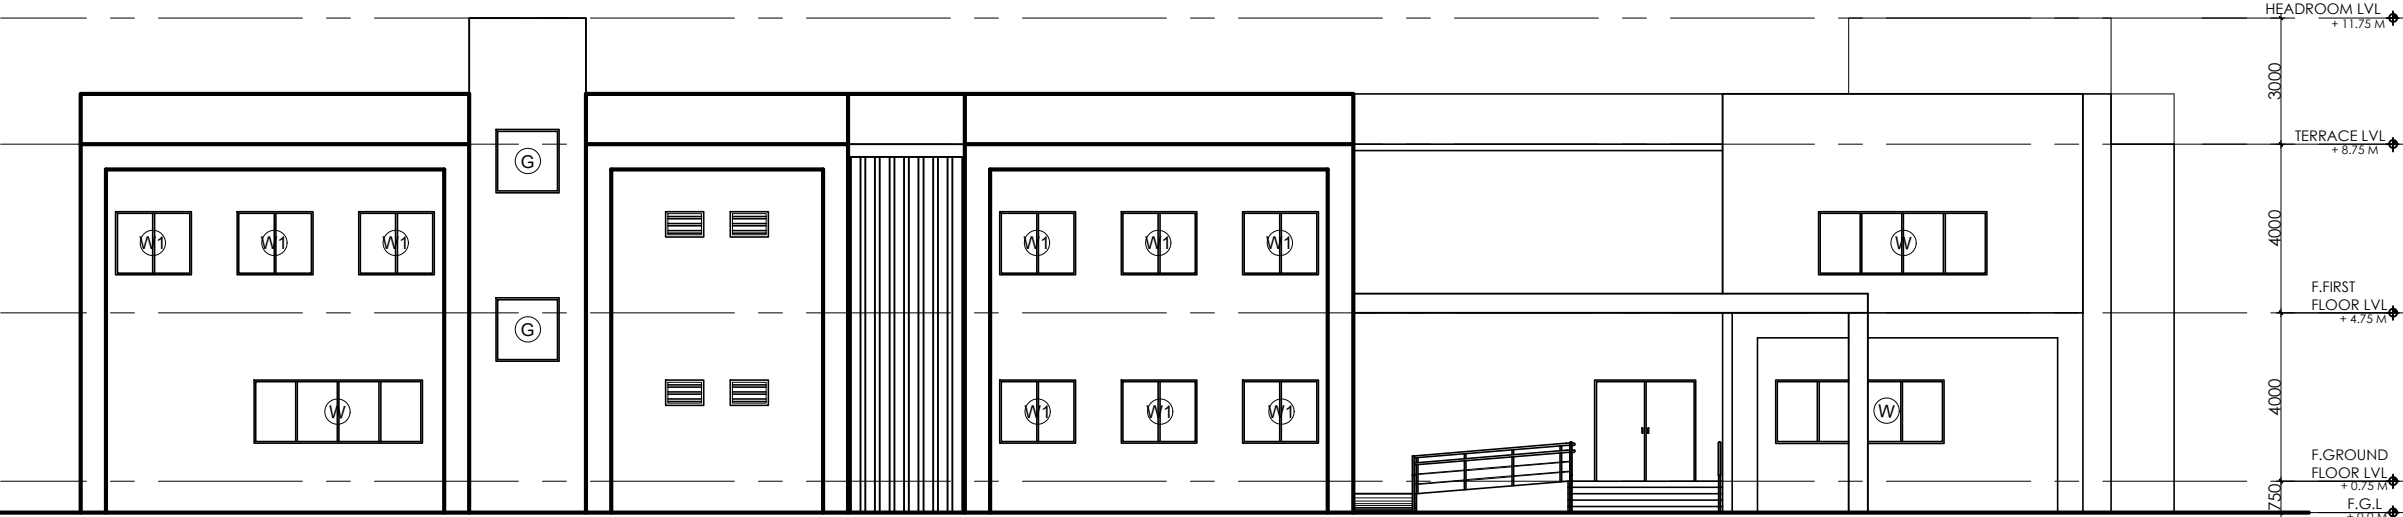








NORTH ELEVATION

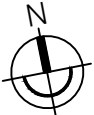REV.	DATE	DESCRIPTION	DRAWN	CHKD.
REVISIONS				
AS BUILT		SCHEME		
CONSTRUCTION				
APPROVAL				
INFORMATION				
TENDER				
SCHEME	*			
ISSUED FOR				
NAME OF THE PROJECT:				
PROPOSED CONSTRUCTION OF INSTITUTIONAL BUILDING FOR M/S. ICAI, Chengalpattu District Branch of SIRC of ICAI				
CLIENT:				
M/S. INSTITUTE OF CHARTERED ACCOUNTANTS OF INDIA Chengalpattu District Branch of SIRC of ICAI				
		DRAWING TITLE:		
		ELEVATIONS - 2		
		STRUCTURAL CONSULTANT:		
		ZACHARIA GEORGE F.I.E		
SCALE:	DESIGN BY:	DRAWN BY:	CHECKED BY:	
1:150 @ A3	PDG	SHREYA	PDG	
DATE:	SIGN:	SIGN:	SIGN:	
30.09.2022				
ARCHITECTURE * INTERIORS * PLANNING * ENGINEERING * MANAGEMENT				
PITHAVADIAN AND PARTNERS				
Chennai ▪ Bengaluru ▪ Kochi ▪ Hyderabad				
10, MURUGAPPA ROAD, NAWAB GARDENS, KOTTURPURAM, CHENNAI - 600 085				
Phone	: +91 (0) 44 2447 0033 / 44 /66			
Fax	: +91 (0) 44 2447 0888/4213 2797			
email	: mail@paparchitect.com			
website	: www.paparchitect.com			
DWG NO: 06-02B		(SHT 02 OF 02)		REV NO: 0



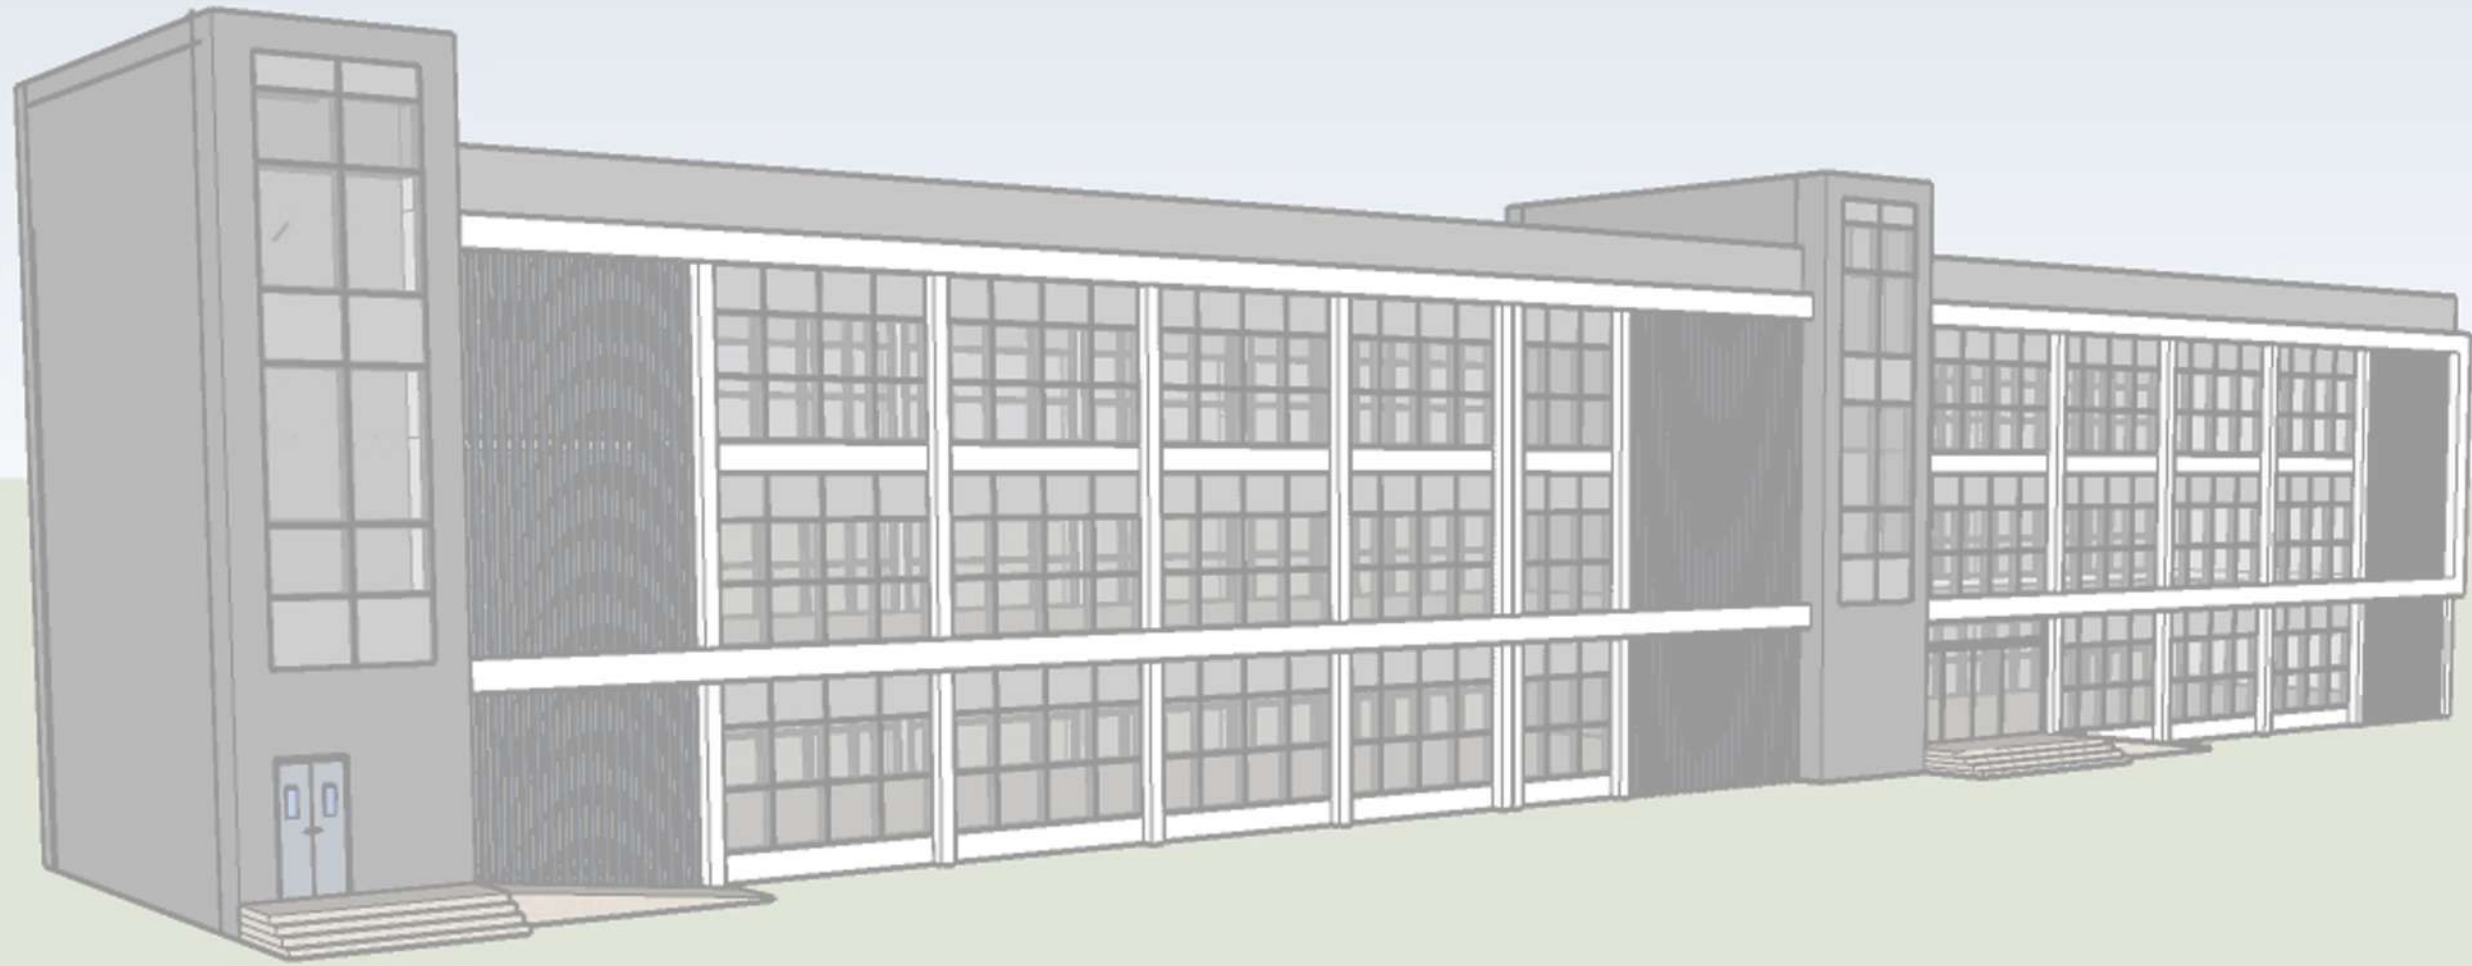

FREUDENBERG REGIONAL CORPORATE CENTER INDIA PVT. LTD.

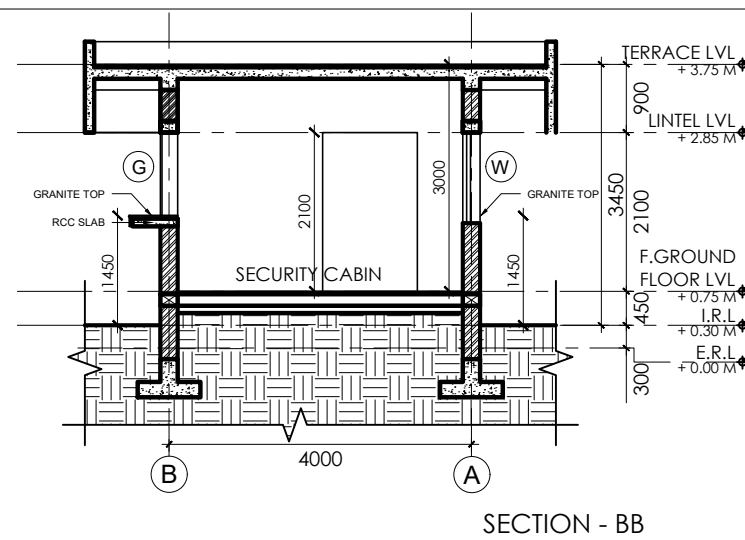
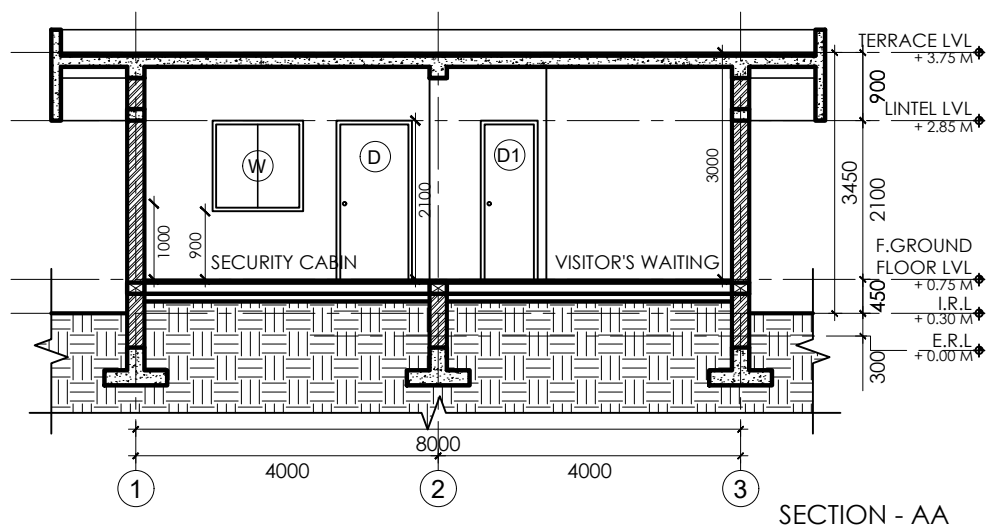
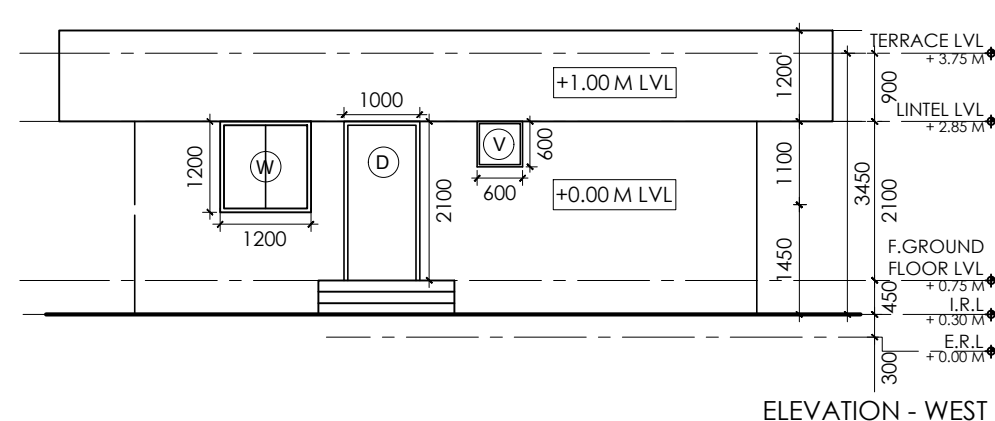
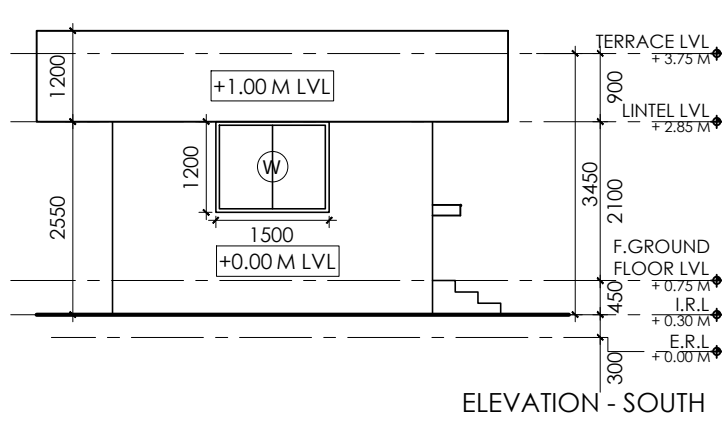
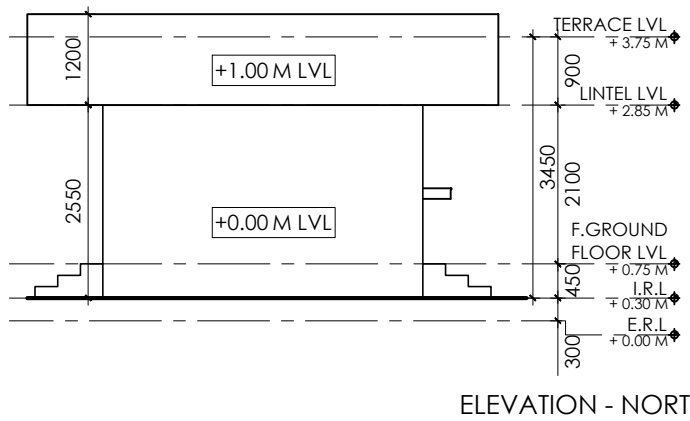
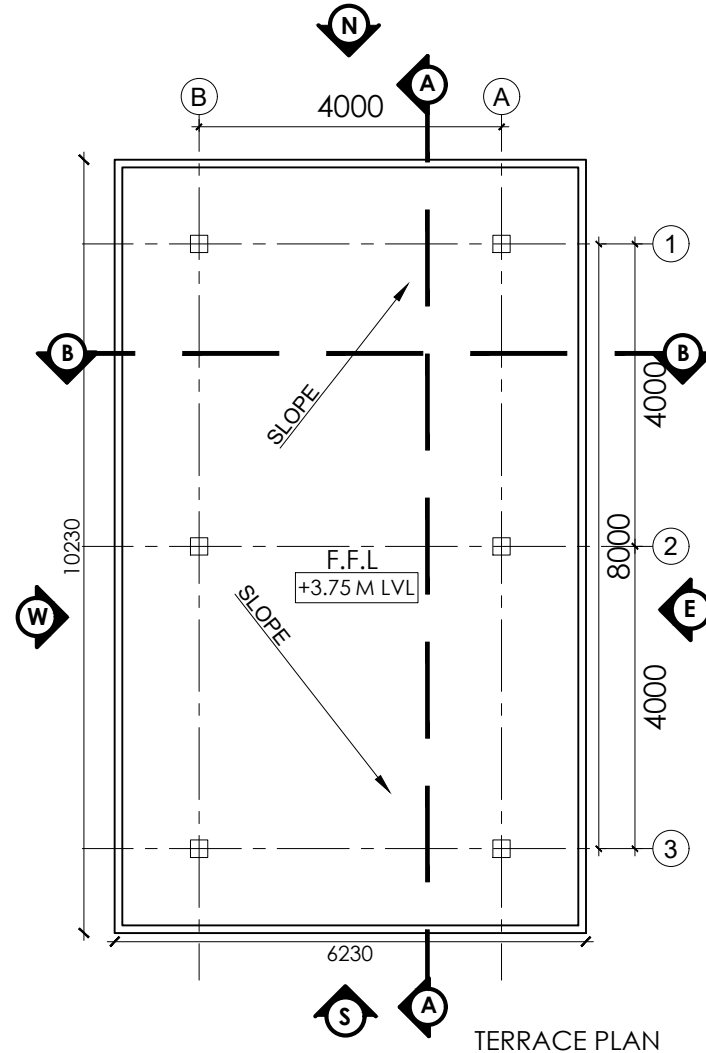
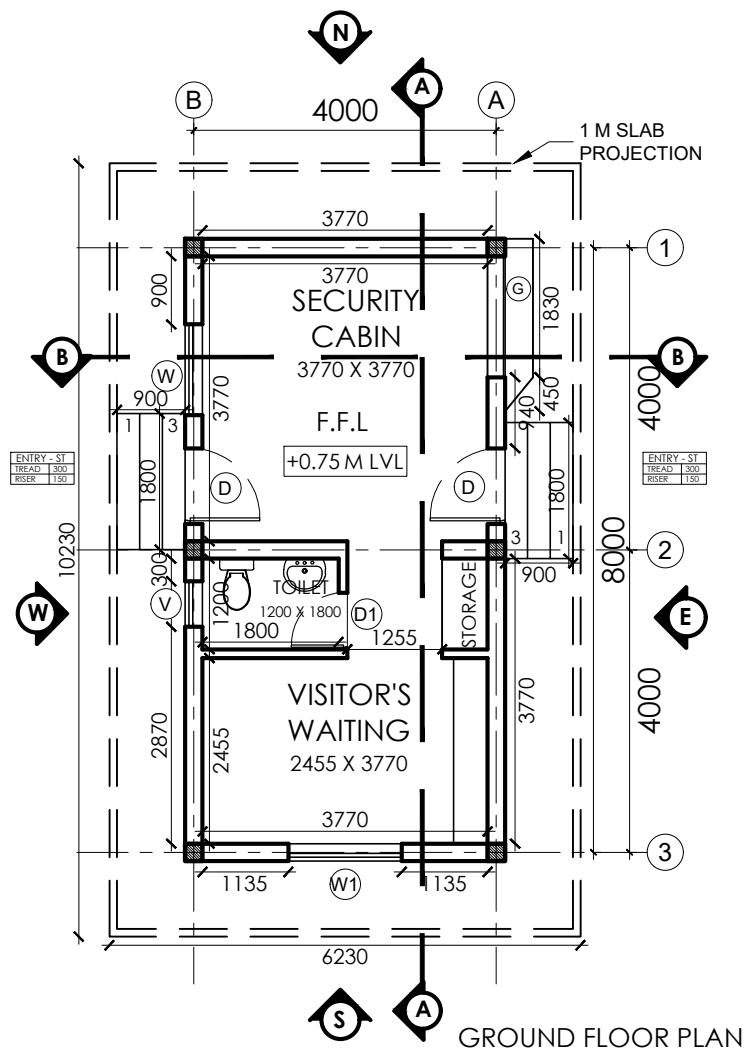


- NOTES
1. This drawing is sole property of 'Pithavadian and Partners' and must not be reproduced or altered either in full or in part by anyone without consent from us or be passed to any individual or company not authorised by us.
 2. Any discrepancy in the drawing should be brought to the immediate attention of the Architect.
 3. All dimensions in millimeters and levels in meters.
 4. Dimensions to be followed as indicated and not to be scaled.

REV.	DATE	DESCRIPTION	DRAWN	CHKD.
REVISIONS				
AS BUILT		INFORMATION		
CONSTRUCTION				
APPROVAL				
INFORMATION	*			
TENDER				
SCHEME				
ISSUED FOR				
NAME OF THE PROJECT:				
PROPOSED M/S. FREUDENBERG REGIONAL CORPORATE CENTER INDIA PVT. LTD (FRCCI) UNIT 1, BARI MARUALI AND RAMGARH ALIAS MANDA MORINDA TEHSIL, PUNJAB.				
CLIENT:				
FRCCI FREUDENBERG REGIONAL CORPORATE CENTER INDIA PVT. LTD.				
	DRAWING TITLE:			
	UNIT 1 - SECURITY CABIN - MAIN GATE FLOOR PLANS, ELEVATIONS AND SECTIONS			
	STRUCTURAL CONSULTANT:			
	ZACHARIA GEORGE F.I.E			
SCALE:	DESIGN BY:	DRAWN BY:	CHECKED BY:	
1:100 @ A3	PDG	SHREYA	PDG	
DATE:	SIGN:	SIGN:	SIGN:	
01.09.2022				
ARCHITECTURE * INTERIORS * PLANNING * ENGINEERING * MANAGEMENT				
PITHAVADIAN AND PARTNERS				
Chennai • Bengaluru • Kochi • Hyderabad				
10, MURUGAPPA ROAD, NAWAB GARDENS, KOTTURPURAM, CHENNAI - 600 085				
Phone : +91 (0) 44 2447 0033 / 44 166				
Fax : +91 (0) 44 2447 0888/4213 2797				
email : mail@paparchitect.com				
website : www.paparchitect.com				
				
DWG NO: 07-01		(SHT 01 OF 01)	REV NO: 0	

NOTES

1. This drawing is sole property of 'Pithavadian and Partners' and must not be reproduced or altered either in full or in part by anyone without consent from us or be passed to any individual or company not authorised by us.
2. Any discrepancy in the drawing should be brought to the immediate attention of the Architect.
3. All dimensions in millimeters and levels in meters.
4. Dimensions to be followed as indicated and not to be scaled.

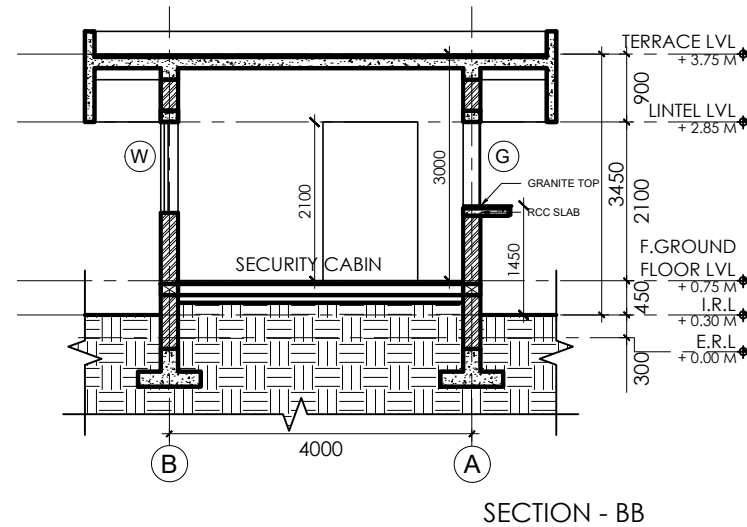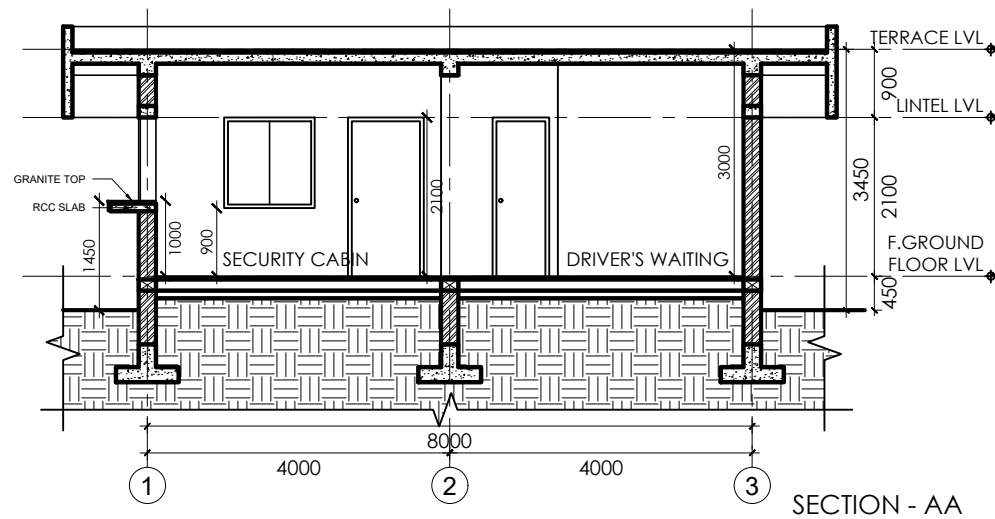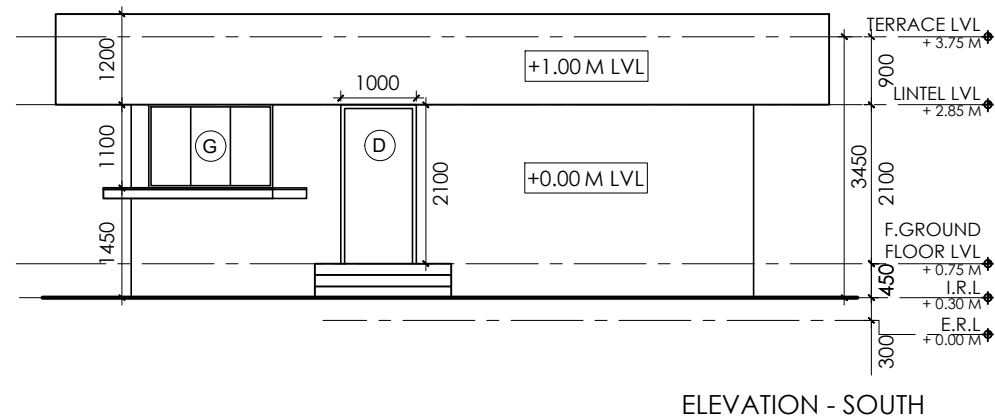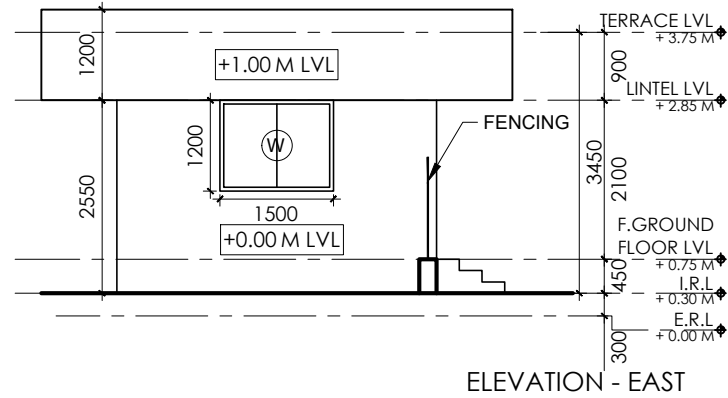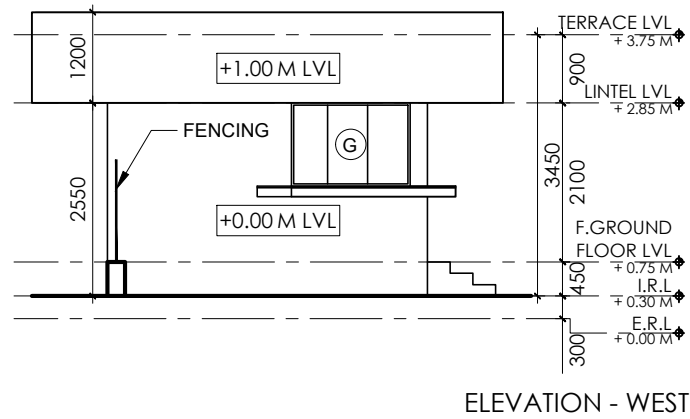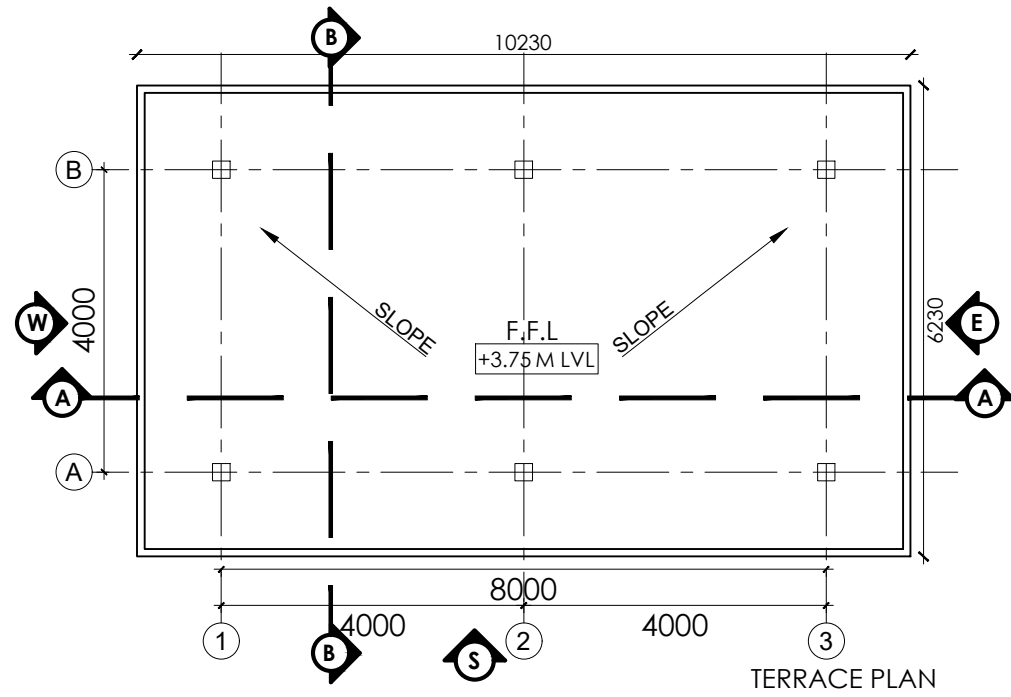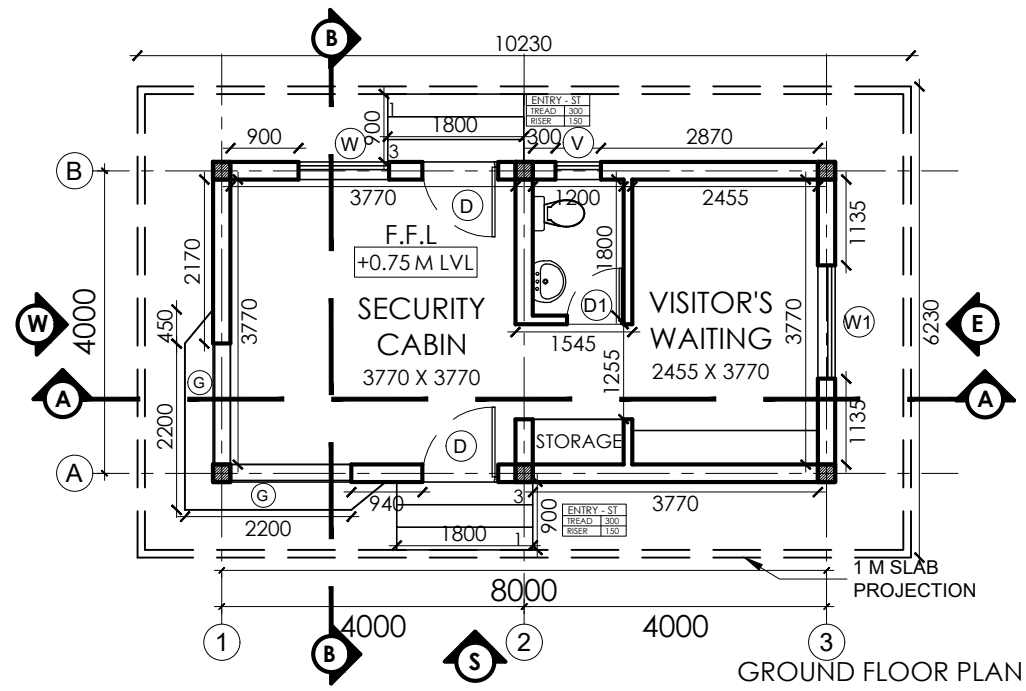

REV.	DATE	DESCRIPTION	DRAWN	CHKD.
------	------	-------------	-------	-------

REVISIONS				
AS BUILT				
CONSTRUCTION				
APPROVAL				
INFORMATION	*			
TENDER				
SCHEME				
ISSUED FOR				

INFORMATION

NAME OF THE PROJECT:
PROPOSED M/S. FREUDENBERG REGIONAL CORPORATE CENTER INDIA PVT. LTD (FRCCI) UNIT 1&2, BARI MARUALI AND RAMGARH ALIAS MANDA MORINDA TEHSIL, PUNJAB.

CLIENT:
FRCCI
FREUDENBERG REGIONAL CORPORATE CENTER INDIA PVT. LTD.

DRAWING TITLE:
UNIT 1 & 2 - SECURITY CABIN - TRUCK PARKING
FLOOR PLANS, ELEVATIONS AND SECTIONS

STRUCTURAL CONSULTANT:
ZACHARIA GEORGE F.I.E


SCALE: 1:100 @ A3	DESIGN BY: PDG	DRAWN BY: SHREYA	CHECKED BY: PDG
DATE: 29.08.2022	SIGN:	SIGN:	SIGN:

ARCHITECTURE * INTERIORS * PLANNING * ENGINEERING * MANAGEMENT


PITHAVADIAN AND PARTNERS
Chennai • Bengaluru • Kochi • Hyderabad
10, MURUGAPPA ROAD, NAWAB GARDENS,
KOTTURPURAM, CHENNAI - 600 085
Phone : +91 (0) 44 2447 0033 / 44 166
Fax : +91 (0) 44 2447 0888 / 4213 2797
email : mail@paparchitect.com
website : www.paparchitect.com




DWG NO: 07-02 (SHT 01 OF 01) REV NO: 0

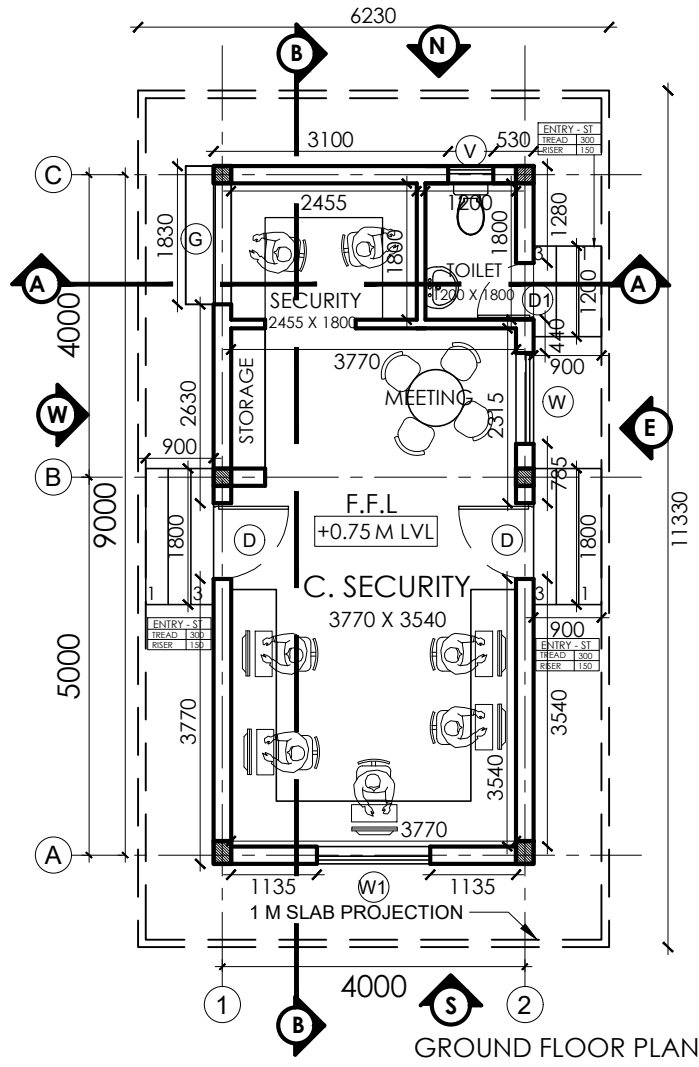


GROUND FLOOR PLAN

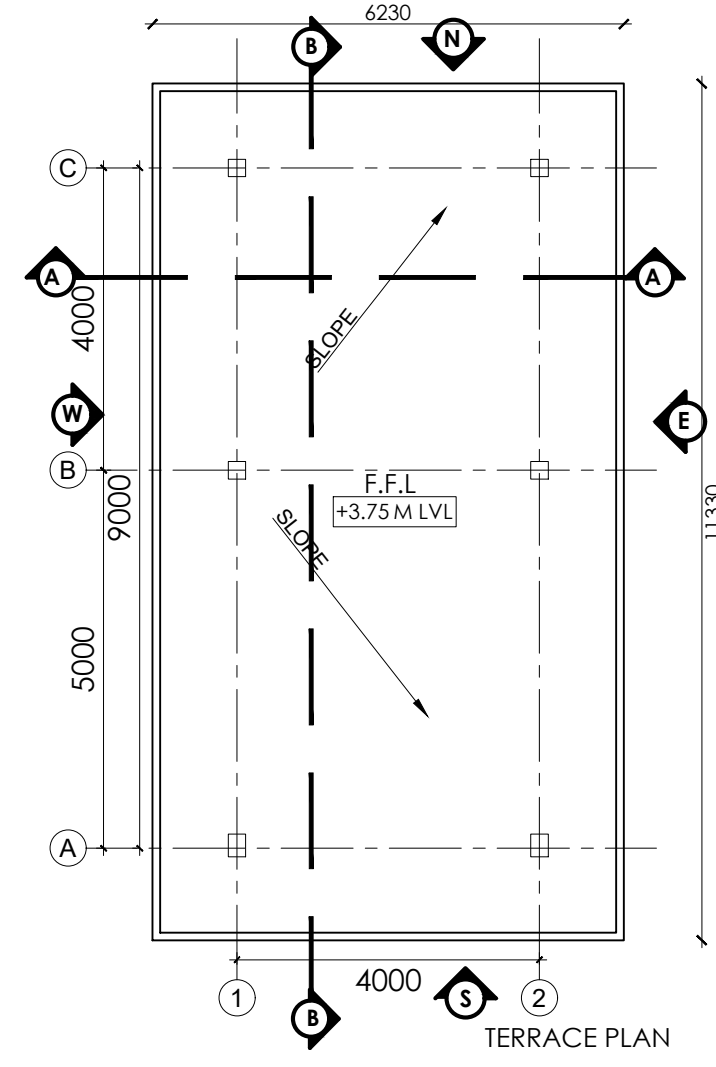


TERRACE PLAN

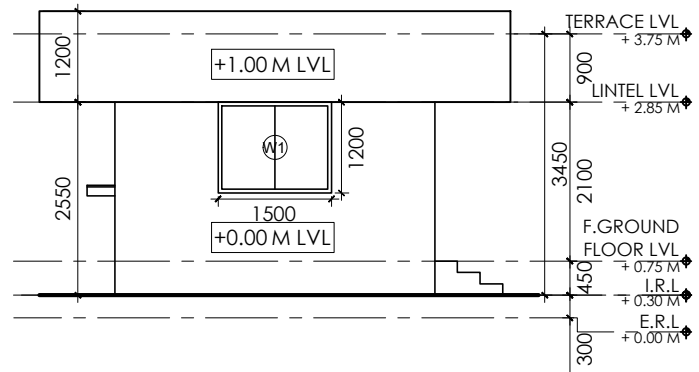


ELEVATION - SOUTH

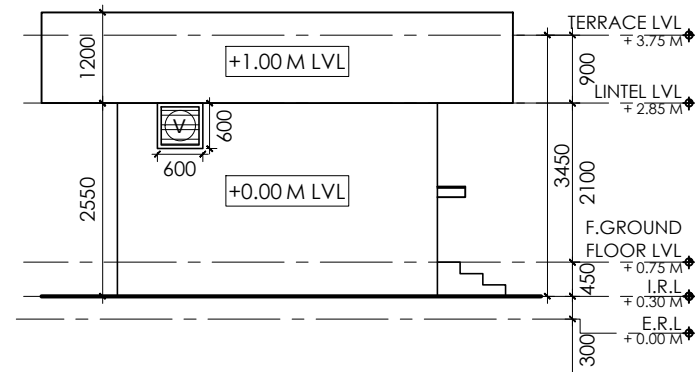


ELEVATION - NORTH

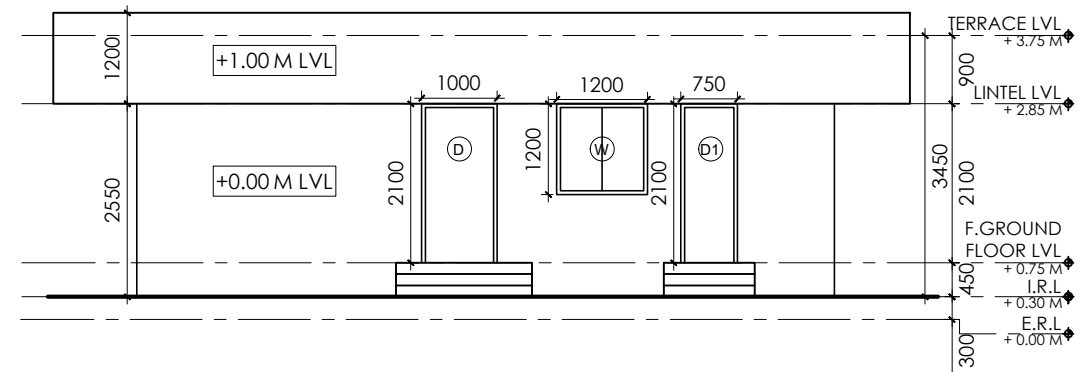

ELEVATION - EAST

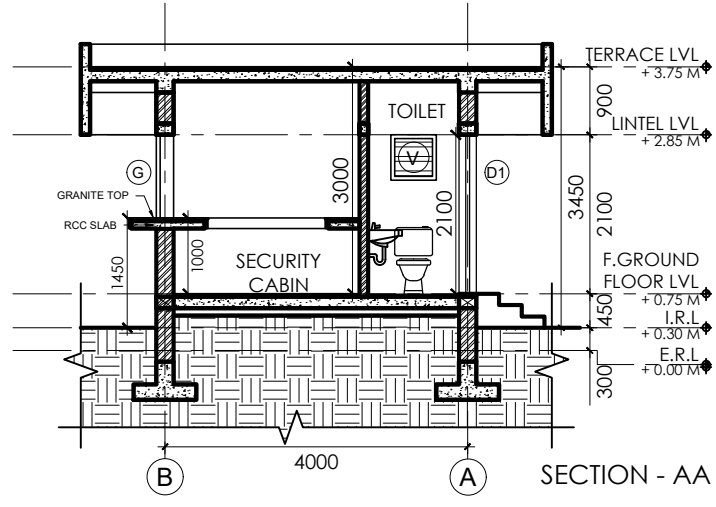

SECTION - AA

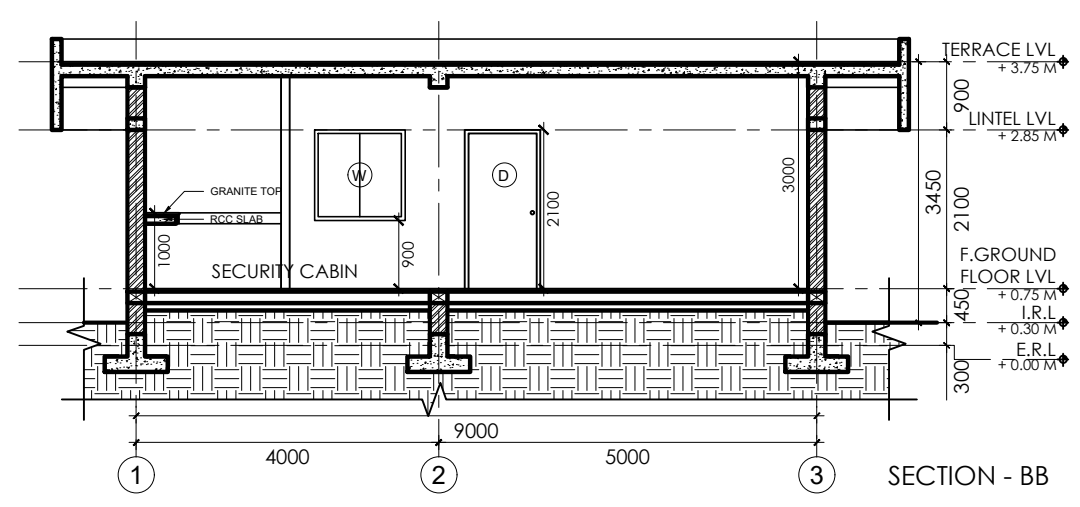

SECTION - BB

NOTES

1. This drawing is sole property of 'Pithavadian and Partners' and must not be reproduced or altered either in full or in part by anyone without consent from us or be passed to any individual or company not authorised by us.

2. Any discrepancy in the drawing should be brought to the immediate attention of the Architect.

3. All dimensions in millimeters and levels in meters.

4. Dimensions to be followed as indicated and not to be scaled.

REV.	DATE	DESCRIPTION	DRAWN	CHKD.
AS BUILT				
CONSTRUCTION				
APPROVAL				
INFORMATION				
TENDER				
SCHEME				
ISSUED FOR				

NAME OF THE PROJECT:

PROPOSED M/S. FREUDENBERG REGIONAL CORPORATE CENTER INDIA PVT. LTD (FRCCI) UNIT 1&2, BARI MARUALI AND RAMGARH ALIAS MANDA MORINDA TEHSIL, PUNJAB.

CLIENT:

FRCCI
FREUDENBERG REGIONAL CORPORATE CENTER INDIA PVT. LTD.

DRAWING TITLE:

UNIT 1 & 2 - SECURITY CABIN - STAFF ENTRY
FLOOR PLANS, ELEVATIONS AND SECTIONS

STRUCTURAL CONSULTANT:

ZACHARIA GEORGE F.I.E

SCALE:	DESIGN BY:	DRAWN BY:	CHECKED BY:
1:100 @ A3	PDG	SHREYA	PDG
DATE:	SIGN:	SIGN:	SIGN:
29.08.2022			

ARCHITECTURE * INTERIORS * PLANNING * ENGINEERING * MANAGEMENT

PITHAVADIAN AND PARTNERS

Chennai • Bengaluru • Kochi • Hyderabad

10, MURUGAPPA ROAD, NAWAB GARDENS,
KOTTURPURAM, CHENNAI - 600 085

Phone : +91 (0) 44 2447 0033 / 44 166

Fax : +91 (0) 44 2447 0888/4213 2797


email : mail@paparchitect.com

website : www.paparchitect.com


PNP

10


DWG NO: 07-03 (SHT 01 OF 01) REV NO: 0

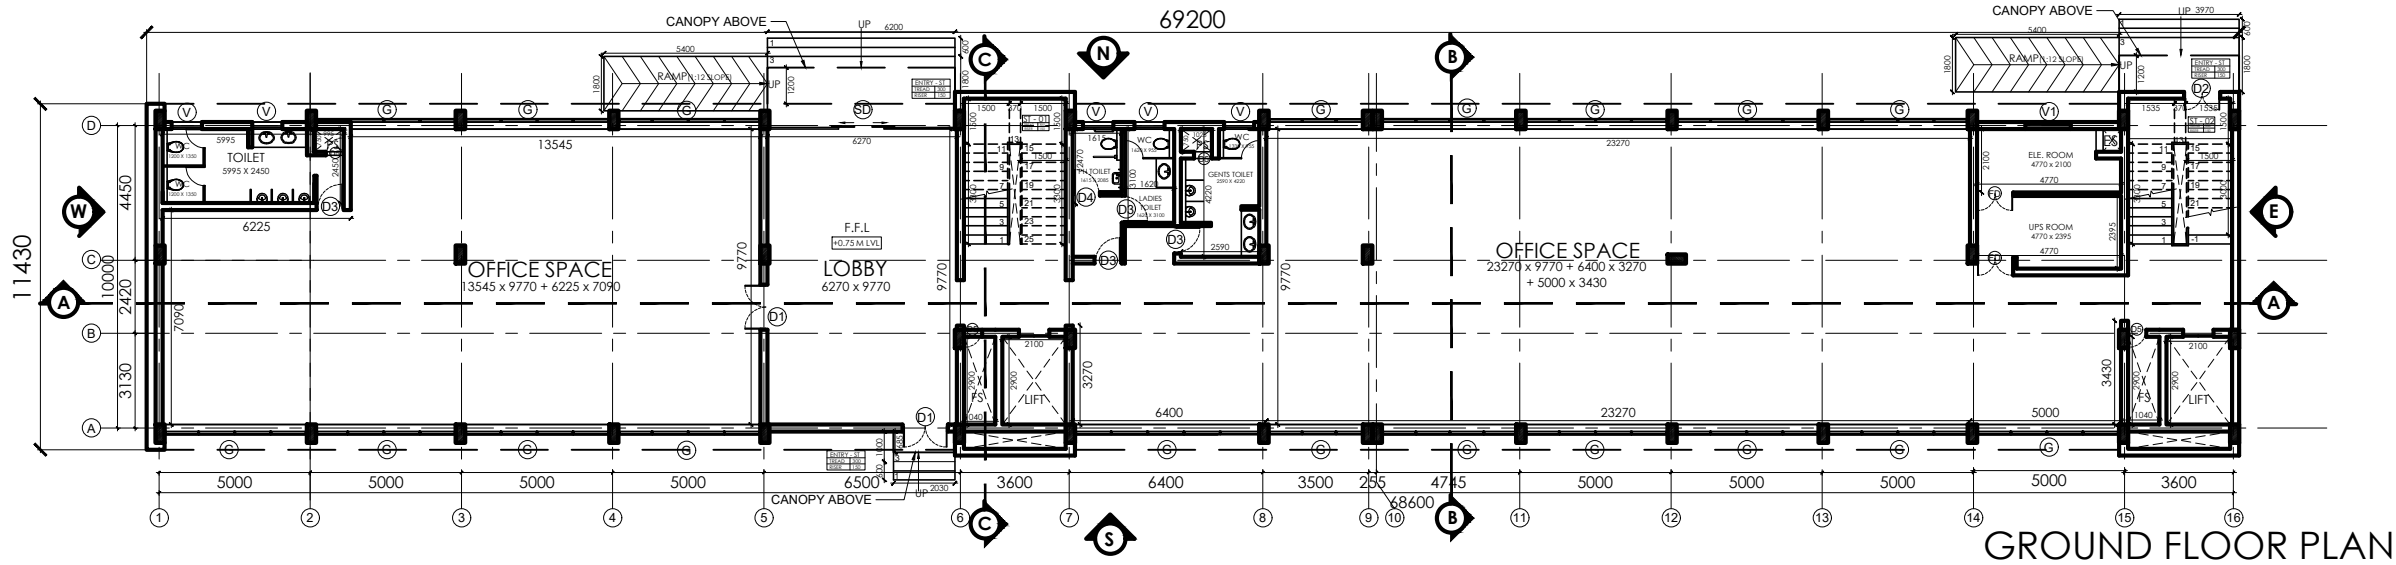


GROUND FLOOR PLAN

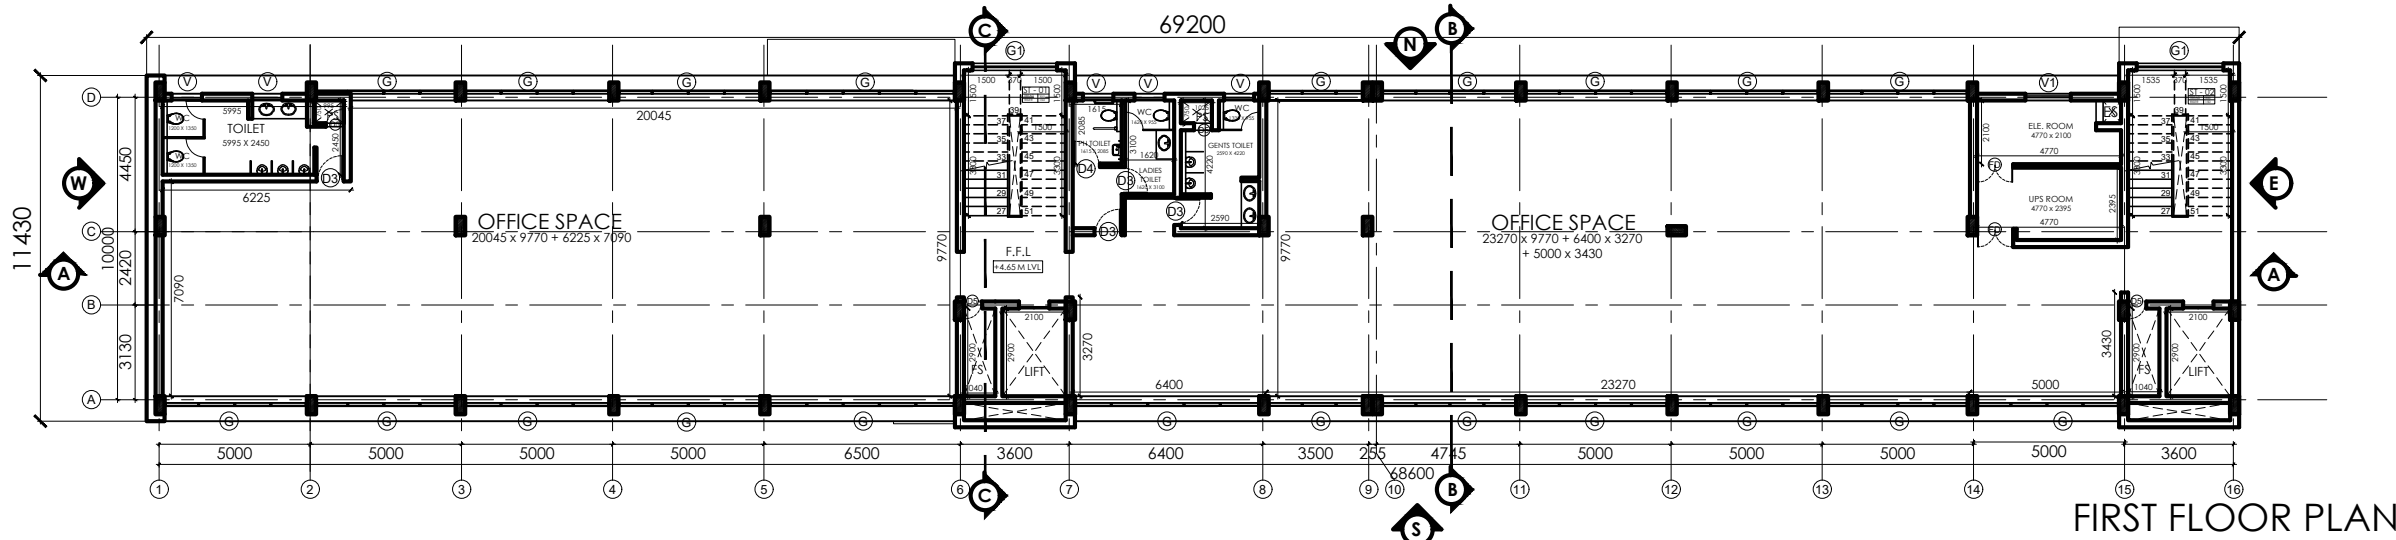

FIRST FLOOR PLAN

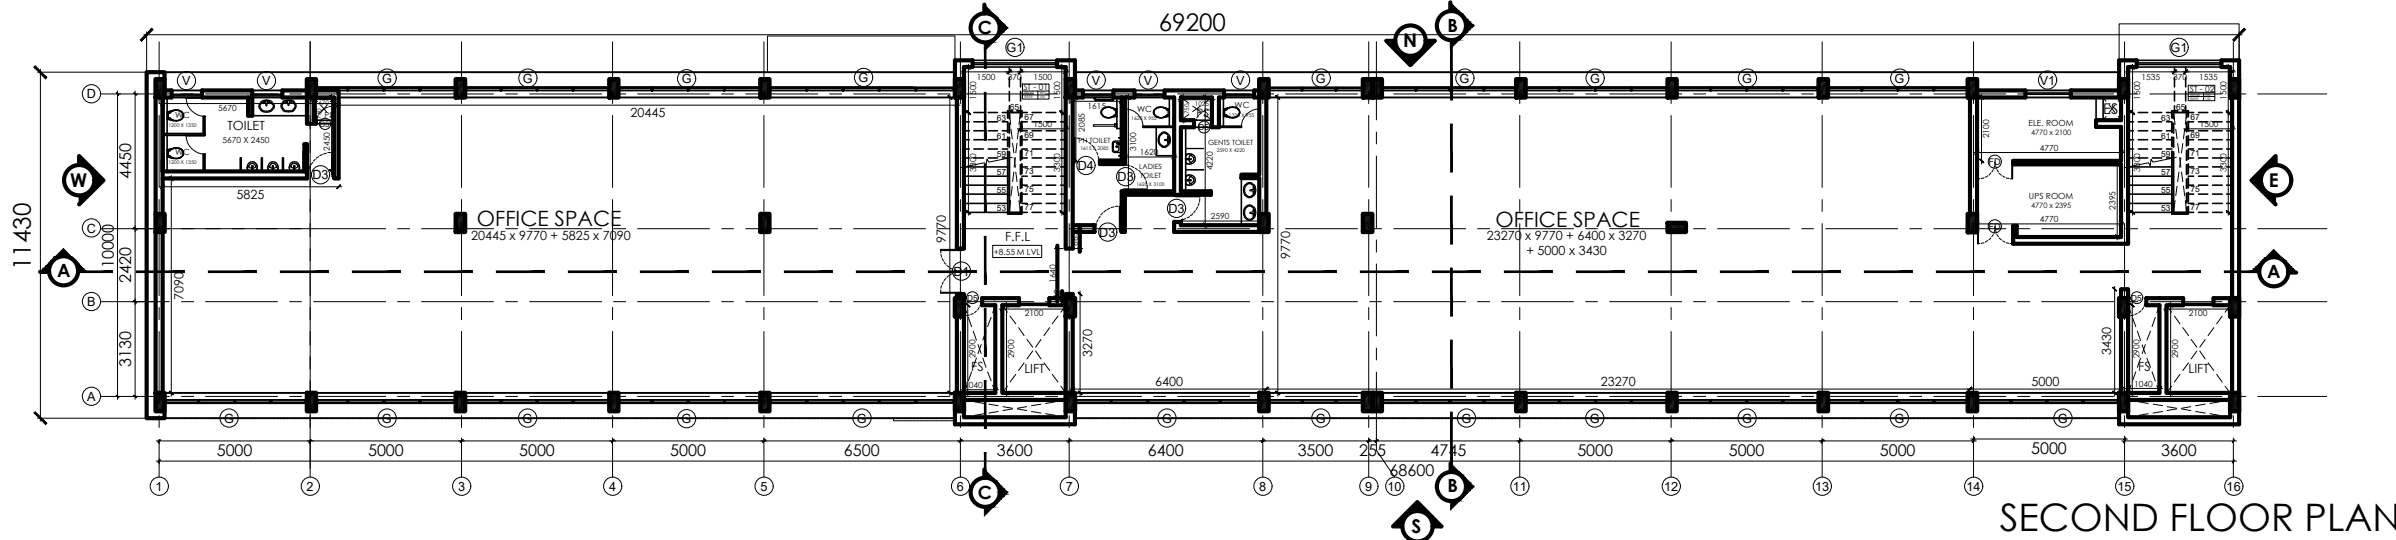





SECOND FLOOR PLAN

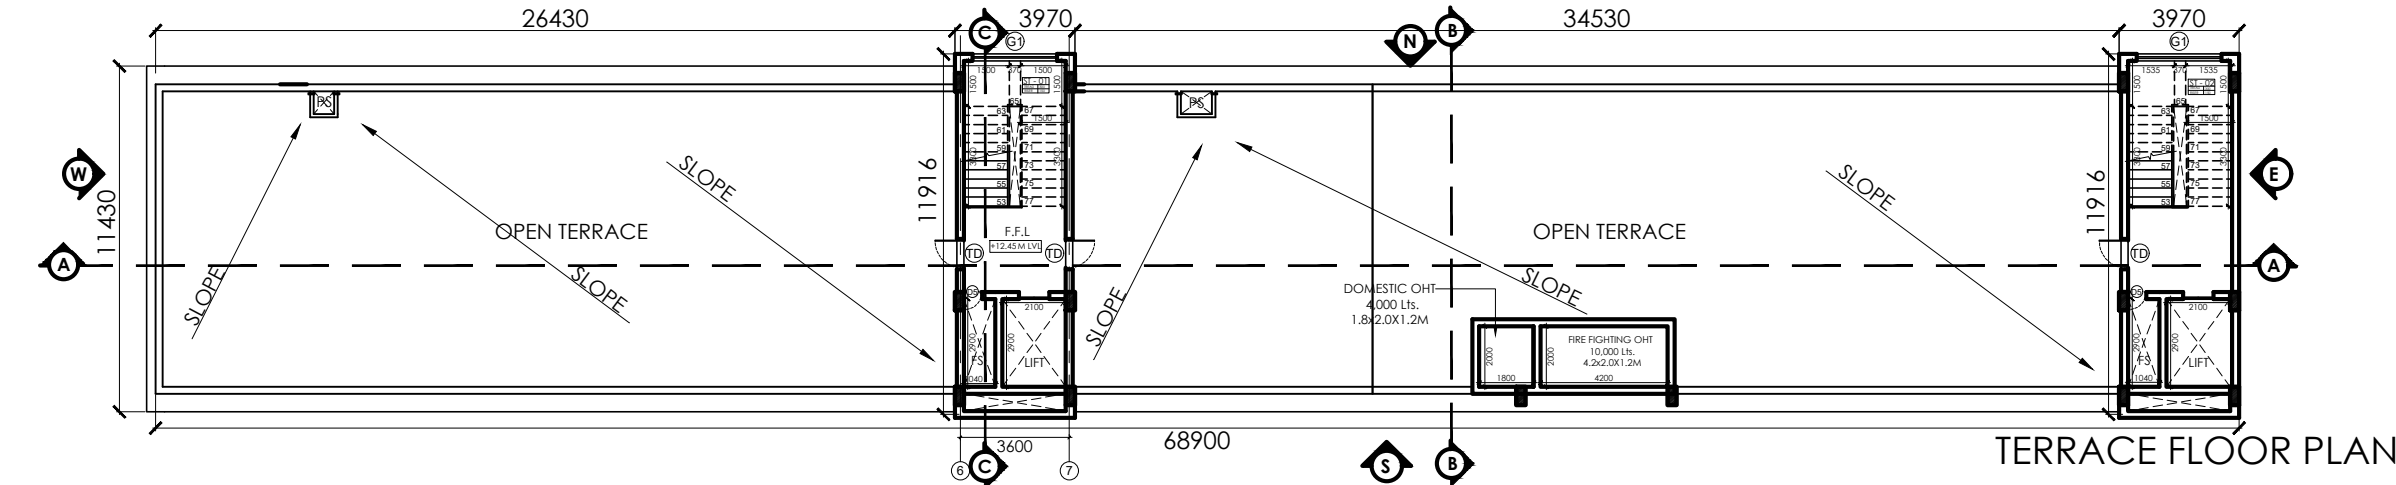

TERRACE FLOOR PLAN

- NOTES
1. This drawing is sole property of 'Pithavadian and Partners' and must not be reproduced or altered either in full or in part by anyone without consent from us or be passed to any individual or company not authorised by us.
 2. Any discrepancy in the drawing should be brought to the immediate attention of the Architect.
 3. All dimensions in millimeters and levels in meters.
 4. Dimensions to be followed as indicated and not to be scaled.

REV.	DATE	DESCRIPTION	DRAWN	CHKD.
REVISIONS				
AS BUILT		INFORMATION		
CONSTRUCTION				
APPROVAL				
INFORMATION	*			
TENDER				
SCHEME				
ISSUED FOR				
NAME OF THE PROJECT:				
PROPOSED M/S. FREUDENBERG REGIONAL CORPORATE CENTER INDIA PVT. LTD (FRCCI) UNIT 1, BARI MARUALI AND RAMGARH ALIAS MANDA MORINDA TEHSIL, PUNJAB.				
CLIENT:				
FRCCI				
FREUDENBERG REGIONAL CORPORATE CENTER INDIA PVT. LTD.				
	DRAWING TITLE:			
	OFFICE BLOCK			
	FLOOR PLANS			
	STRUCTURAL CONSULTANT:			
ZACHARIA GEORGE F.I.E				
SCALE:	DESIGN BY:	DRAWN BY:	CHECKED BY:	
1:250 @ A3	PDG	SHREYA	PDG	
DATE:	SIGN:	SIGN:	SIGN:	
14.09.2022				
ARCHITECTURE * INTERIORS * PLANNING * ENGINEERING * MANAGEMENT				
PITHAVADIAN AND PARTNERS				
Chennai • Bengaluru • Kochi • Hyderabad				
10, MURUGAPPA ROAD, NAWAB GARDENS, KOTURPURAM, CHENNAI - 600 085				
Phone : +91 (0) 44 2447 0033 / 44 166				
Fax : +91 (0) 44 2447 0888/4213 2797				
email : mail@paparchitect.com				
website : www.paparchitect.com				
				
DWG NO: 07-04A		(SHT 01 OF 03)	REV NO: 0	

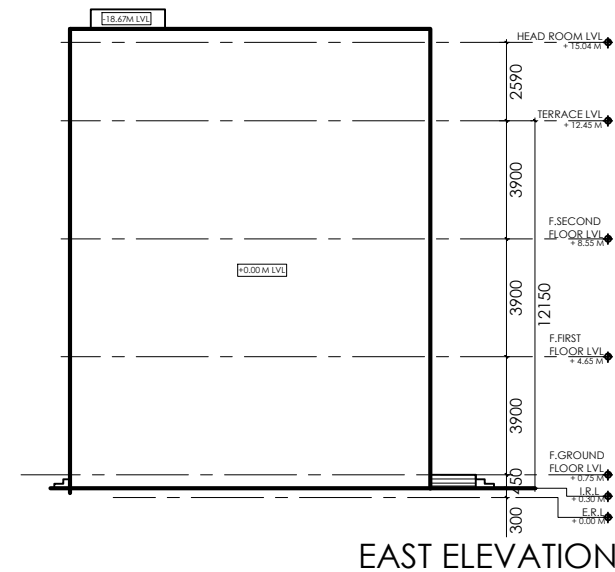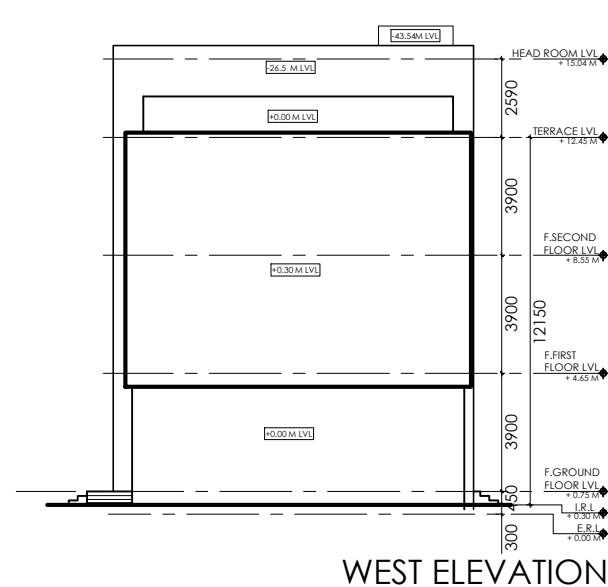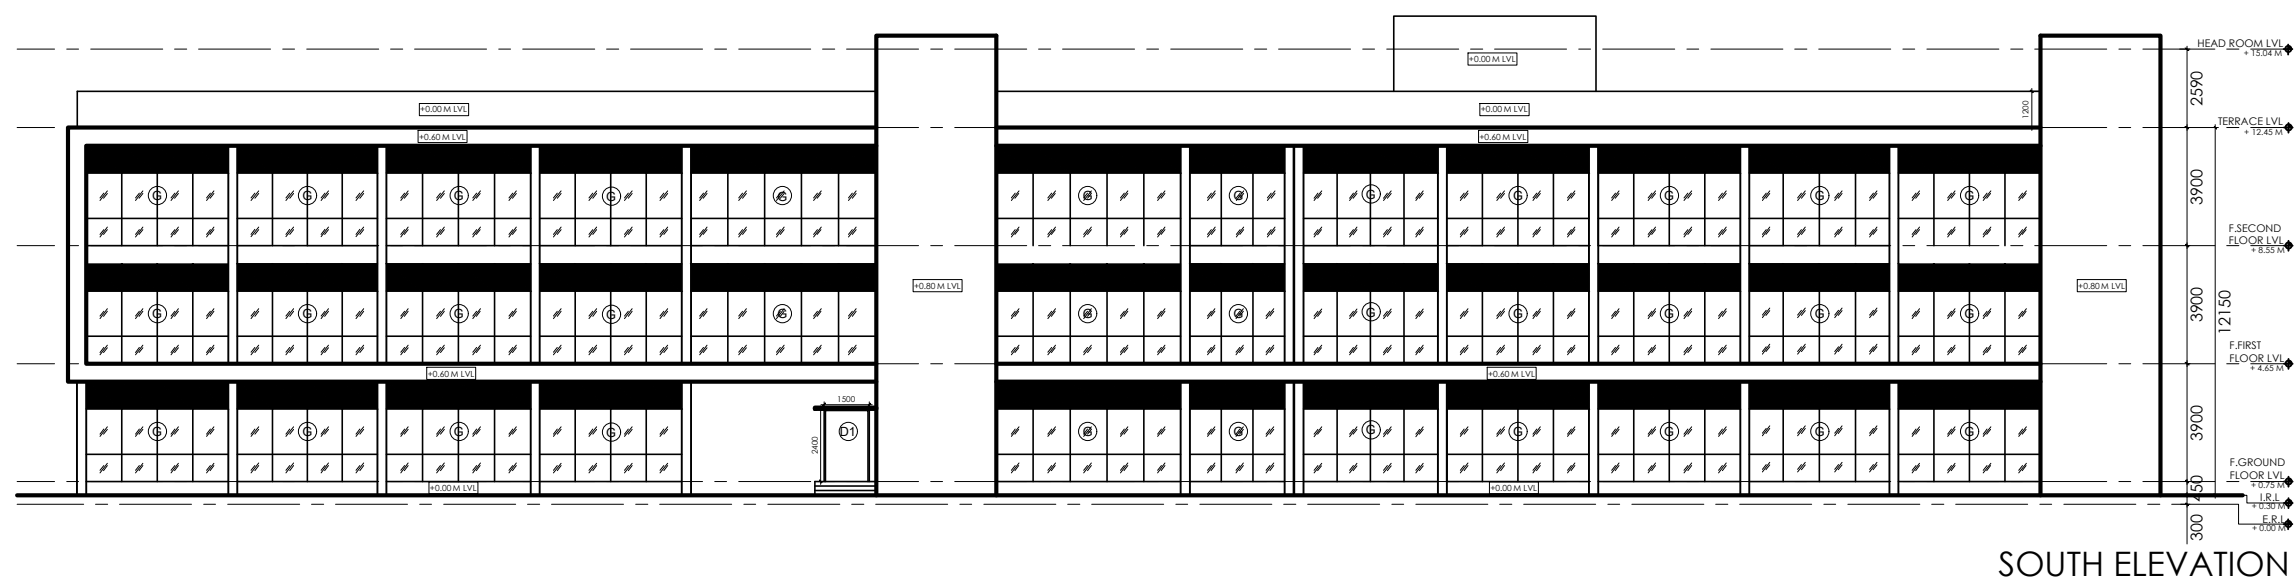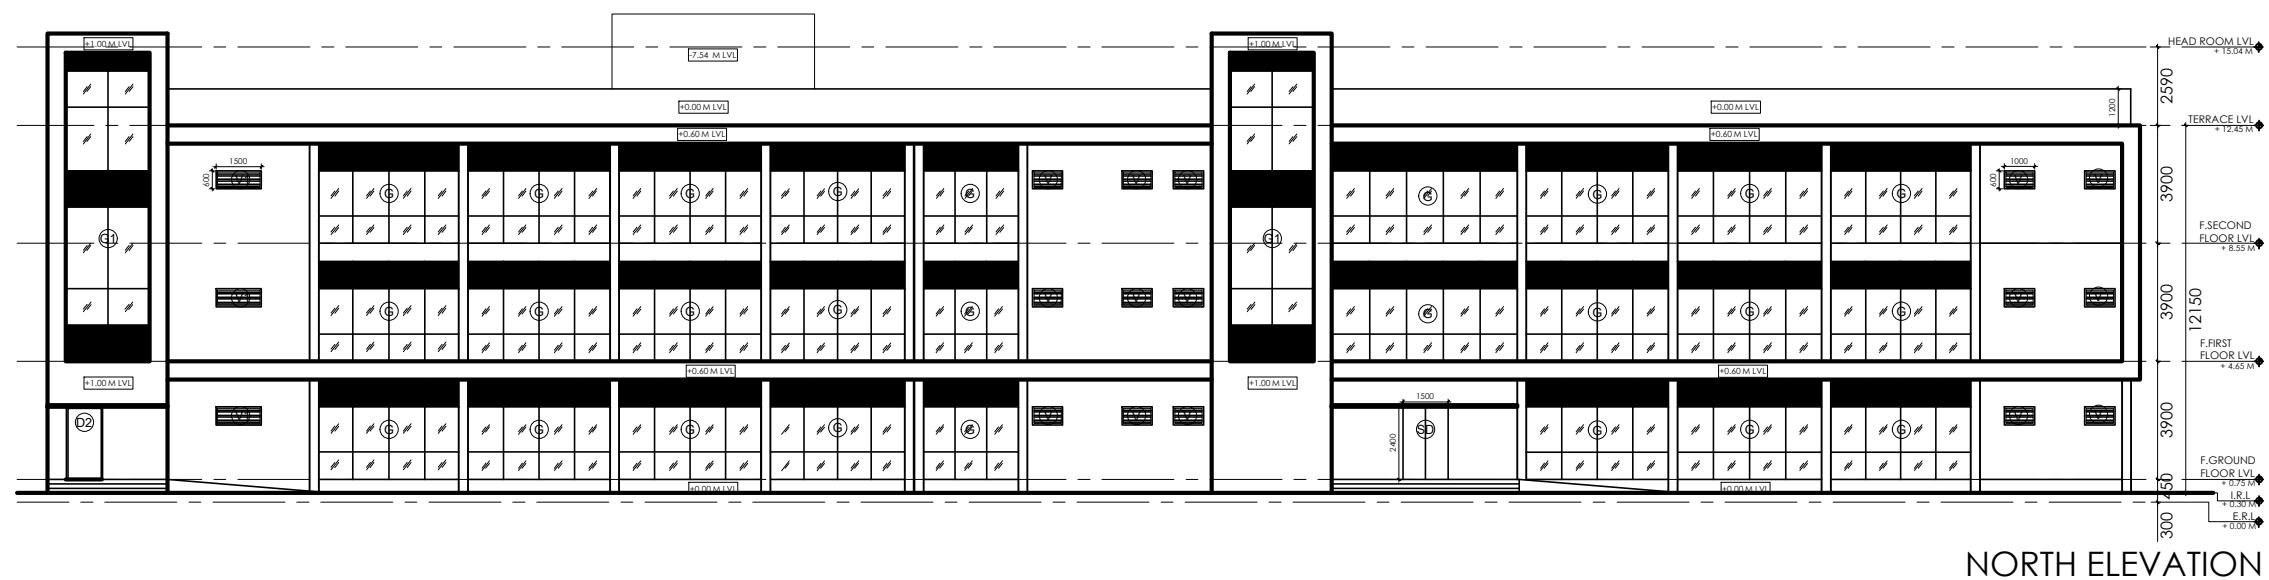

NOTES

1. This drawing is sole property of "Pithavadi and Partners" and must not be reproduced or altered either in full or in part by anyone without consent from us or be passed to any individual or company not authorised by us.
2. Any discrepancy in the drawing should be brought to the immediate attention of the Architect.
3. All dimensions in millimeters and levels in meters.
4. Dimensions to be followed as indicated and not to be scaled.

REV.	DATE	DESCRIPTION	DRAWN	CHKD.
------	------	-------------	-------	-------

REVISIONS

AS BUILT	
CONSTRUCTION	
APPROVAL	
INFORMATION	
TENDER	
SCHEME	
ISSUED FOR	

INFORMATION

NAME OF THE PROJECT:

PROPOSED M/S. FREUDENBERG REGIONAL CORPORATE CENTER
INDIA PVT. LTD (FRCCI) UNIT 1, BARI MARUALI AND RAMGARH
ALIAS MANDA MORINDA TEHSIL, PUNJAB.

CLIENT:

FRCCI
FREUDENBERG REGIONAL CORPORATE CENTER INDIA PVT. LTD.

	DRAWING TITLE: OFFICE BLOCK ELEVATIONS
---	--



STRUCTURAL CONSULTANT:

ZACHARIA GEORGE F.I.E

SCALE: 1:250 @ A3	DESIGN BY: PDG	DRAWN BY: SHREYA	CHECKED BY: PDG
DATE: 14.09.2022	SIGN:	SIGN:	SIGN:

ARCHITECTURE * INTERIORS * PLANNING * ENGINEERING * MANAGEMENT

PITHAVADIAN AND PARTNERS

Chennai ■ Bengaluru ■ Kochi ■ Hyderabad

10, MURUGAPPA ROAD, NAWAB GARDENS,
KOTTURPURAM, CHENNAI - 600 085

Phone : +91 (0) 44 2447 0033 / 44 / 66
Fax : +91 (0) 44 2447 0888/4213 2797
email : mail@paparchitect.com
website : www.paparchitect.com






DWG NO: 07-04B

(SHT 02 OF 03) REV NO: 0

NOTES

1. This drawing is sole property of 'Pithavadian and Partners' and must not be reproduced or altered either in full or in part by anyone without consent from us or be passed to any individual or company not authorised by us.
2. Any discrepancy in the drawing should be brought to the immediate attention of the Architect.
3. All dimensions in millimeters and levels in meters.
4. Dimensions to be followed as indicated and not to be scaled.

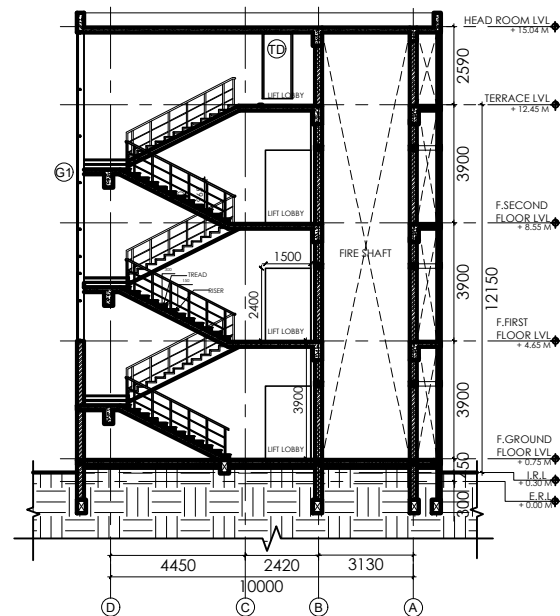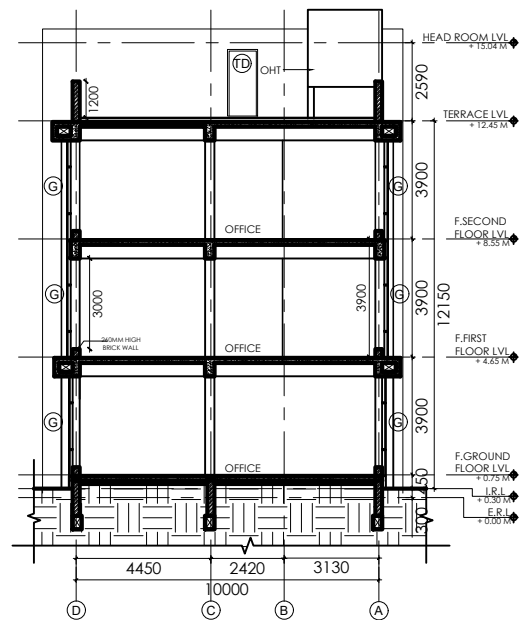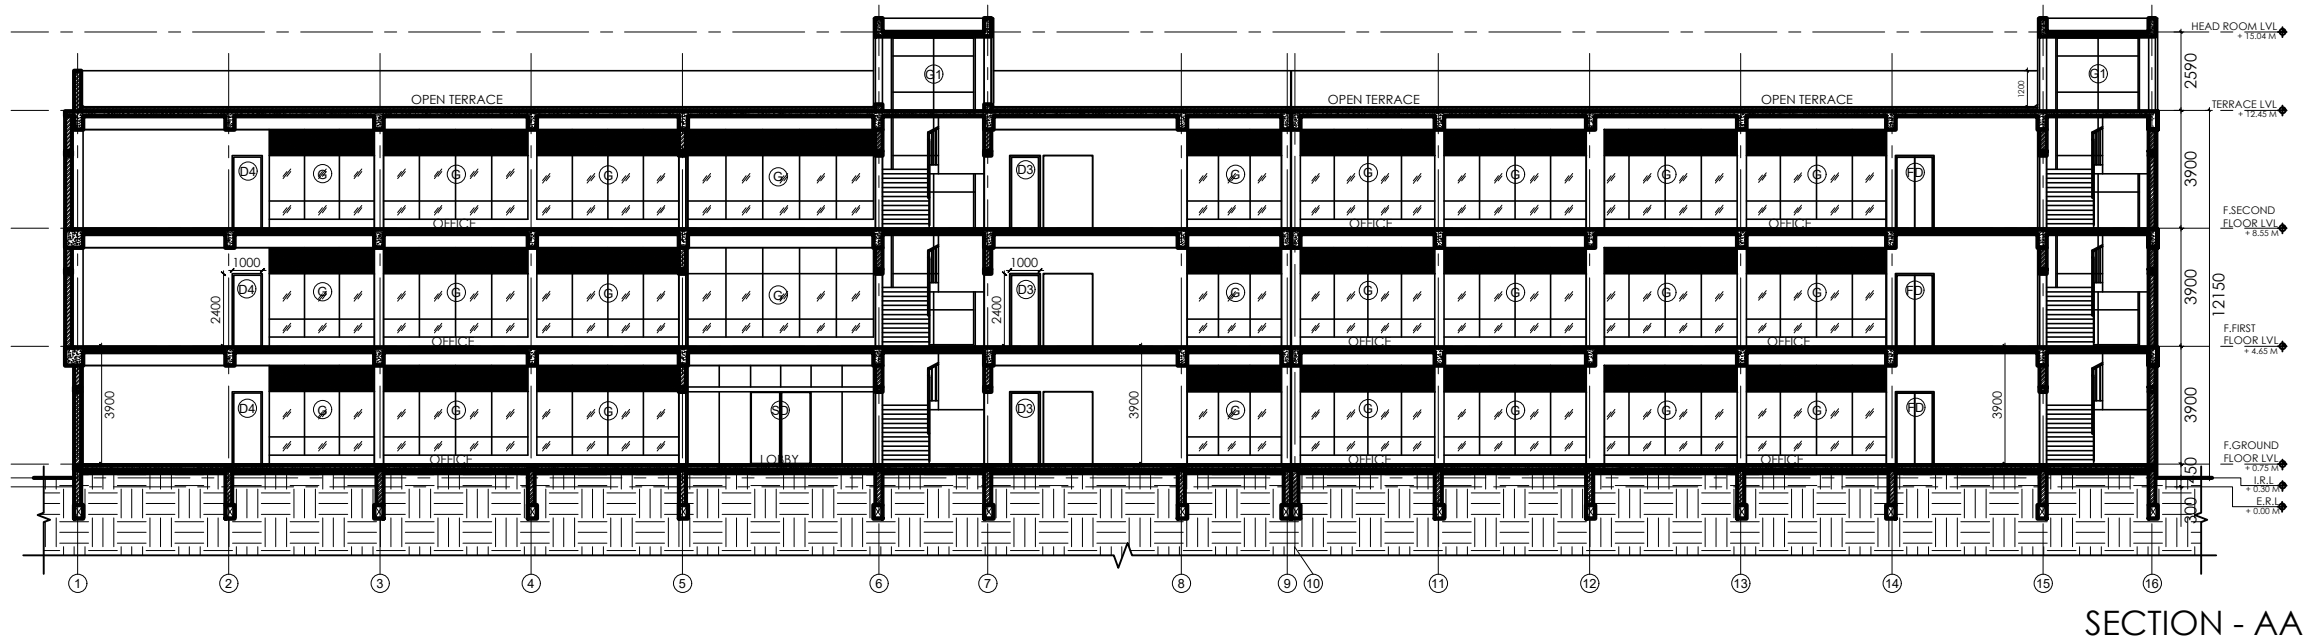

REV.	DATE	DESCRIPTION	DRAWN	CHKD.
------	------	-------------	-------	-------

REVISIONS

AS BUILT	
CONSTRUCTION	
APPROVAL	
INFORMATION	*
TENDER	
SCHEME	
ISSUED FOR	


INFORMATION

NAME OF THE PROJECT:

PROPOSED M/S. FREUDENBERG REGIONAL CORPORATE CENTER INDIA PVT. LTD (FRCCI) UNIT 1, BARI MARUALI AND RAMGARH ALIAS MANDA MORINDA TEHSIL, PUNJAB.

CLIENT:

FRCCI
FREUDENBERG REGIONAL CORPORATE CENTER INDIA PVT. LTD.

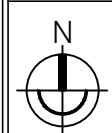

DRAWING TITLE:
OFFICE BLOCK
SECTIONS

STRUCTURAL CONSULTANT:

ZACHARIA GEORGE F.I.E

SCALE: 1:250 @ A3	DESIGN BY: PDG	DRAWN BY: SHREYA	CHECKED BY: PDG
DATE: 14.09.2022	SIGN:	SIGN:	SIGN:

ARCHITECTURE * INTERIORS * PLANNING * ENGINEERING * MANAGEMENT

PITHAVADIAN AND PARTNERS
Chennai • Bengaluru • Kochi • Hyderabad



10, MURUGAPPA ROAD, NAWAB GARDENS,
KOTTURPURAM, CHENNAI - 600 085

Phone : +91 (0) 44 2447 0033 / 44 166
Fax : +91 (0) 44 2447 0888/4213 2797
email : mail@paparchitect.com
website : www.paparchitect.com




DWG NO: 07-04C

(SHT 03 OF 03) REV NO: 0

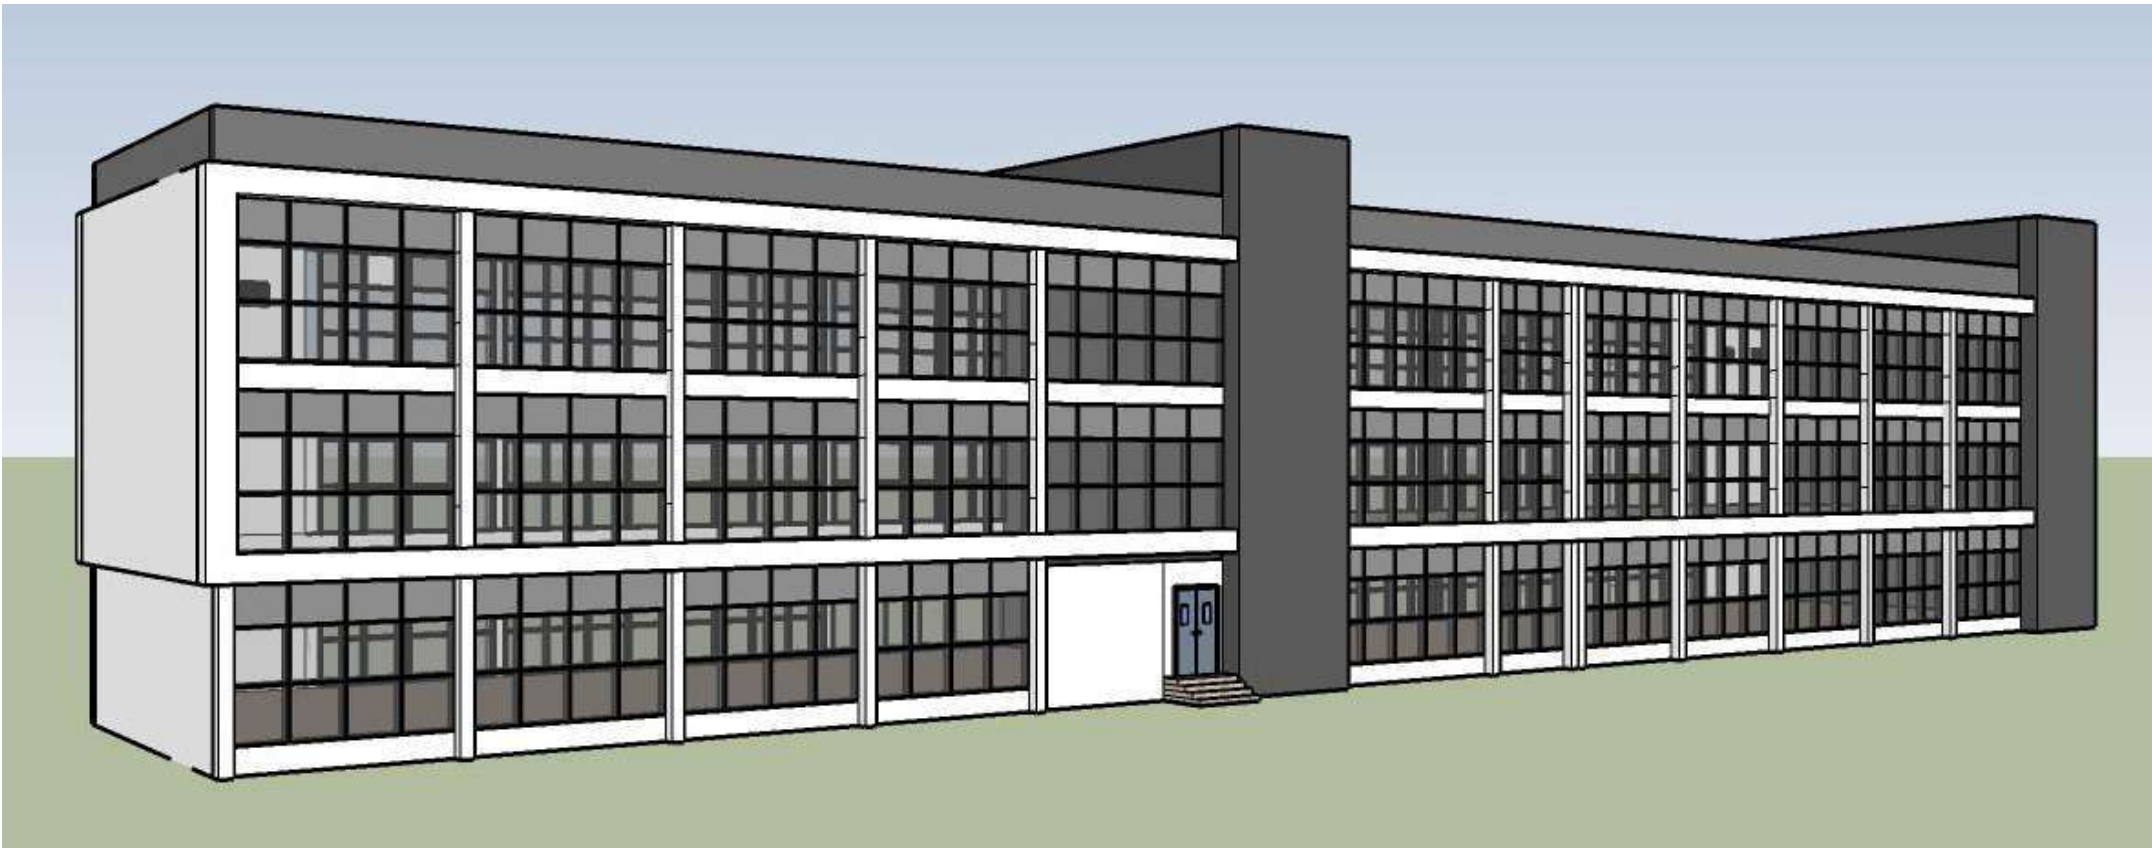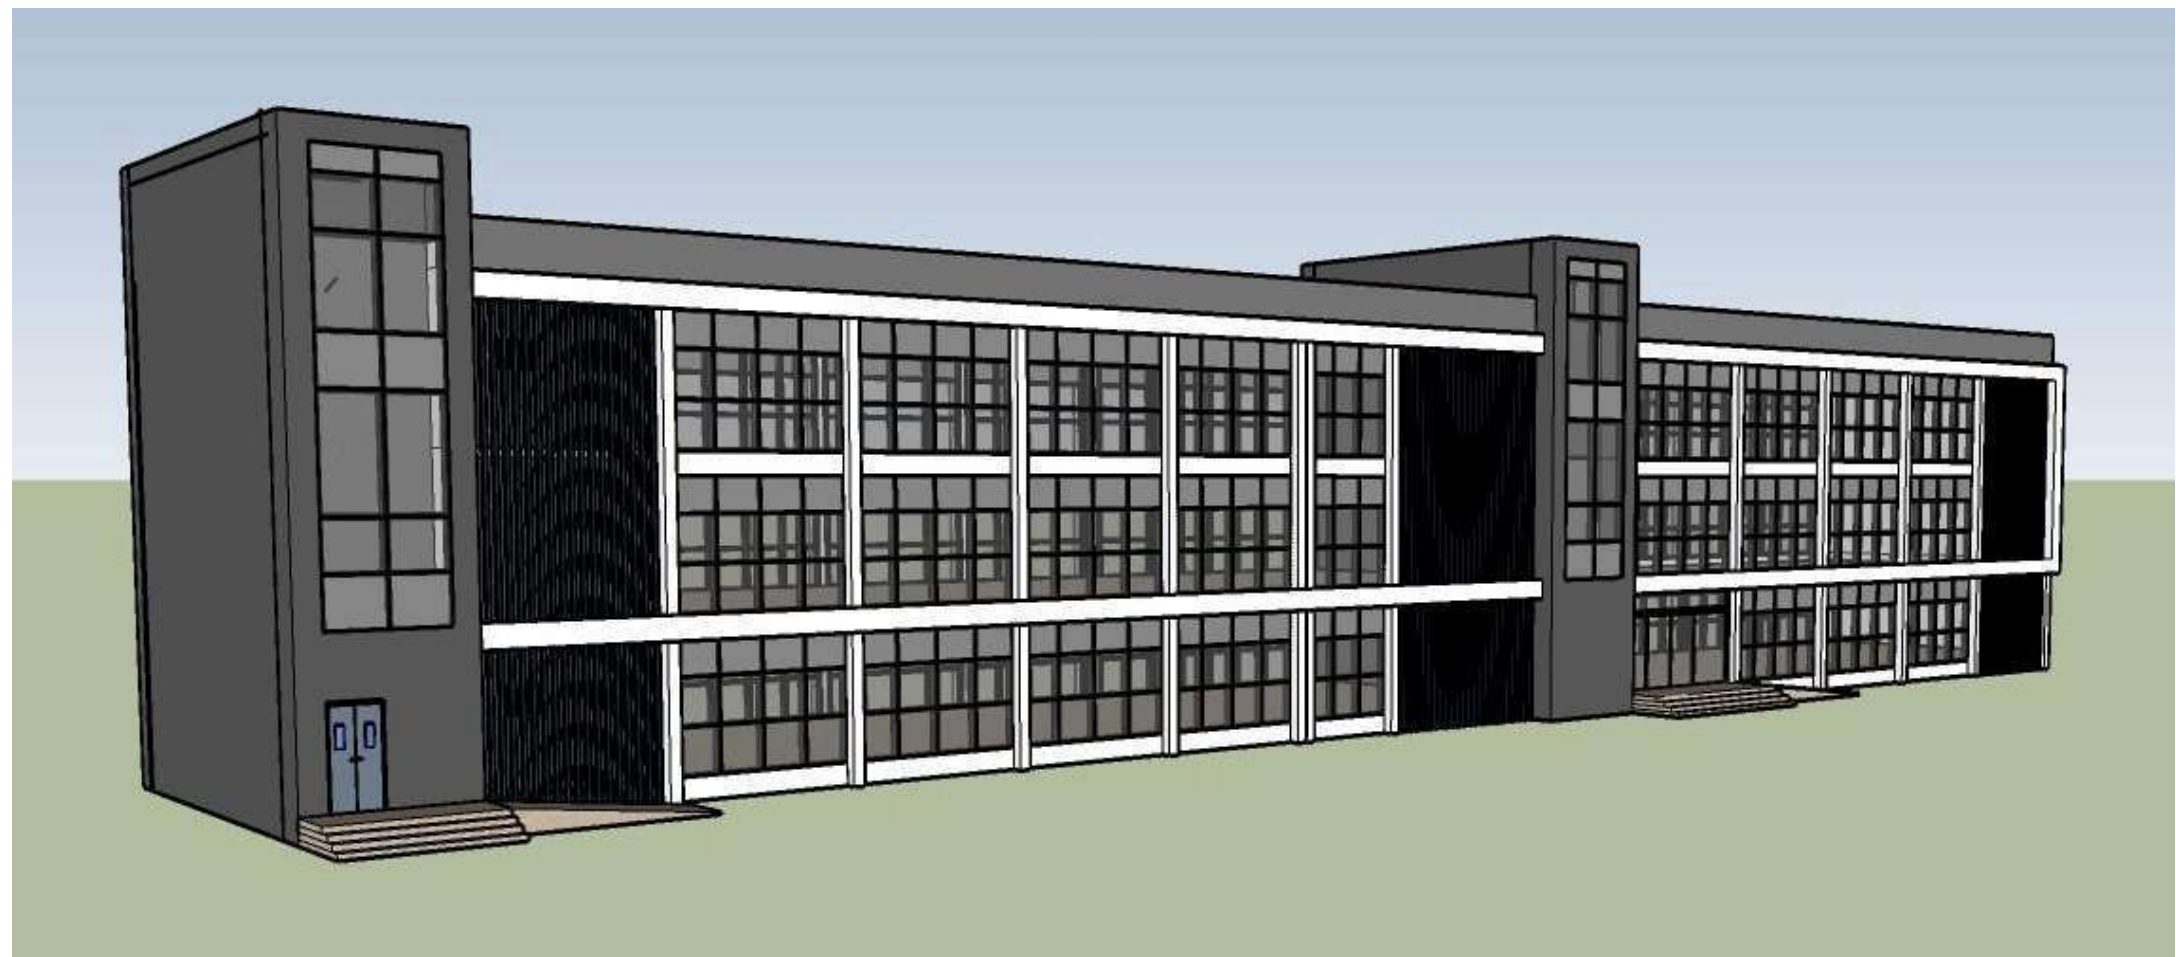


1. This drawing is sole property of "Pithavahan and Partners" and must not be reproduced or stored either in full or in part by anyone without consent from us or be passed to any individual or company not authorized by us.
2. Any discrepancy in the drawing should be brought to the immediate attention of the Architect.
3. All dimensions in millimeters and levels in meters.
4. Dimensions to be followed as indicated and not to be copied.

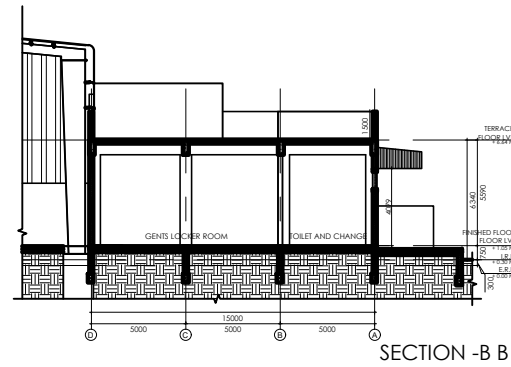




		REVISIONS	
AS BUILT		INFORMATION	
CONSTRUCTION			
APPROVAL			
INFORMATION	*		
TENDER			
SCHEME			
ISSUED FOR			

CLIENT:
FRCCI
FREUDENBERG REGIONAL CORPORATE CENTER INDIA PVT. LTD.

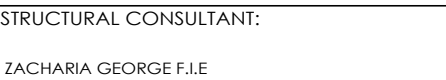

ARCHITECTURE * INTERIORS * PLANNING * ENGINEERING * MANAGEMENT

PNP

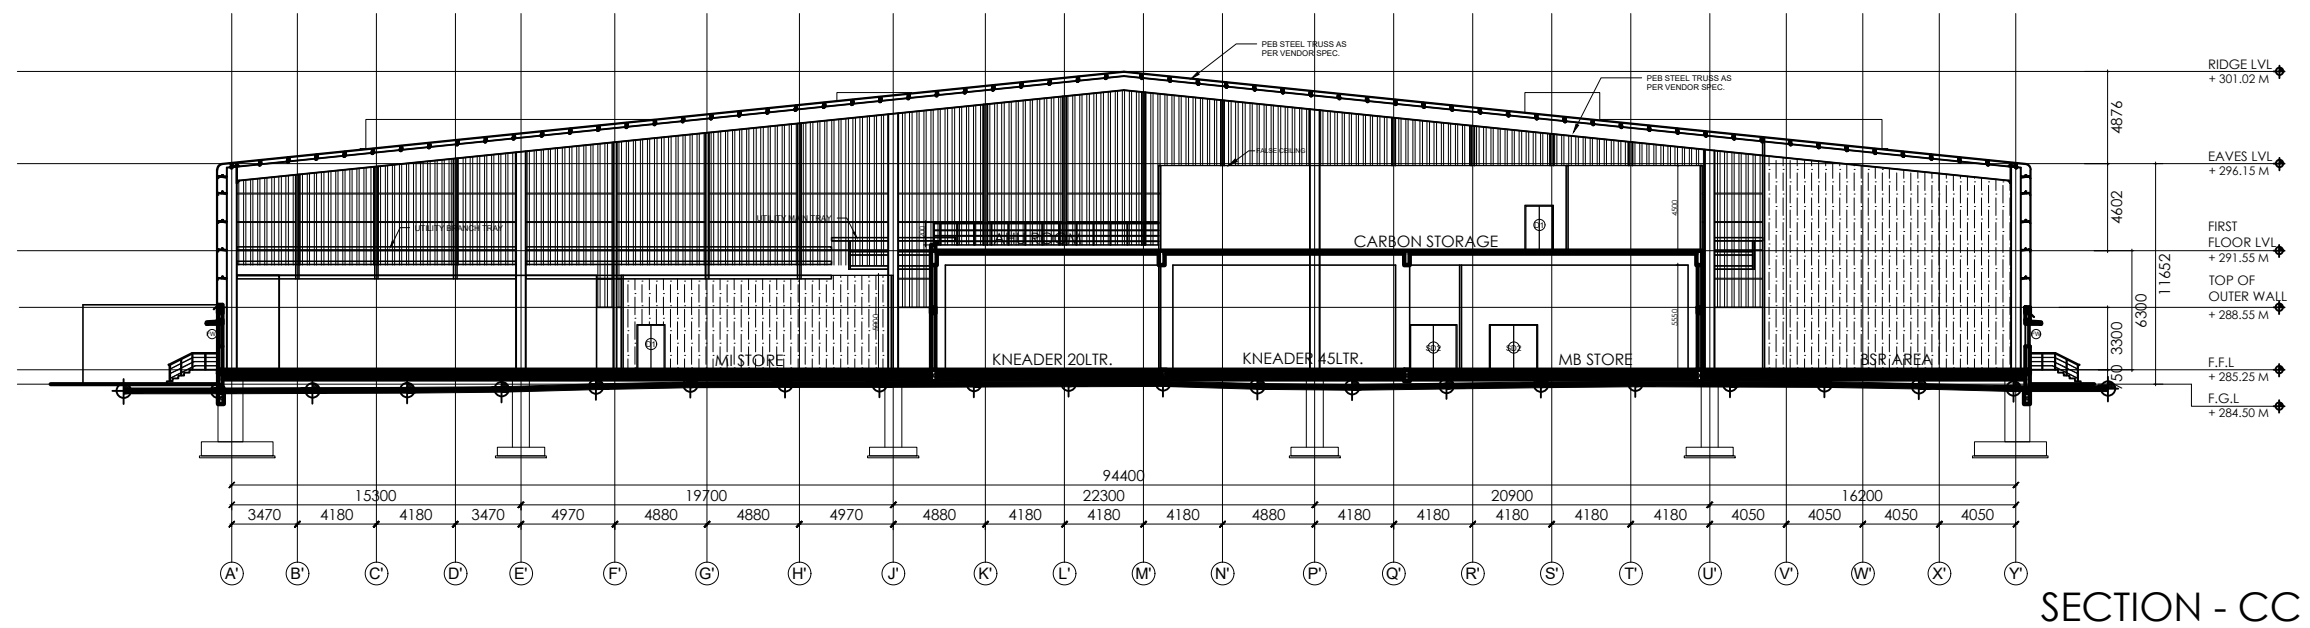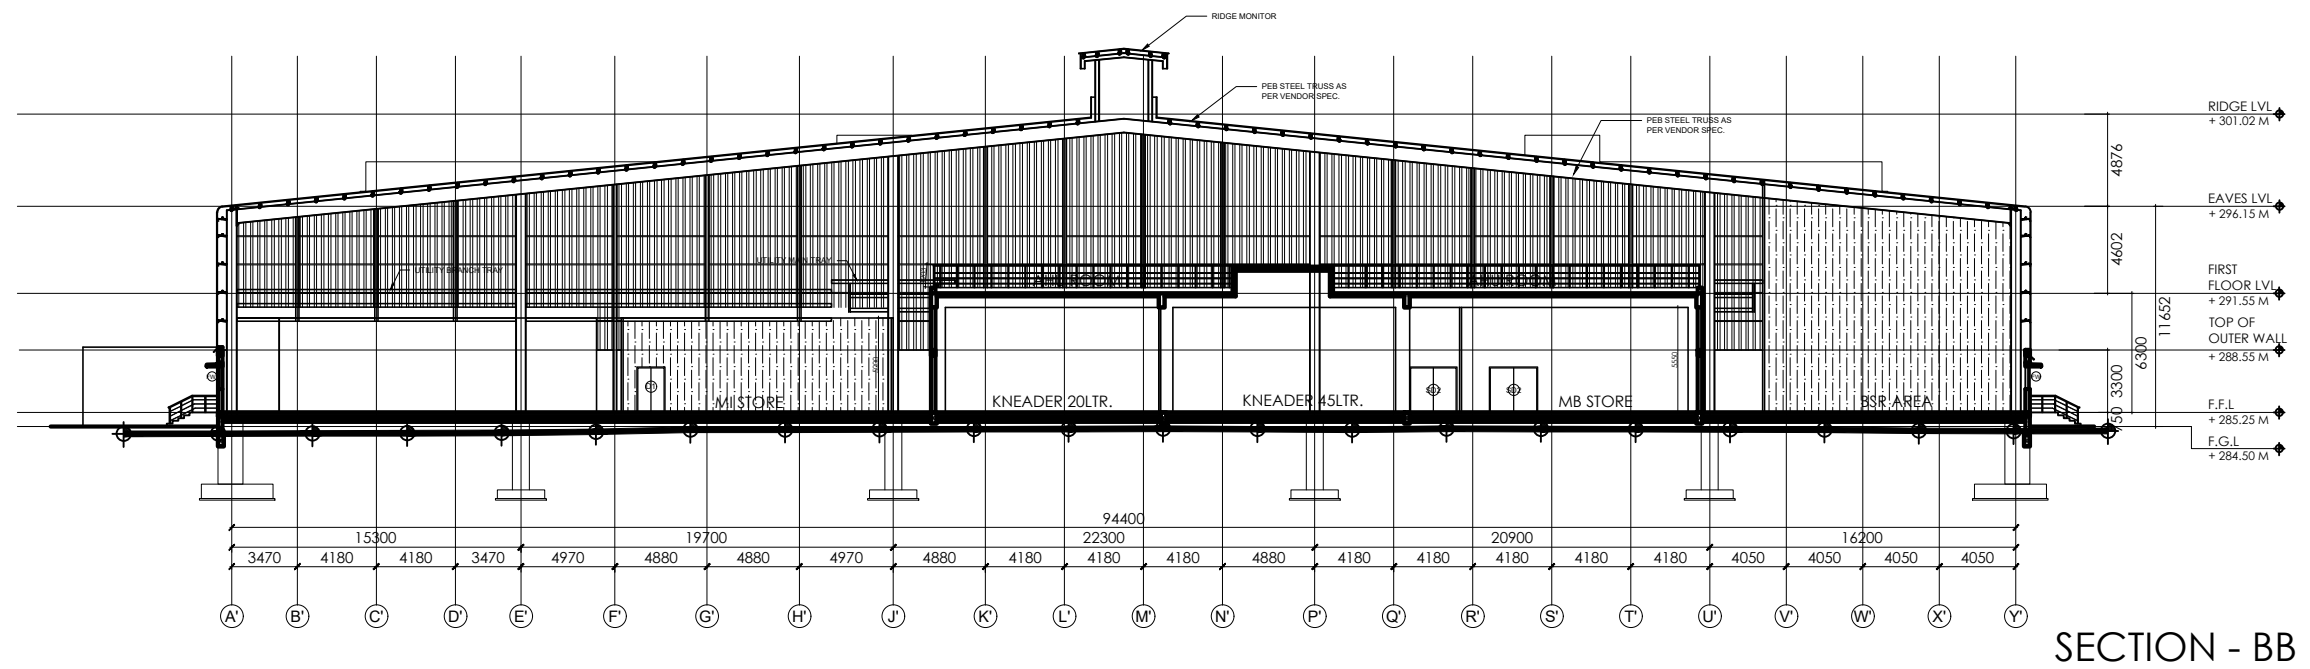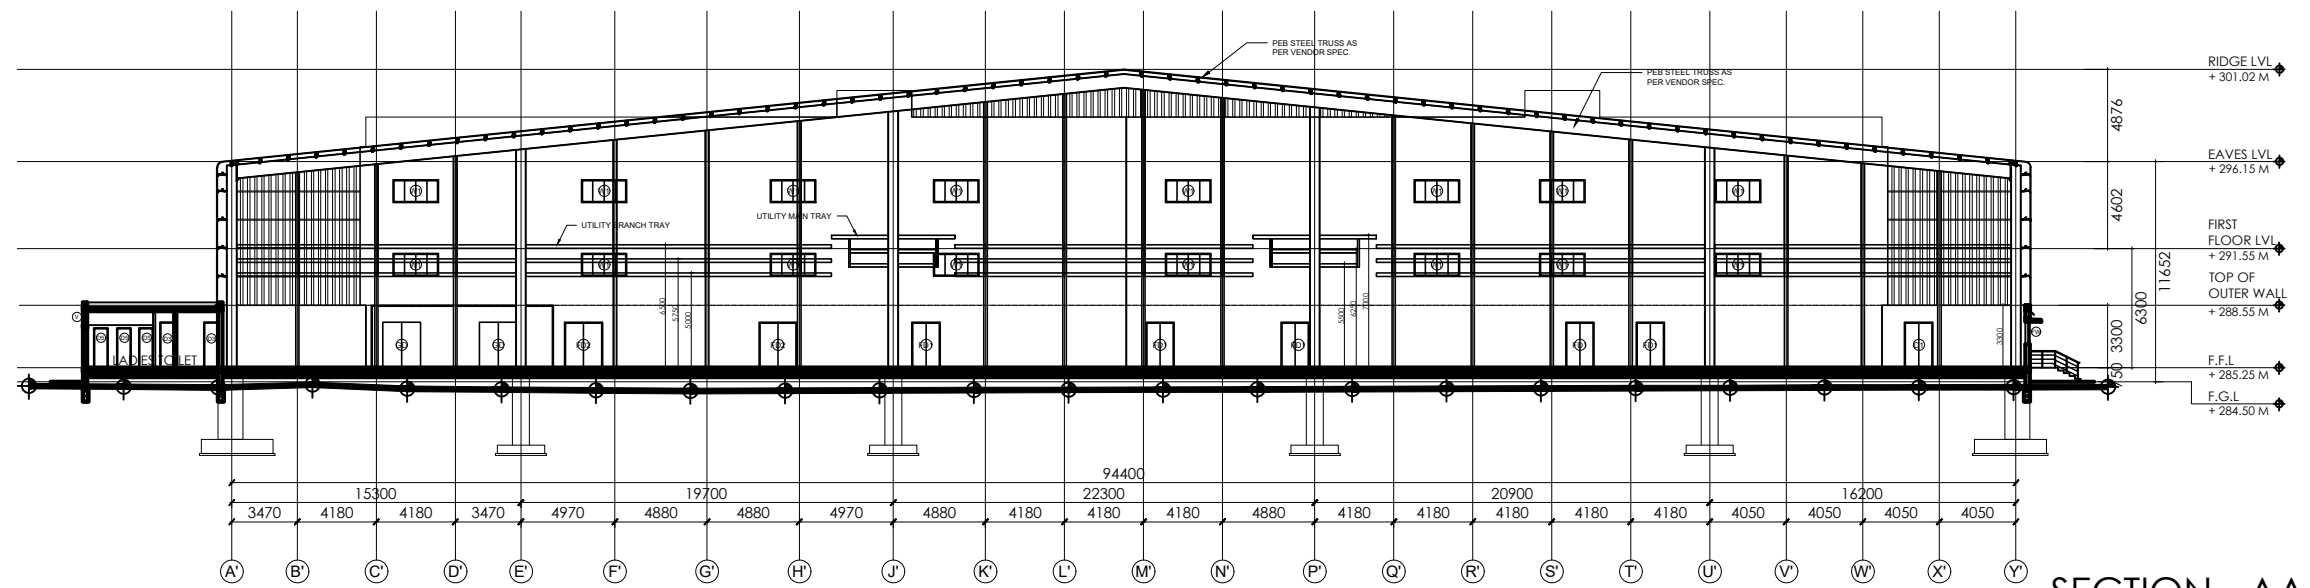

NOTES

1. This drawing is sole property of 'Pithavadian and Partners' and must not be reproduced or altered either in full or in part by anyone without consent from us or be passed to any individual or company not authorised by us.
2. Any discrepancy in the drawing should be brought to the immediate attention of the Architect.
3. All dimensions in millimeters and levels in meters.
4. Dimensions to be followed as indicated and not to be scaled.

REV.	DATE	DESCRIPTION	DRAWN	CHKD.
------	------	-------------	-------	-------

REVISIONS				
AS BUILT				
CONSTRUCTION				
APPROVAL				
INFORMATION	*			
TENDER				
SCHEME				
ISSUED FOR				

INFORMATION

NAME OF THE PROJECT:
PROPOSED M/S. FREUDENBERG REGIONAL CORPORATE CENTER INDIA PVT. LTD (FRCCI) UNIT 2, BARI MARUALI AND RAMGARH ALIAS MANDA MORINDA TEHSIL, PUNJAB.

CLIENT:
FRCCI
FREUDENBERG REGIONAL CORPORATE CENTER INDIA PVT. LTD.

DRAWING TITLE:
UNIT 2 - PRODUCTION PLANT
SECTIONS AA, BB & CC

STRUCTURAL CONSULTANT:
ZACHARIA GEORGE F.I.E

SCALE: 1:500 @ A3	DESIGN BY: PDG	DRAWN BY: SHREYA	CHECKED BY: PDG
DATE: 01.11.2022	SIGN:	SIGN:	SIGN:

ARCHITECTURE * INTERIORS * PLANNING * ENGINEERING * MANAGEMENT


PITHAVADIAN AND PARTNERS
Chennai • Bengaluru • Kochi • Hyderabad
10, MURUGAPPA ROAD, NAWAB GARDENS,
KOTURPURAM, CHENNAI - 600 085
Phone : +91 (0) 44 2447 0033 / 44 166
Fax : +91 (0) 44 2447 0888/4213 2797
email : mail@paparchitect.com
website : www.paparchitect.com




DWG NO: 07-06A (SHT 01 OF 03) REV NO: 0


1. This drawing is sole property of "Himmelman and Partners" and must not be reproduced or shown either in full or in part by anyone without consent from us or be passed to any individual or company not authorized by us.
2. Any discrepancy in the drawing should be brought to the immediate attention of the Architect.
3. All dimensions in millimeters and levels in meters.
4. Dimensions to be followed as indicated and not to be scaled.

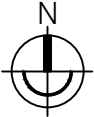


REV.	DATE	DESCRIPTION	DRAWN	CHKD.
REVISIONS				
AS BUILT		INFORMATION		
CONSTRUCTION				
APPROVAL				
INFORMATION *				
TENDER				
SCHEME				
ISSUED FOR				
NAME OF THE PROJECT:				
PROPOSED M/S. FREUDENBERG REGIONAL CORPORATE CENTER INDIA PVT. LTD (FRCCI) UNIT 2, BARI MARUALI AND RAMGARH ALIAS MANDA MORINDA TEHSIL, PUNJAB.				
CLIENT:				
FRCCI FREUDENBERG REGIONAL CORPORATE CENTER INDIA PVT. LTD.				
		DRAWING TITLE: UNIT 2 - PRODUCTION PLANT SECTIONS DD & EE		
		STRUCTURAL CONSULTANT:		
		ZACHARIA GEORGE F.I.E		
SCALE: 1:500 @ A3	DESIGN BY: PDG	DRAWN BY: SHREYA	CHECKED BY: PDG	
DATE: 01.11.2022	SIGN:	SIGN:	SIGN:	
ARCHITECTURE * INTERIORS * PLANNING * ENGINEERING * MANAGEMENT				
PITHAVADIAN AND PARTNERS Chennai • Bengaluru • Kochi • Hyderabad				
10, MURUGAPPA ROAD, NAWAB GARDENS, KOTURUPURAM, CHENNAI - 600 085				
Phone : +91 (0) 44 2447 0033 / 44 / 66 Fax : +91 (0) 44 2447 0888 / 4213 2797 email : mail@paparchitect.com website : www.paparchitect.com				
DWG NO: 07-06B		(SHT 02 OF 03)		REV NO: 0

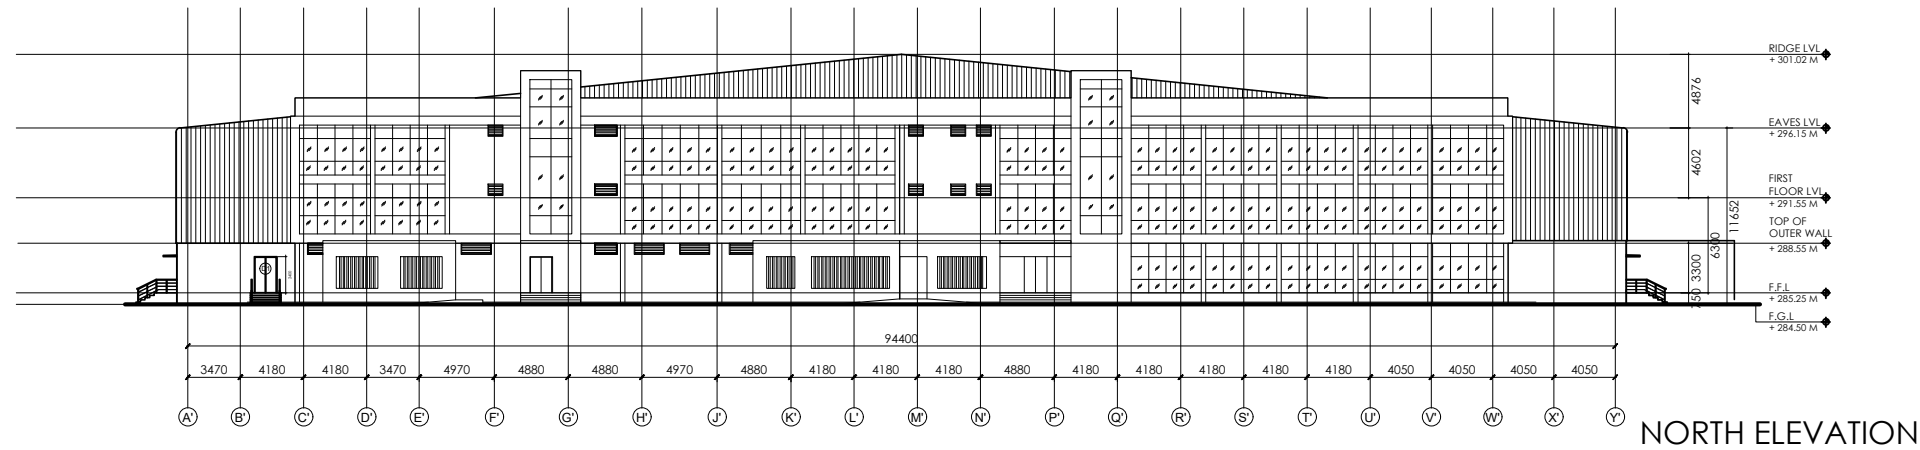


NORTH ELEVATION

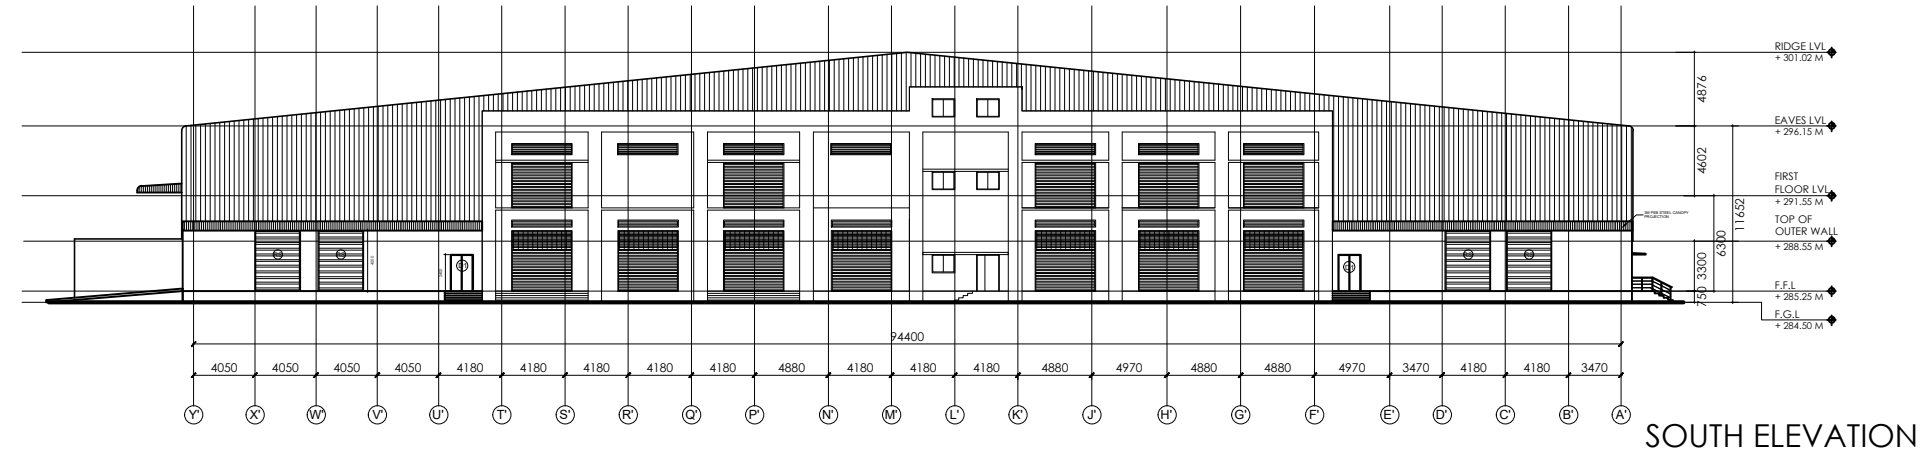

SOUTH ELEVATION

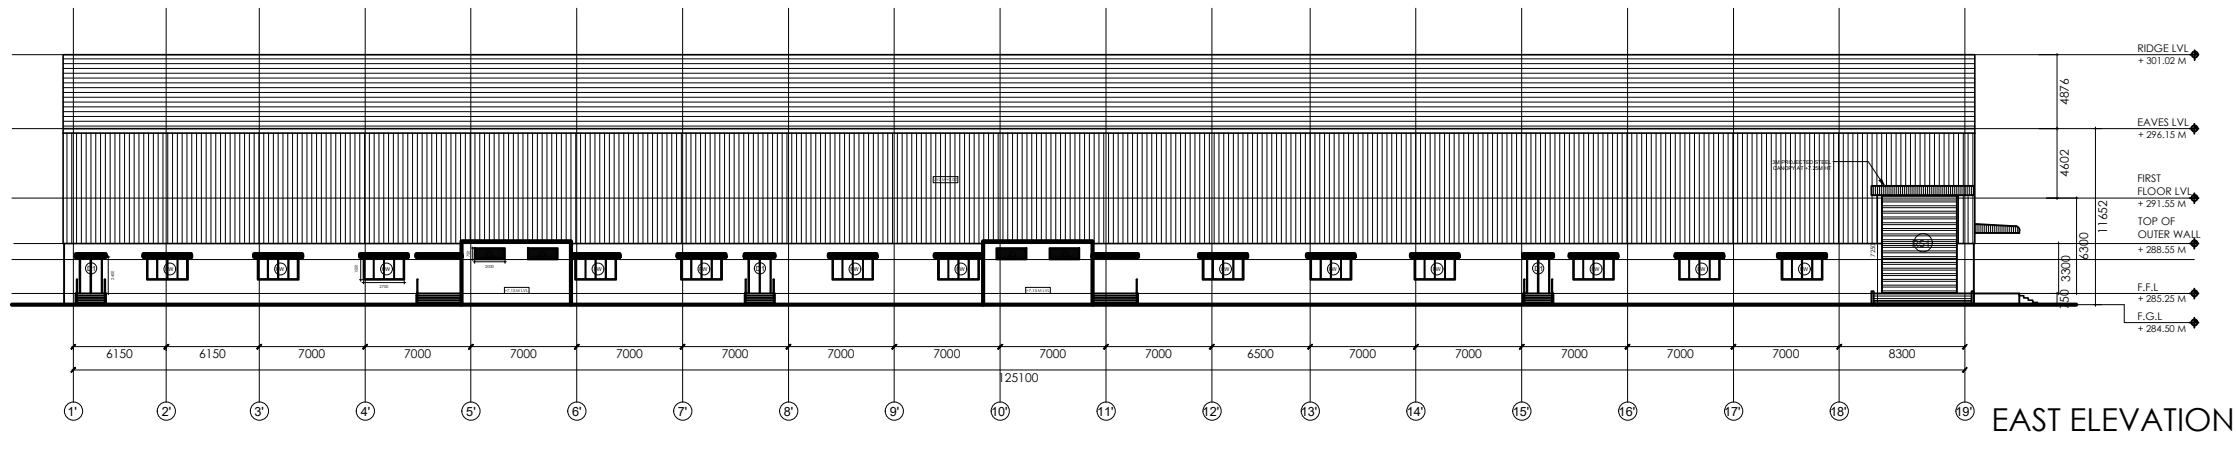

EAST ELEVATION

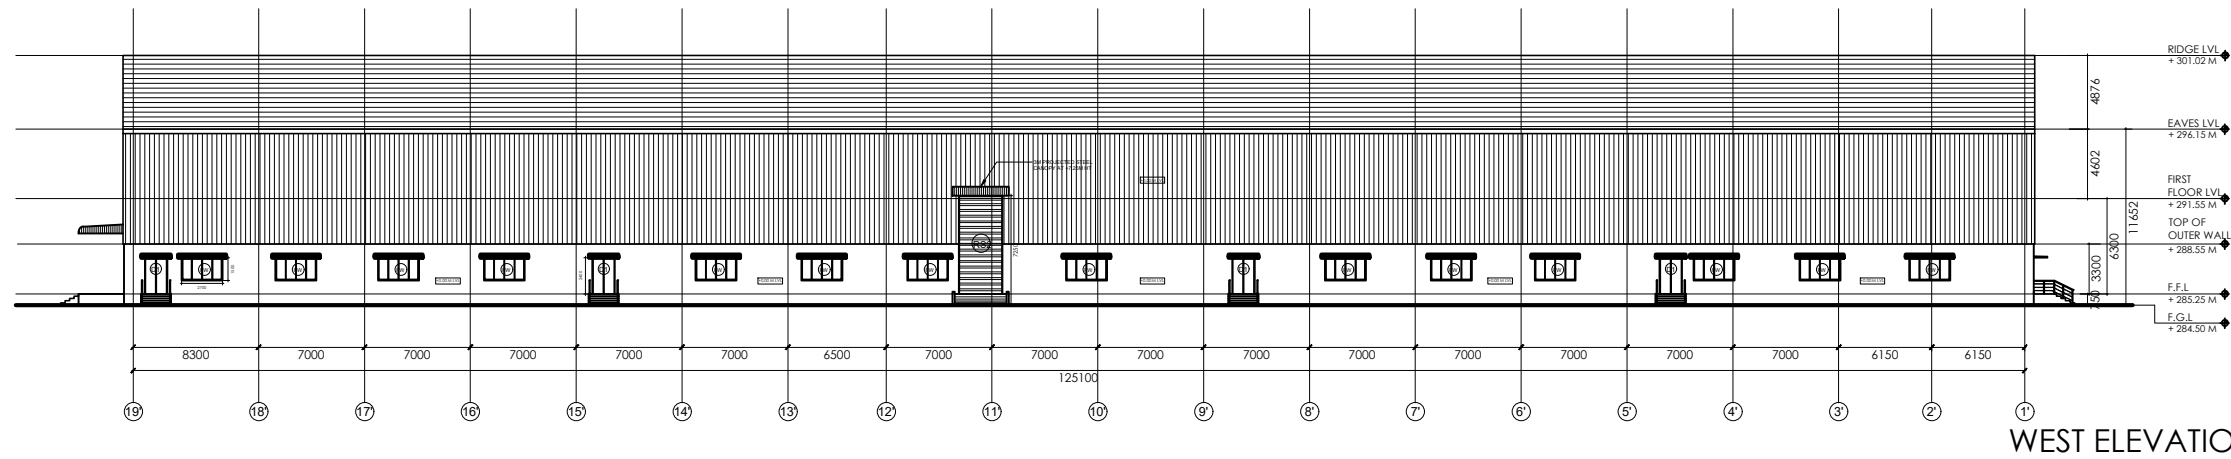

WEST ELEVATION

NOTES

1. This drawing is sole property of 'Pithavadian and Partners' and must not be reproduced or altered either in full or in part by anyone without consent from us or be passed to any individual or company not authorized by us.
2. Any discrepancy in the drawing should be brought to the immediate attention of the Architect.
3. All dimensions in millimeters and levels in meters.
4. Dimensions to be followed as indicated and not to be scaled.

REV.	DATE	DESCRIPTION	DRAWN	CHKD.
REVISIONS				
AS BUILT				
CONSTRUCTION				
APPROVAL				
INFORMATION *				
TENDER				
SCHEME				
ISSUED FOR				

INFORMATION

NAME OF THE PROJECT:
PROPOSED M/S. FREUDENBERG REGIONAL CORPORATE CENTER INDIA PVT. LTD (FRCCI) UNIT 2, BARI MARUALI AND RAMGARH ALIAS MANDA MORINDA TEHSIL, PUNJAB.

CLIENT:
FRCCI
FREUDENBERG REGIONAL CORPORATE CENTER INDIA PVT. LTD.

DRAWING TITLE:
UNIT 2 - PRODUCTION PLANT ELEVATIONS

STRUCTURAL CONSULTANT:
ZACHARIA GEORGE F.I.E



SCALE: 1:500 @ A3	DESIGN BY: PDG	DRAWN BY: SHREYA	CHECKED BY: PDG
DATE: 01.11.2022	SIGN:	SIGN:	SIGN:

ARCHITECTURE * INTERIORS * PLANNING * ENGINEERING * MANAGEMENT

PITHAVADIAN AND PARTNERS
Chennai • Bengaluru • Kochi • Hyderabad
10, MURUGAPPA ROAD, NAWAB GARDENS,
KOTTURPURAM, CHENNAI - 600 085
Phone : +91 (0) 44 2447 0033 / 44 166
Fax : +91 (0) 44 2447 0888/4213 2797
email : mail@paparchitect.com
website : www.paparchitect.com



COMPETITION RENDERS

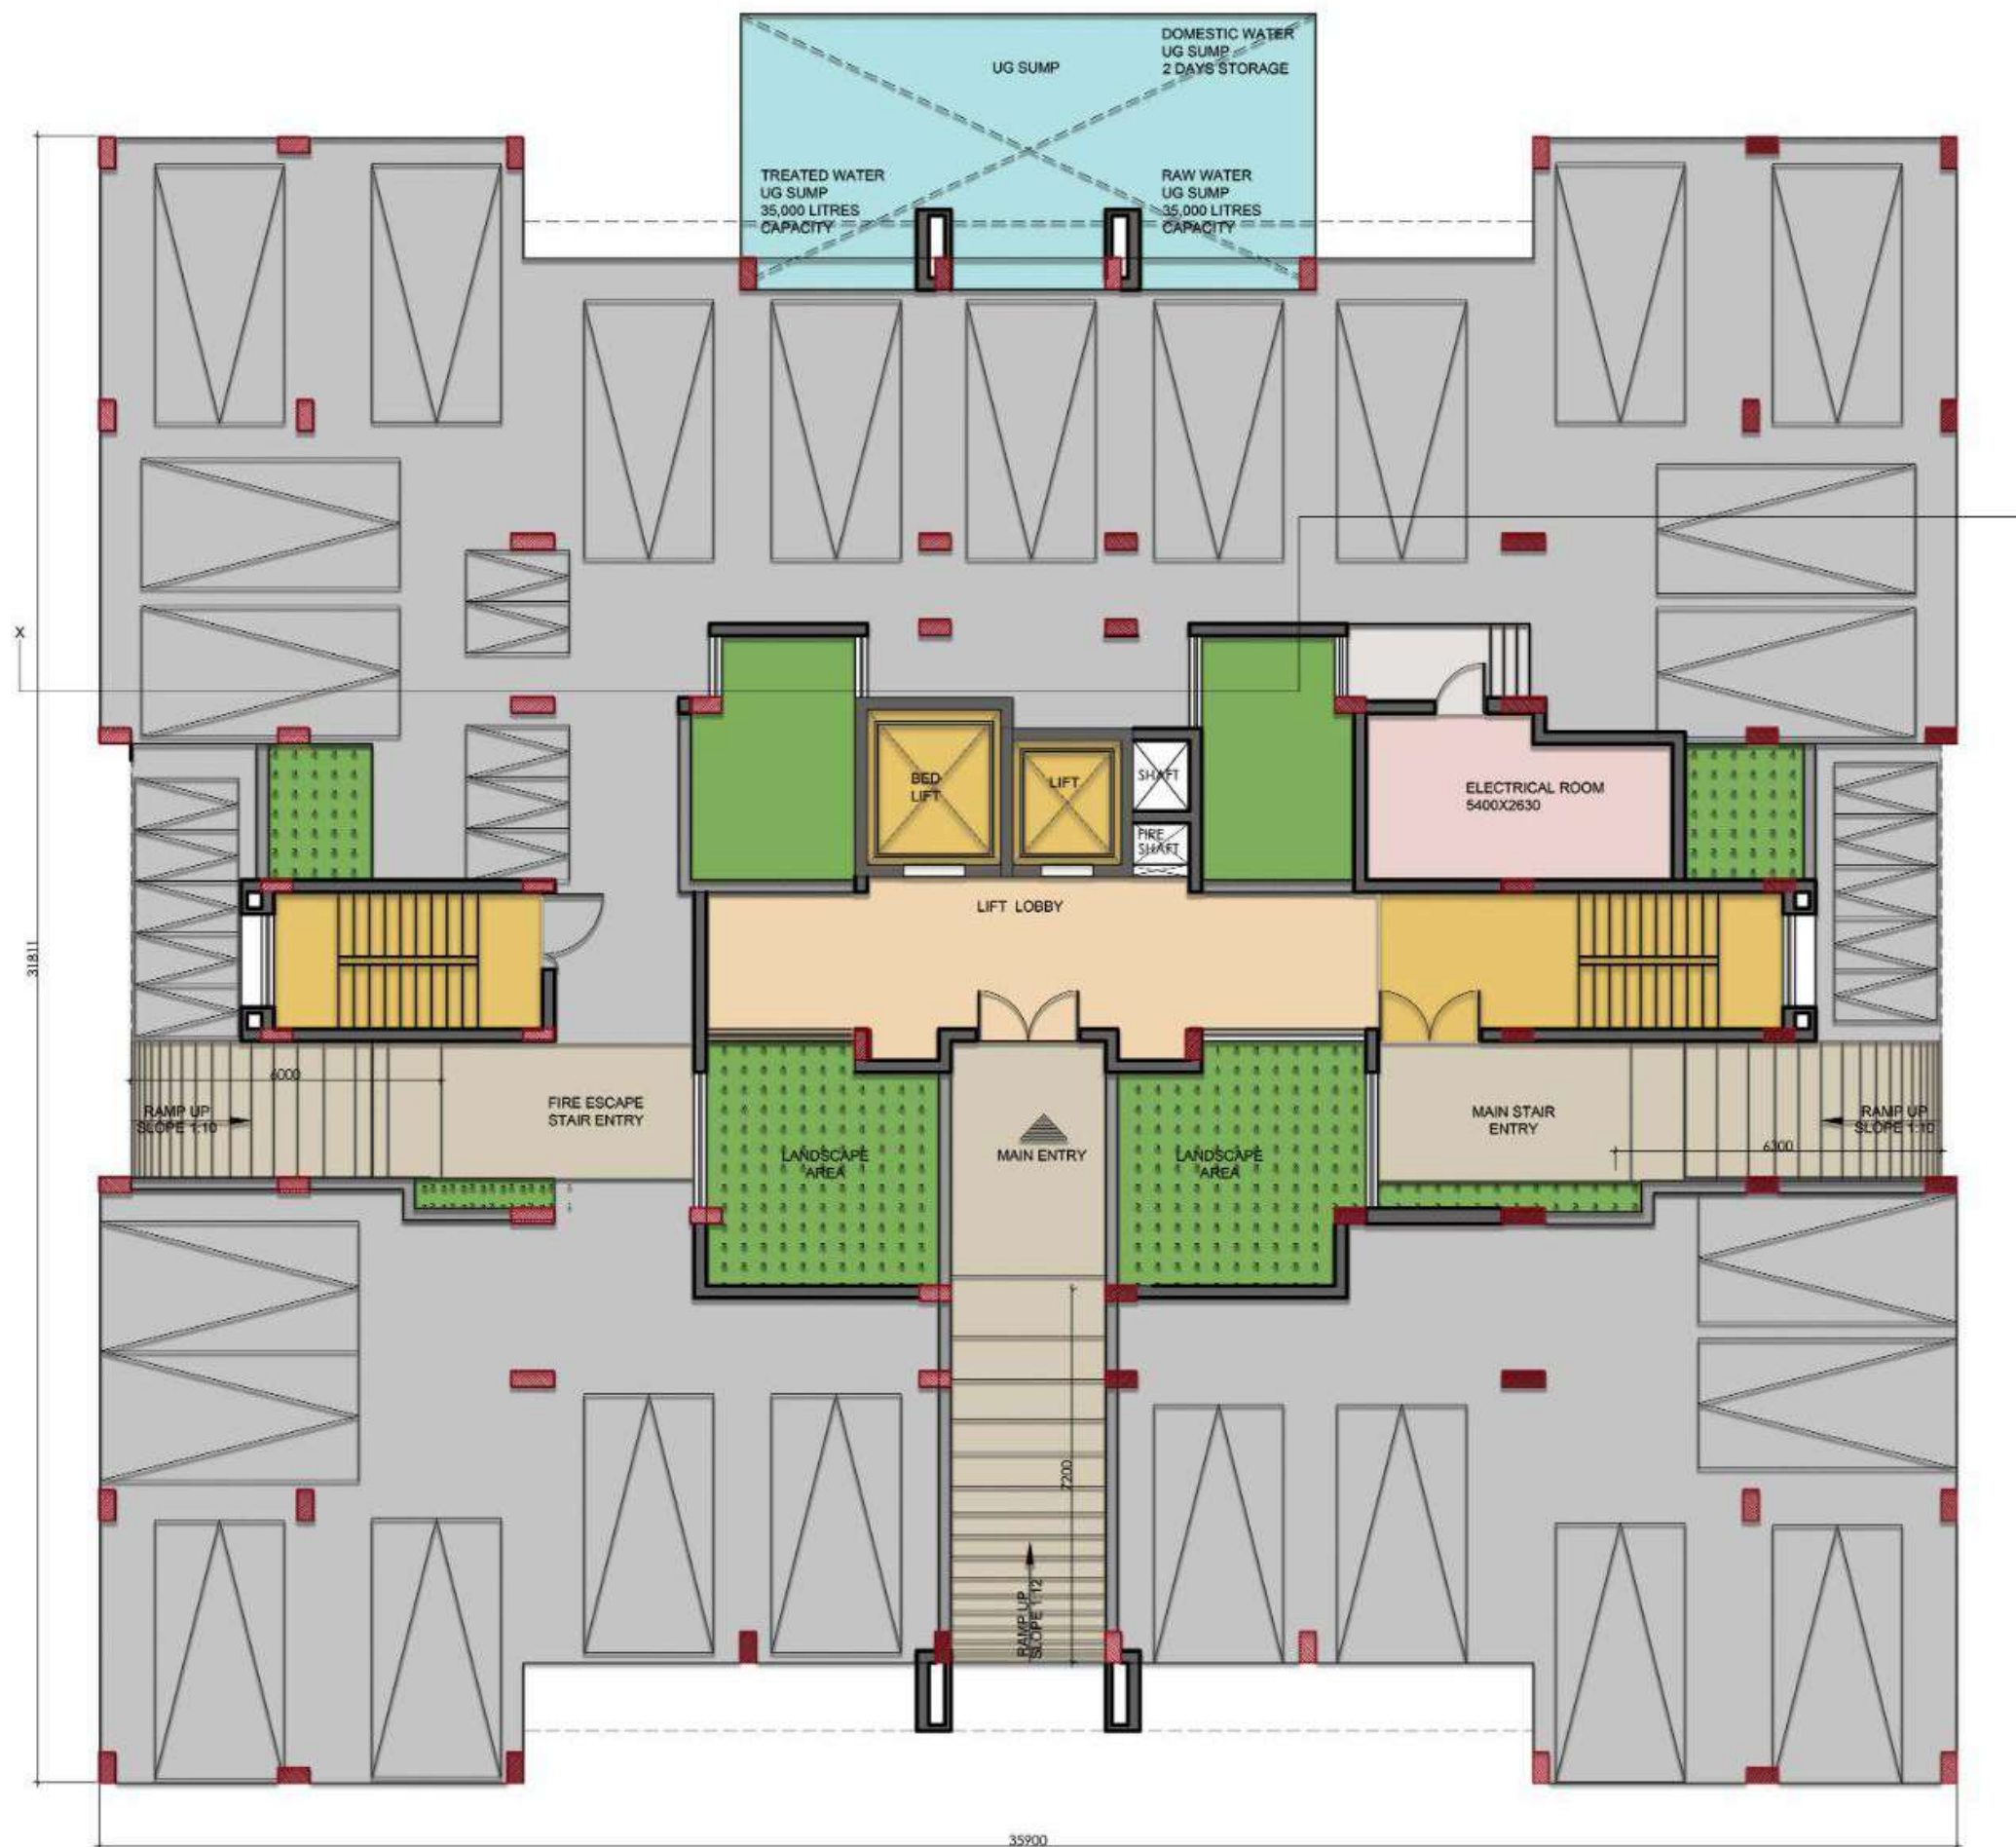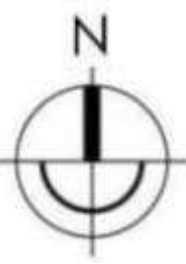


NO. OF CAR PARKING- 25
NO. OF BIKE PARKING- 15



STILT FLOOR PLAN

PROPOSED STAFF QUARTERS - IIT MADRAS, ADYAR, CHENNAI



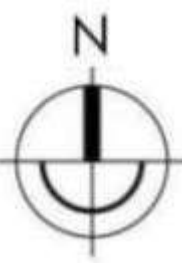


UNIT - 1
AREA - 165 SQ.M

UNIT - 3
AREA - 165 SQ.M

UNIT - 2
AREA - 165 SQ.M

UNIT - 4
AREA - 165 SQ.M

FLOOR PLATE AREA
- 165 SQ.M

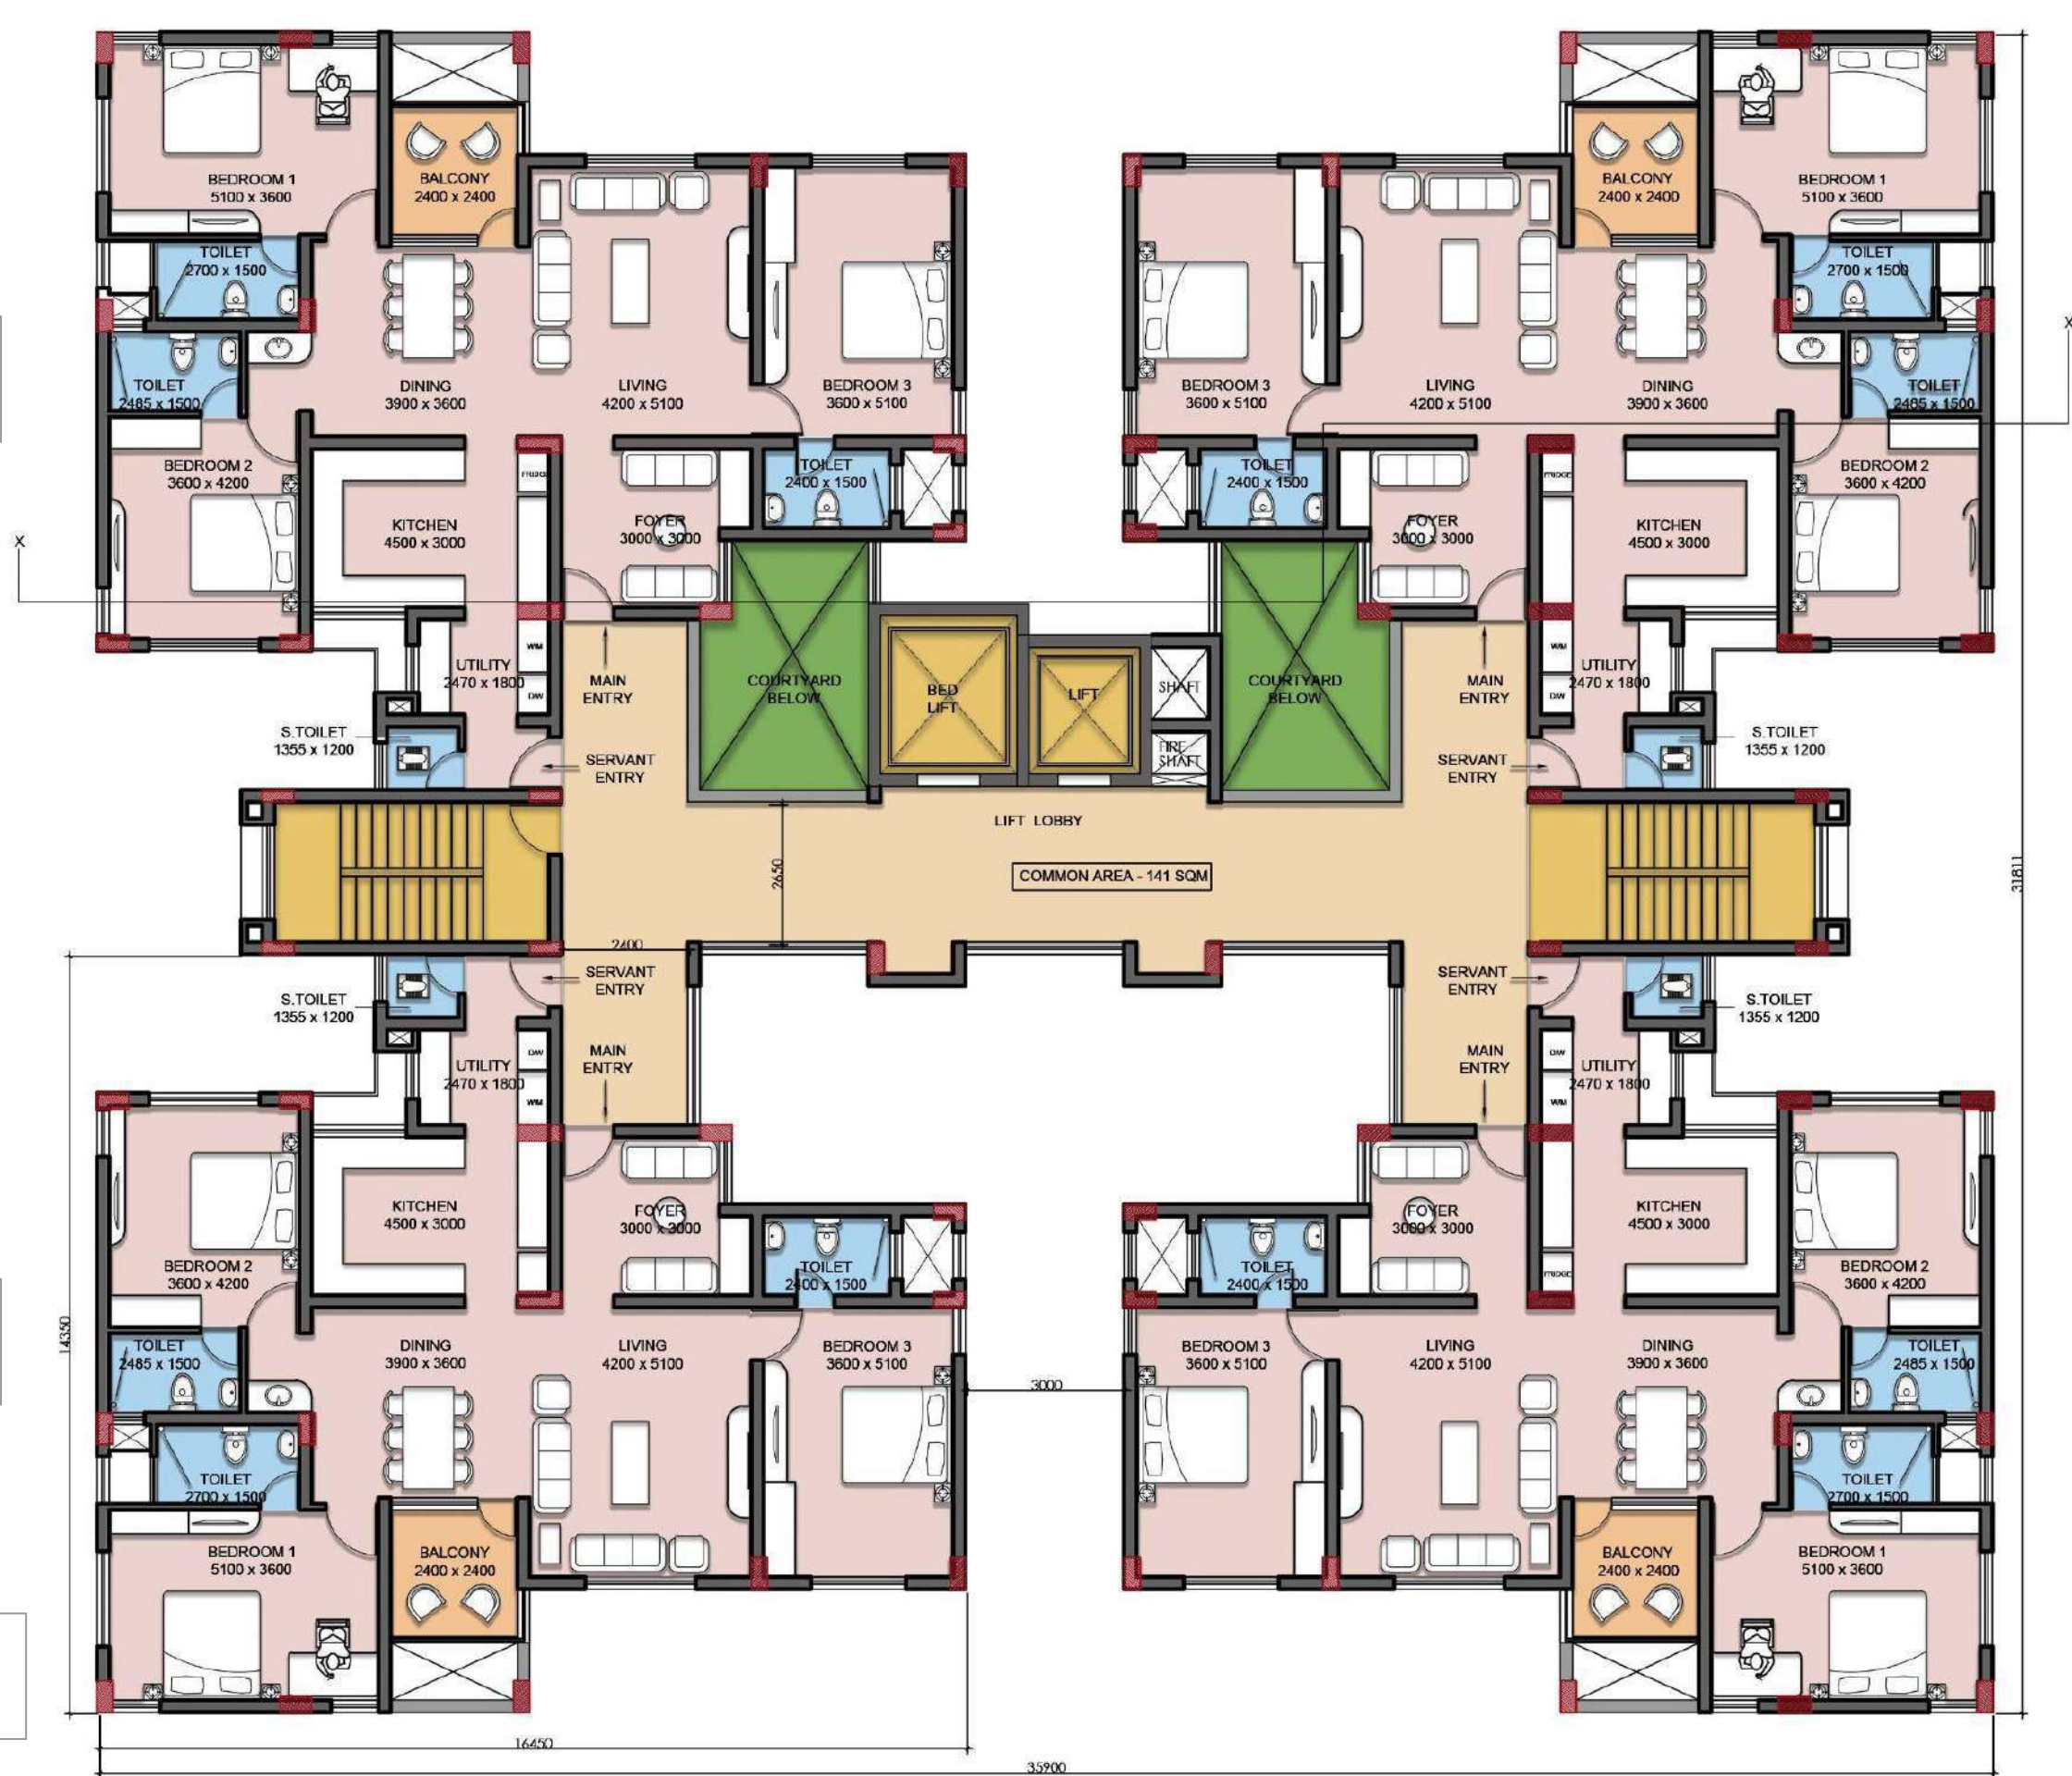

TYPICAL FLOOR PLAN

PROPOSED STAFF QUARTERS - IIT MADRAS, ADYAR, CHENNAI






SECTION XX'

PROPOSED STAFF QUARTERS - IIT MADRAS, ADYAR, CHENNAI



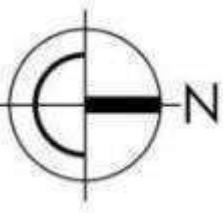



GROUND FLOOR
AREA = 1034 SQM



ACADEMY BLOCK GROUND FLOOR PLAN

PROPOSED ADVOCATE'S ACADEMY, KALAMASSERY, KOCHI



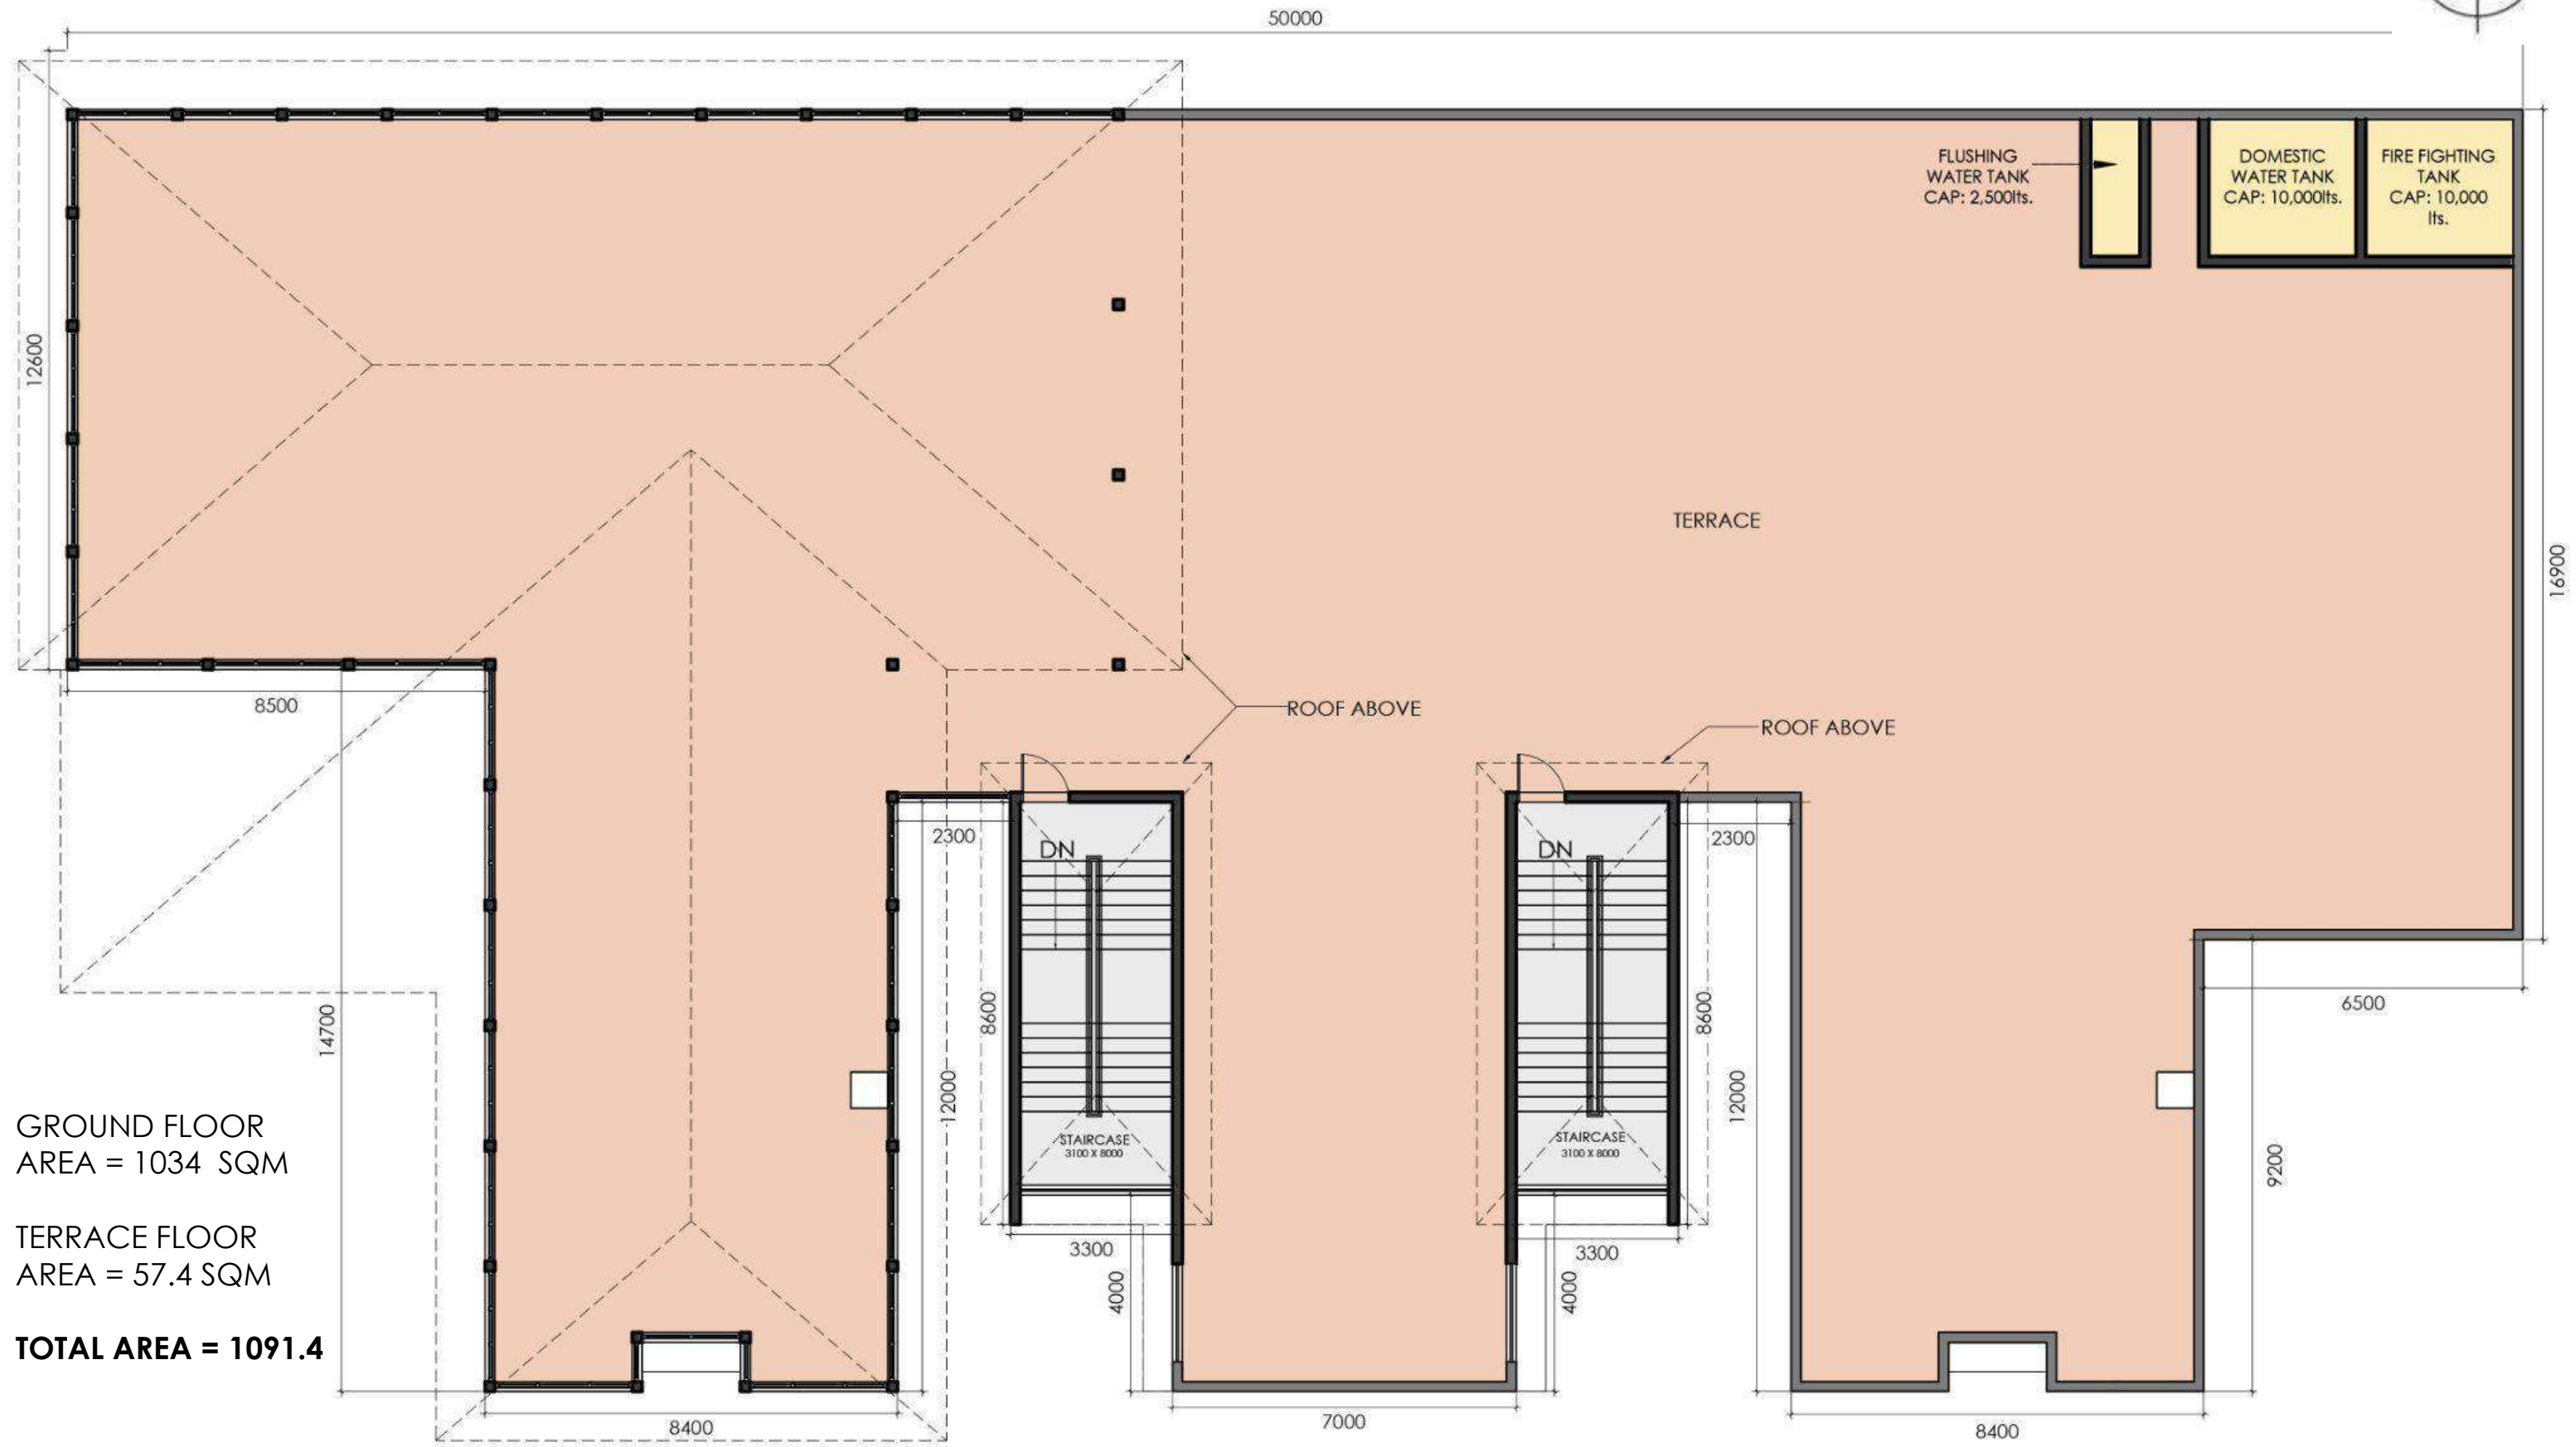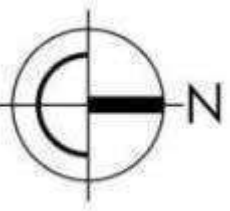

GROUND FLOOR
AREA = 1034 SQM

TERRACE FLOOR
AREA = 57.4 SQM


TOTAL AREA = 1091.4




ACADEMY BLOCK TERRACE FLOOR PLAN

PROPOSED ADVOCATE'S ACADEMY, KALAMASSERY, KOCHI




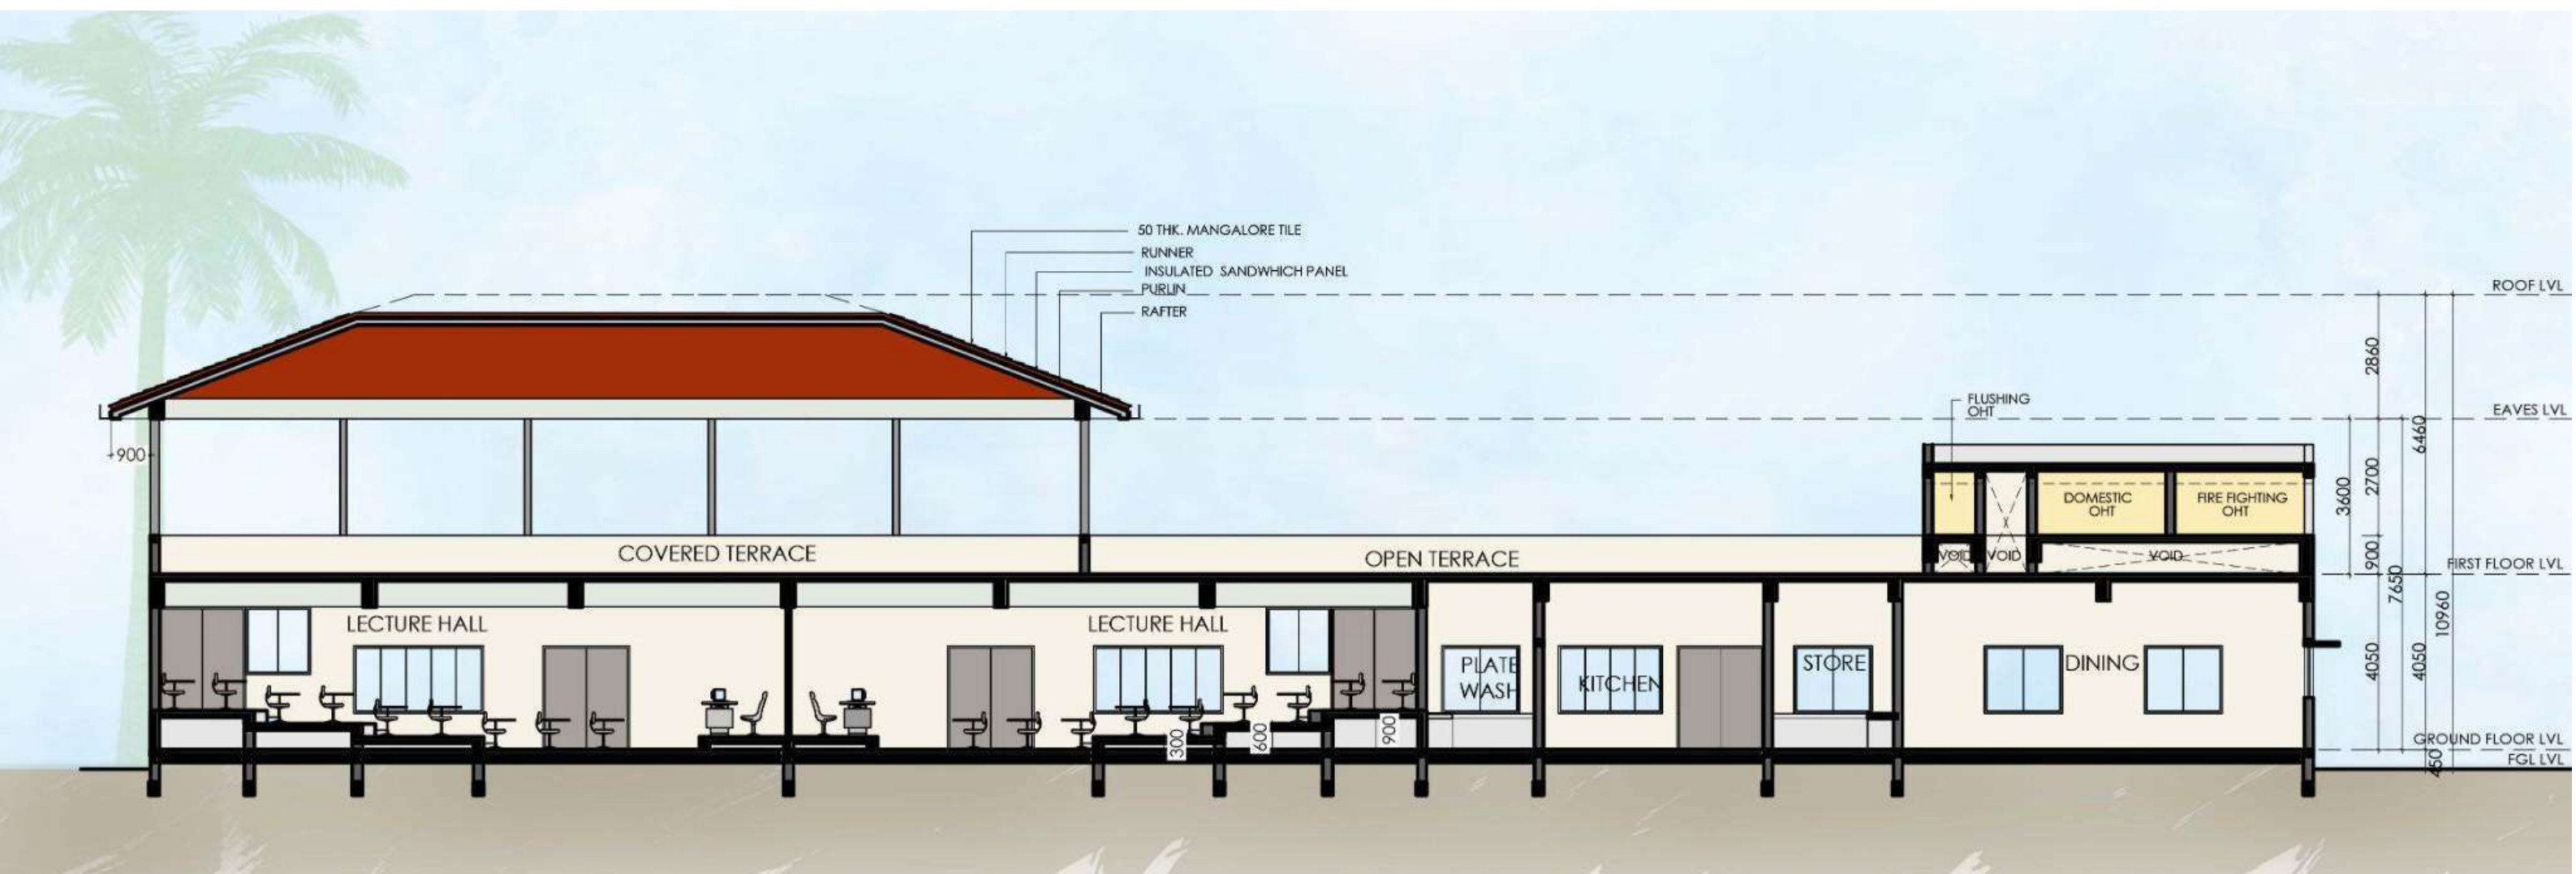


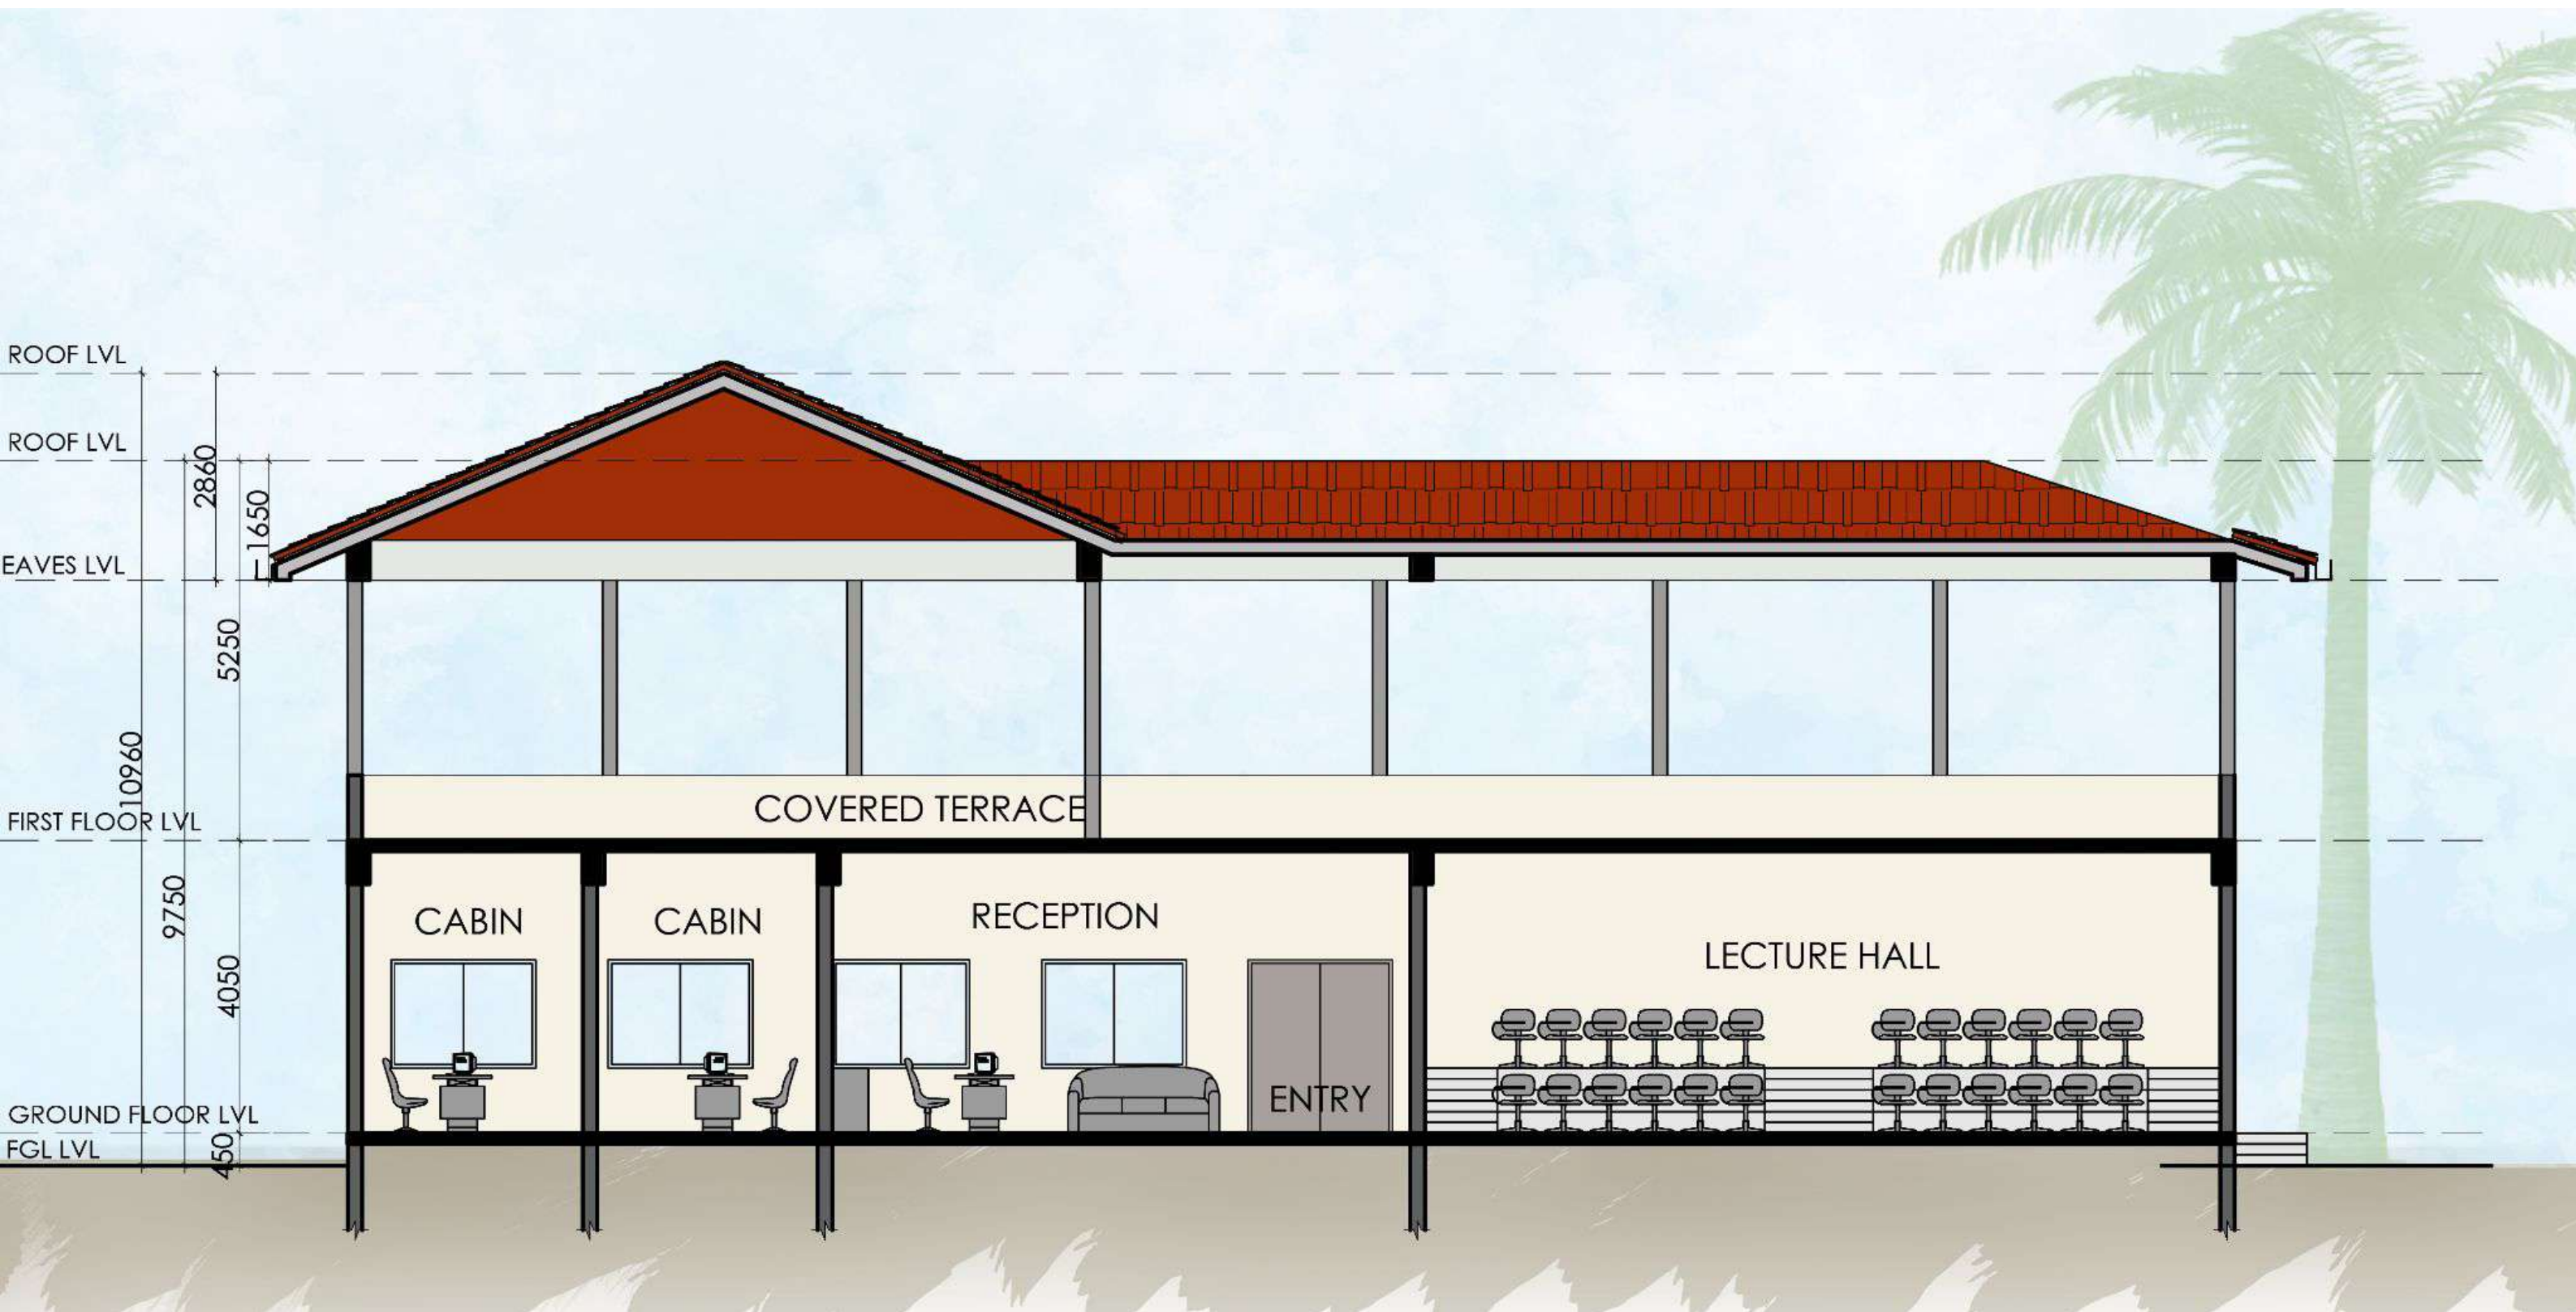

SECTION BB

PROPOSED ADVOCATE'S ACADEMY, KALAMASSERY, KOCHI



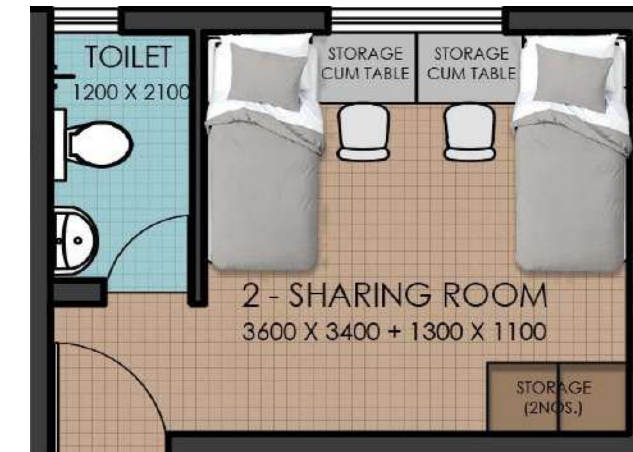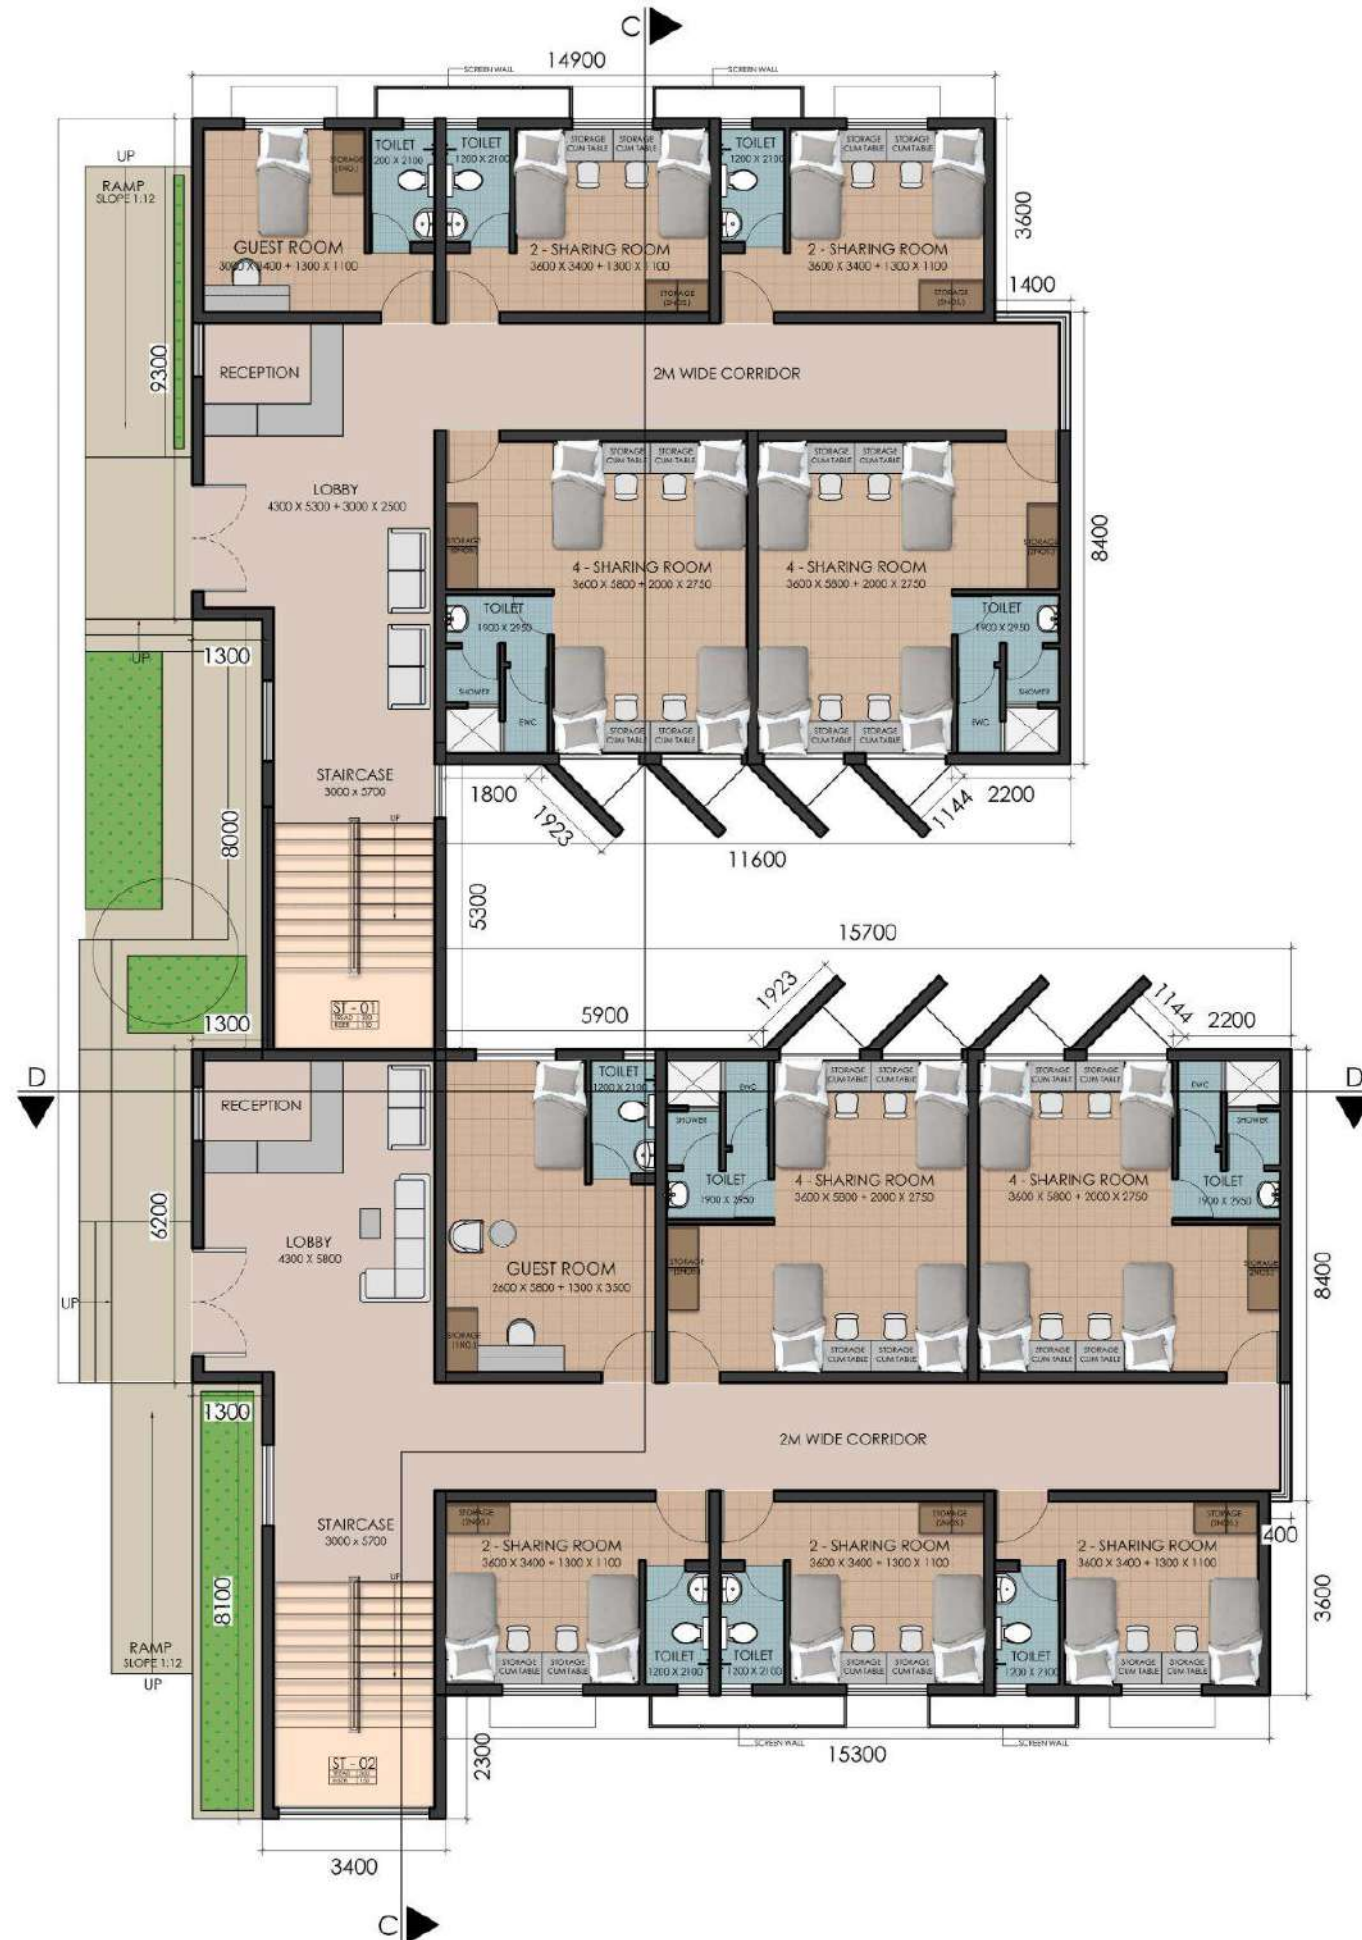

2- SHARING ROOM LAYOUT

BOYS HOSTEL:



NO. OF 2-SHARING ROOMS = 3 ROOMS
 NO. OF 4-SHARING ROOMS = 2 ROOMS
 NO. OF GUEST ROOMS = 1 ROOM
 TOTAL NO. OF ROOMS = 6 ROOMS

GIRLS HOSTEL:

NO. OF 2-SHARING ROOMS = 2 ROOMS
 NO. OF 4-SHARING ROOMS = 2 ROOMS
 NO. OF GUEST ROOMS = 1 ROOM
 TOTAL NO. OF ROOMS = 5 ROOMS

CARPET AREA OF 2-SHARING ROOM +
 ATTACHED TOILET = 16.65 SQM
 CARPET AREA OF 4-SHARING ROOM +
 ATTACHED TOILET = 32.47 SQM

GROUND FLOOR AREA = 445.32 SQM

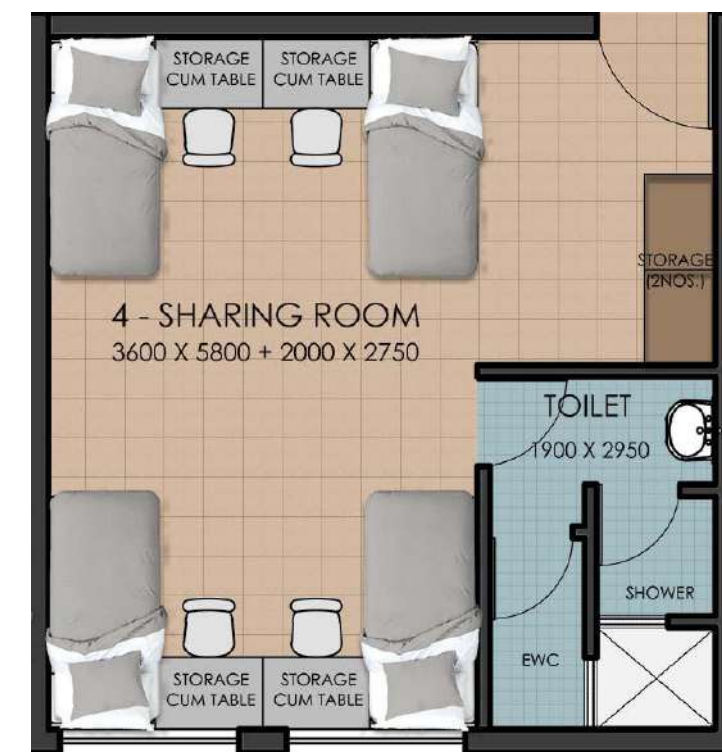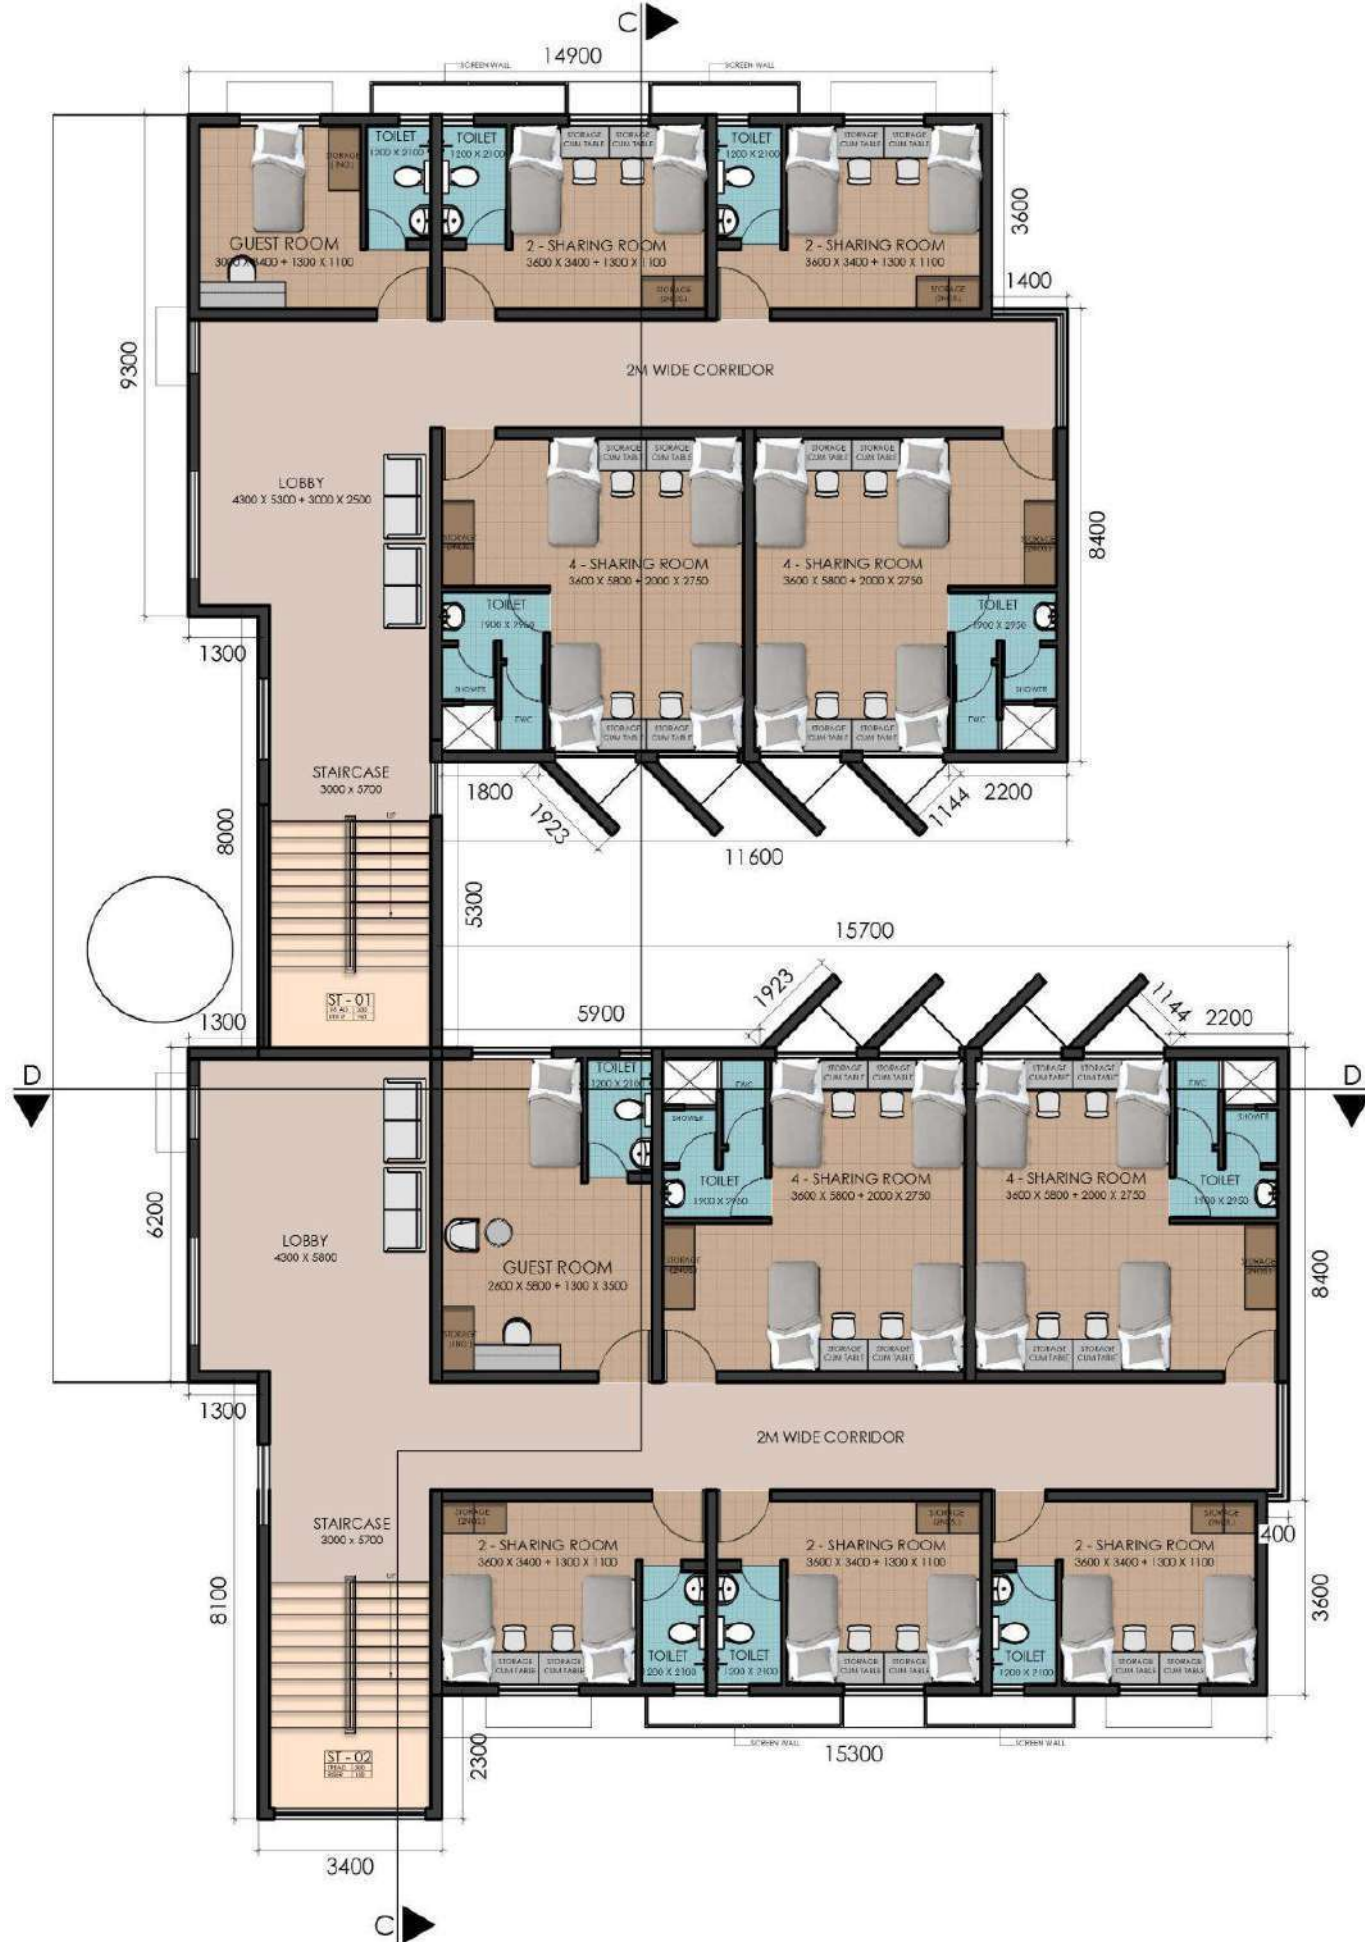

4- SHARING ROOM LAYOUT

BOYS HOSTEL:

NO. OF 2-SHARING ROOMS = 3 ROOMS
 NO. OF 4-SHARING ROOMS = 2 ROOMS
 NO. OF GUEST ROOMS = 1 ROOM
 TOTAL NO. OF ROOMS = 6 ROOMS

GIRLS HOSTEL:

NO. OF 2-SHARING ROOMS = 2 ROOMS
 NO. OF 4-SHARING ROOMS = 2 ROOMS
 NO. OF GUEST ROOMS = 1 ROOM
 TOTAL NO. OF ROOMS = 5 ROOMS

CARPET AREA OF 2-SHARING ROOM + ATTACHED TOILET
 = 16.65 SQM



CARPET AREA OF 4-SHARING ROOM + ATTACHED TOILET
 = 32.47 SQM

FIRST FLOOR AREA = 445.32 SQM

SECOND FLOOR AREA = 445.32 SQM

**ACCOMMODATION BLOCK
 TYPICAL FLOOR PLAN(1ST & 2ND FLOOR)**

PROPOSED ADVOCATE'S ACADEMY, KALAMASSERY, KOCHI

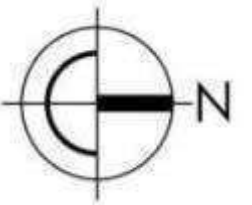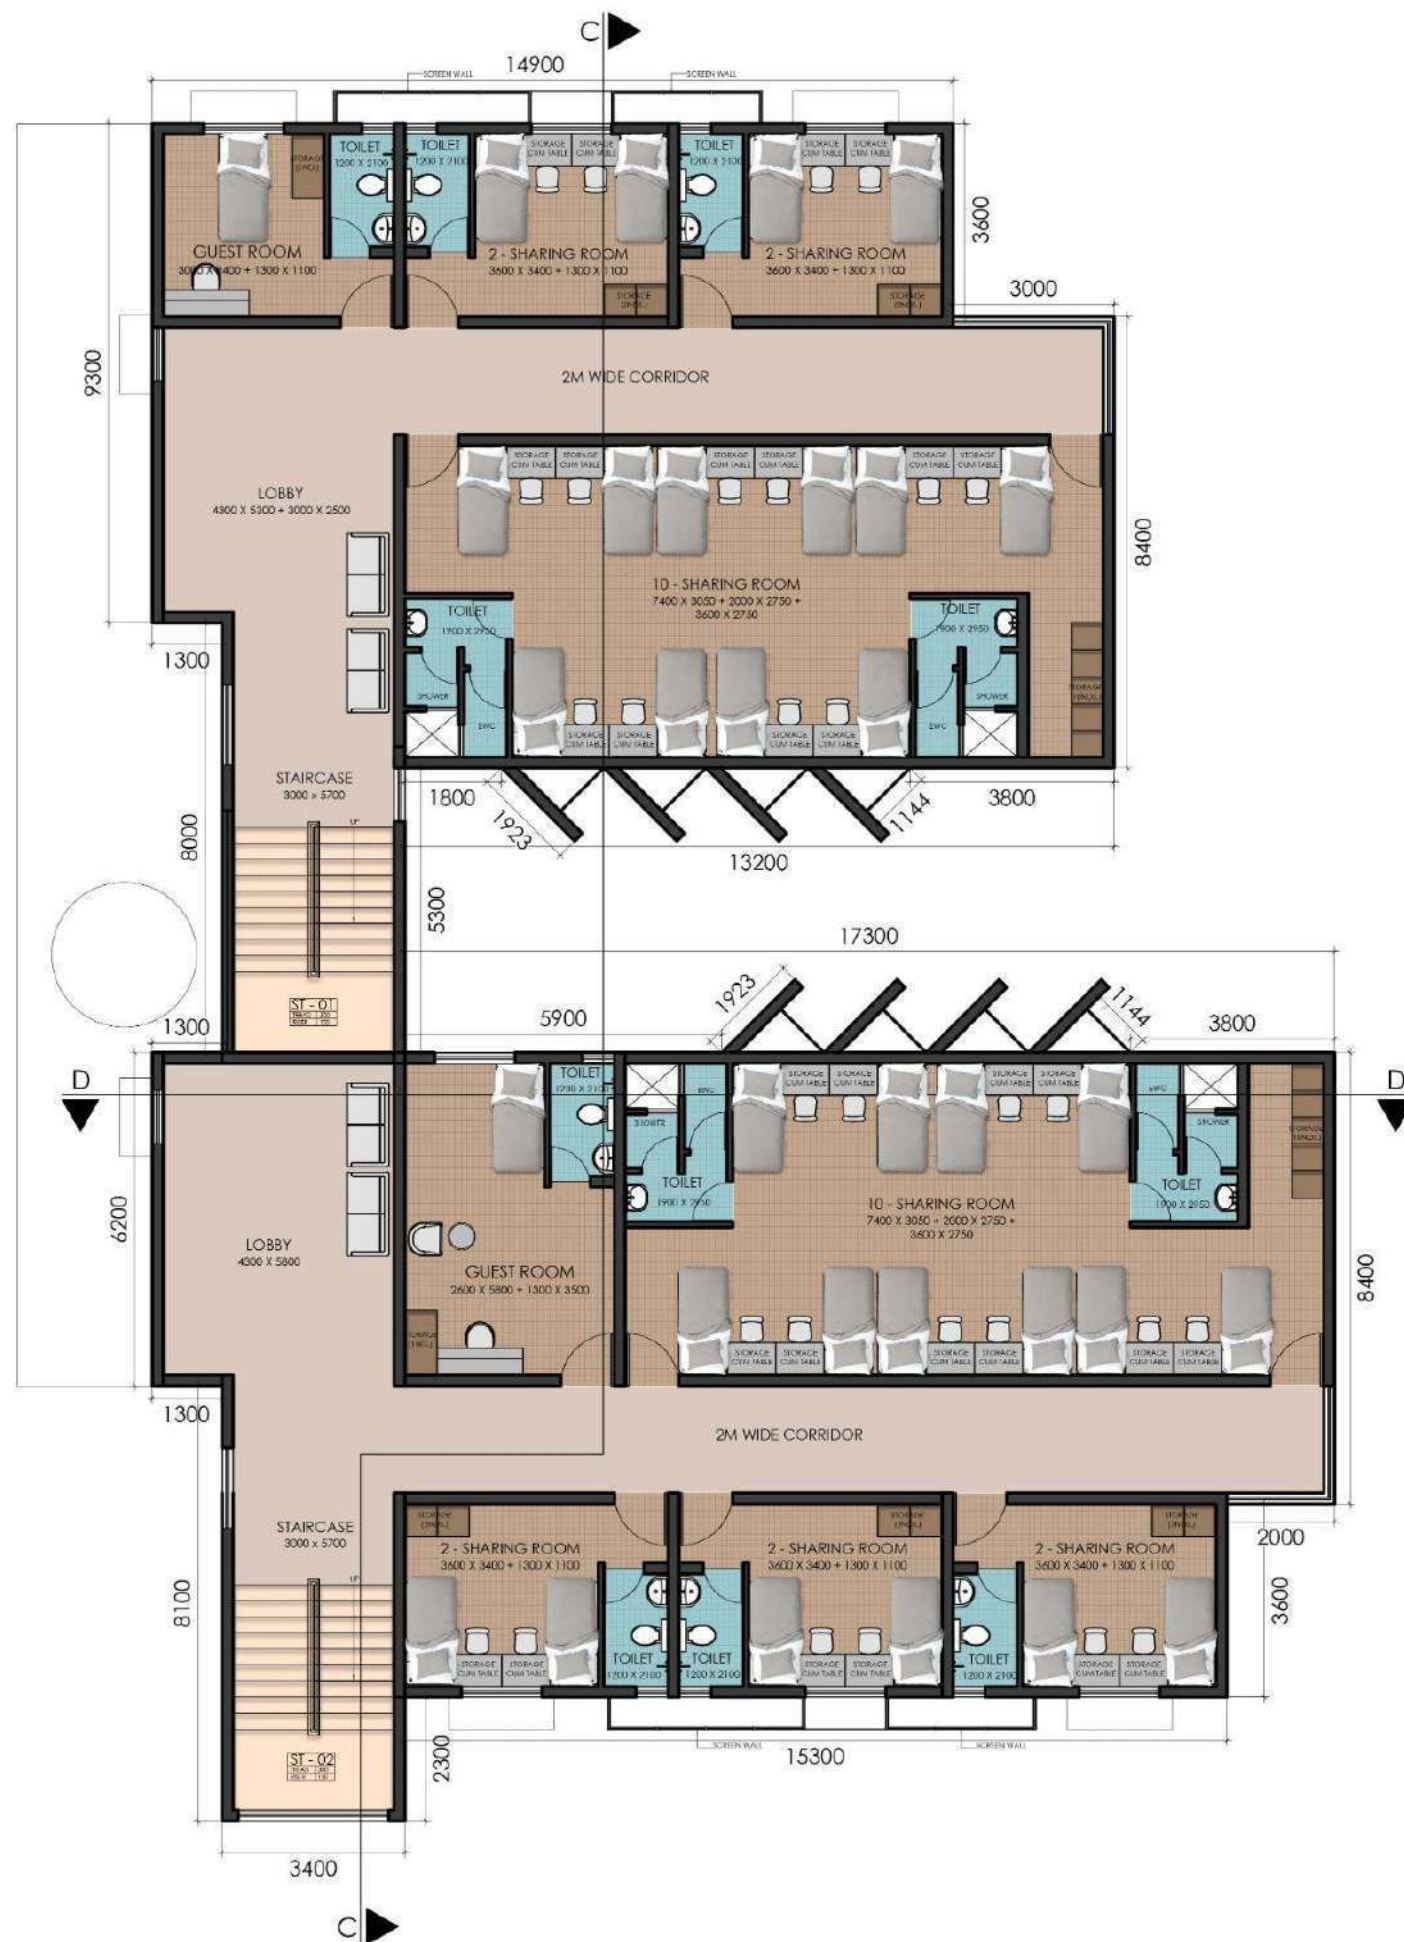

BOYS HOSTEL:



NO. OF 2-SHARING ROOMS = 3 ROOMS
 NO. OF 10-SHARING ROOMS = 1 ROOM
 NO. OF GUEST ROOMS = 1 ROOM
 TOTAL NO. OF ROOMS = 5 ROOMS

GIRLS HOSTEL:

NO. OF 2-SHARING ROOMS = 2 ROOMS
 NO. OF 10-SHARING ROOMS = 1 ROOM
 NO. OF GUEST ROOMS = 1 ROOM
 TOTAL NO. OF ROOMS = 4 ROOMS


CARPET AREA OF 2-SHARING ROOM + ATTACHED TOILET = 16.65 SQM
 CARPET AREA OF 10-SHARING ROOM + ATTACHED TOILET = 75.39 SQM

THIRD FLOOR AREA = 472.19 SQM

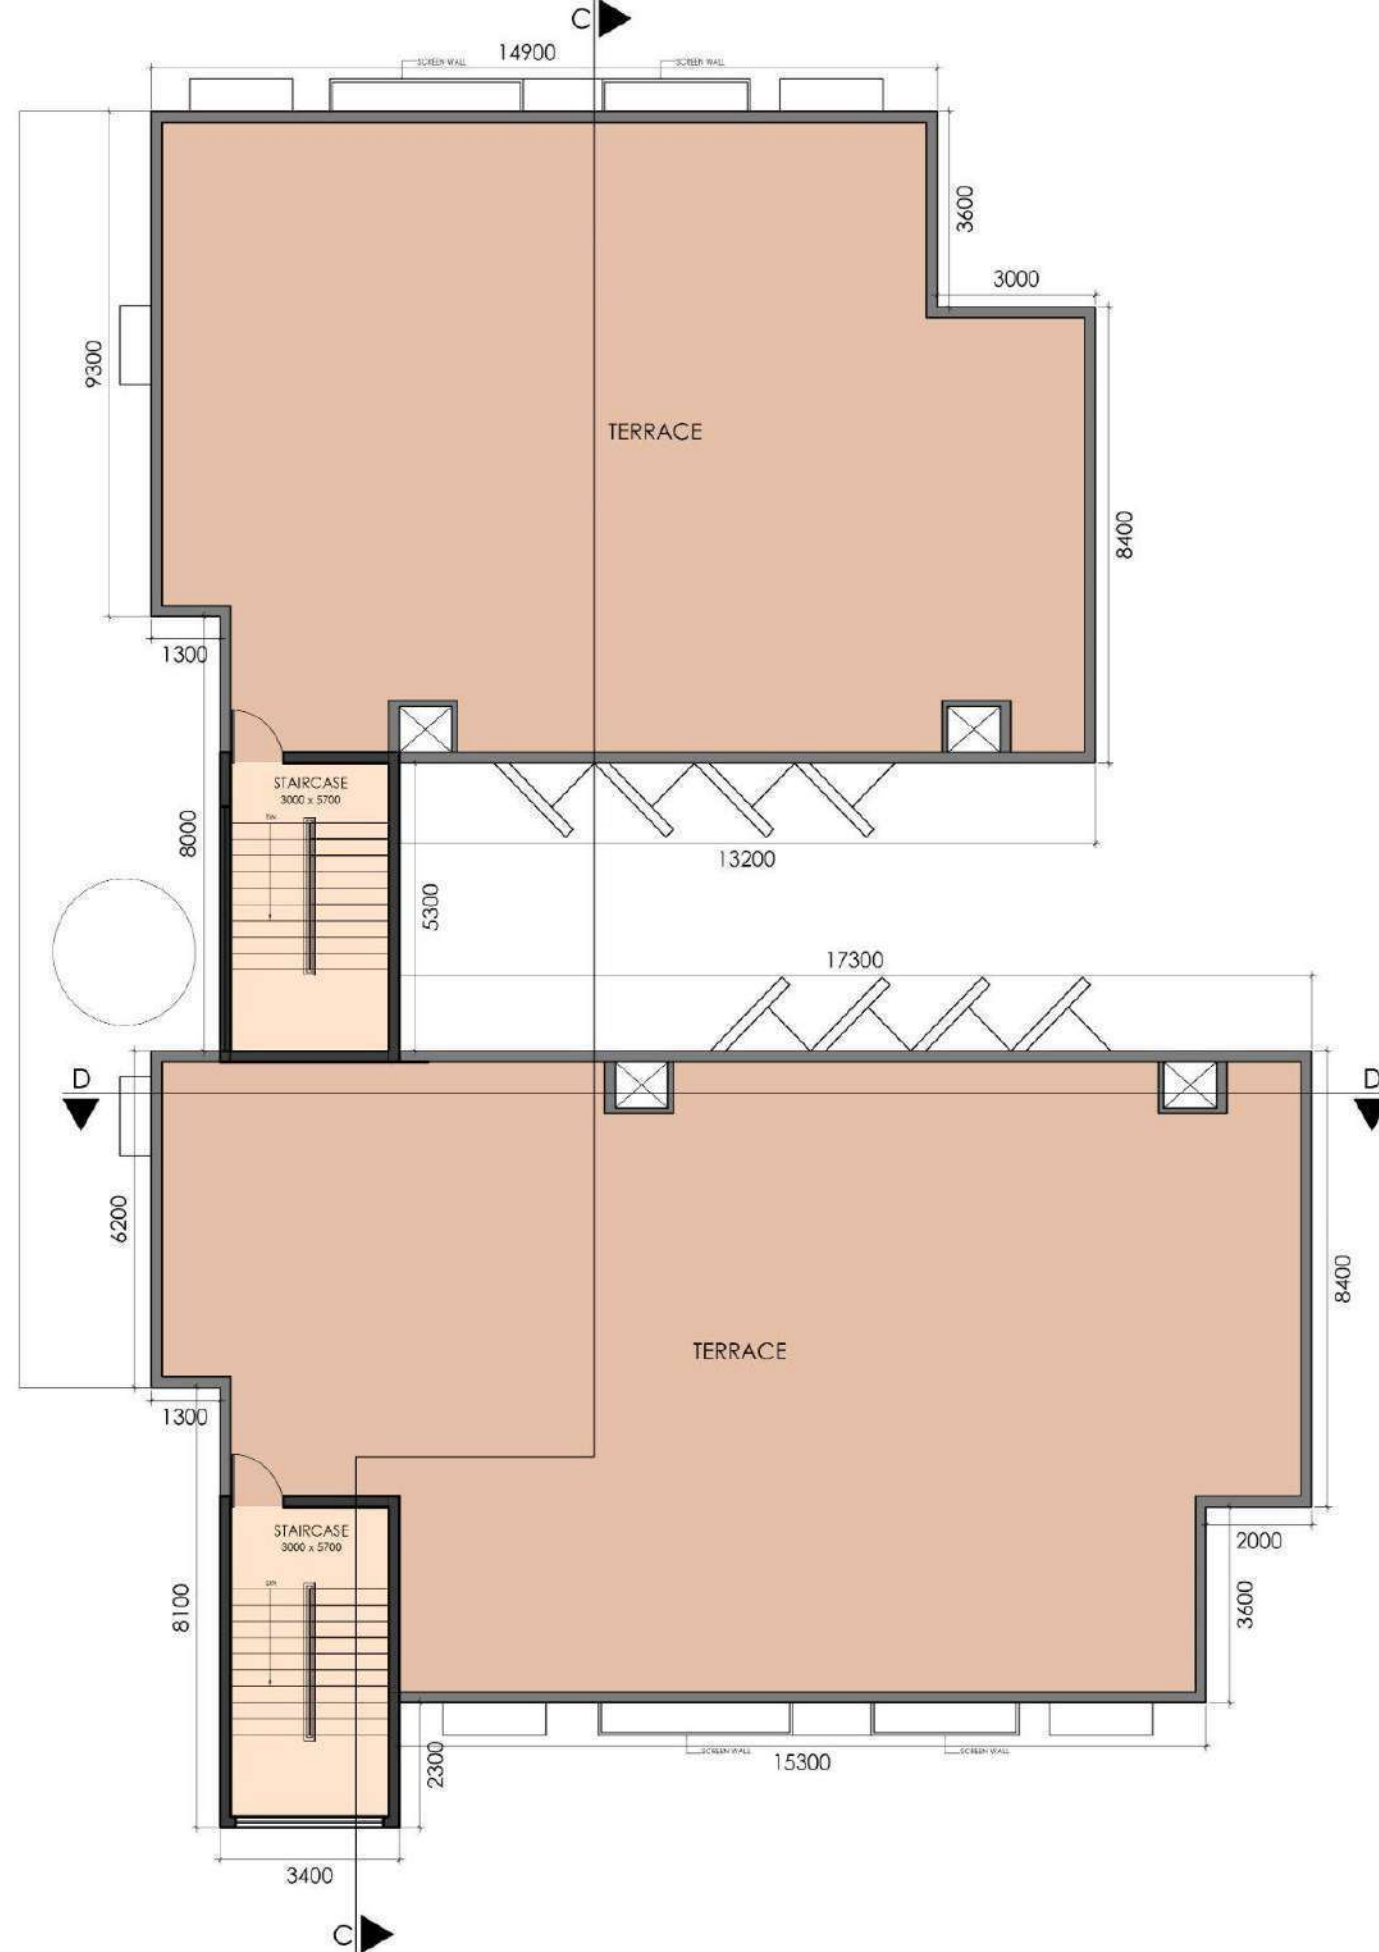
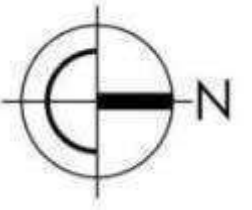


GROUND FLOOR AREA = 445.32 SQM
FIRST FLOOR AREA = 445.32 SQM
SECOND FLOOR AREA = 445.32 SQM
THIRD FLOOR AREA = 472.19 SQM
TERRACE FLOOR AREA = 40.11 SQM


TOTAL AREA (G+3) = 1848.26 SQM

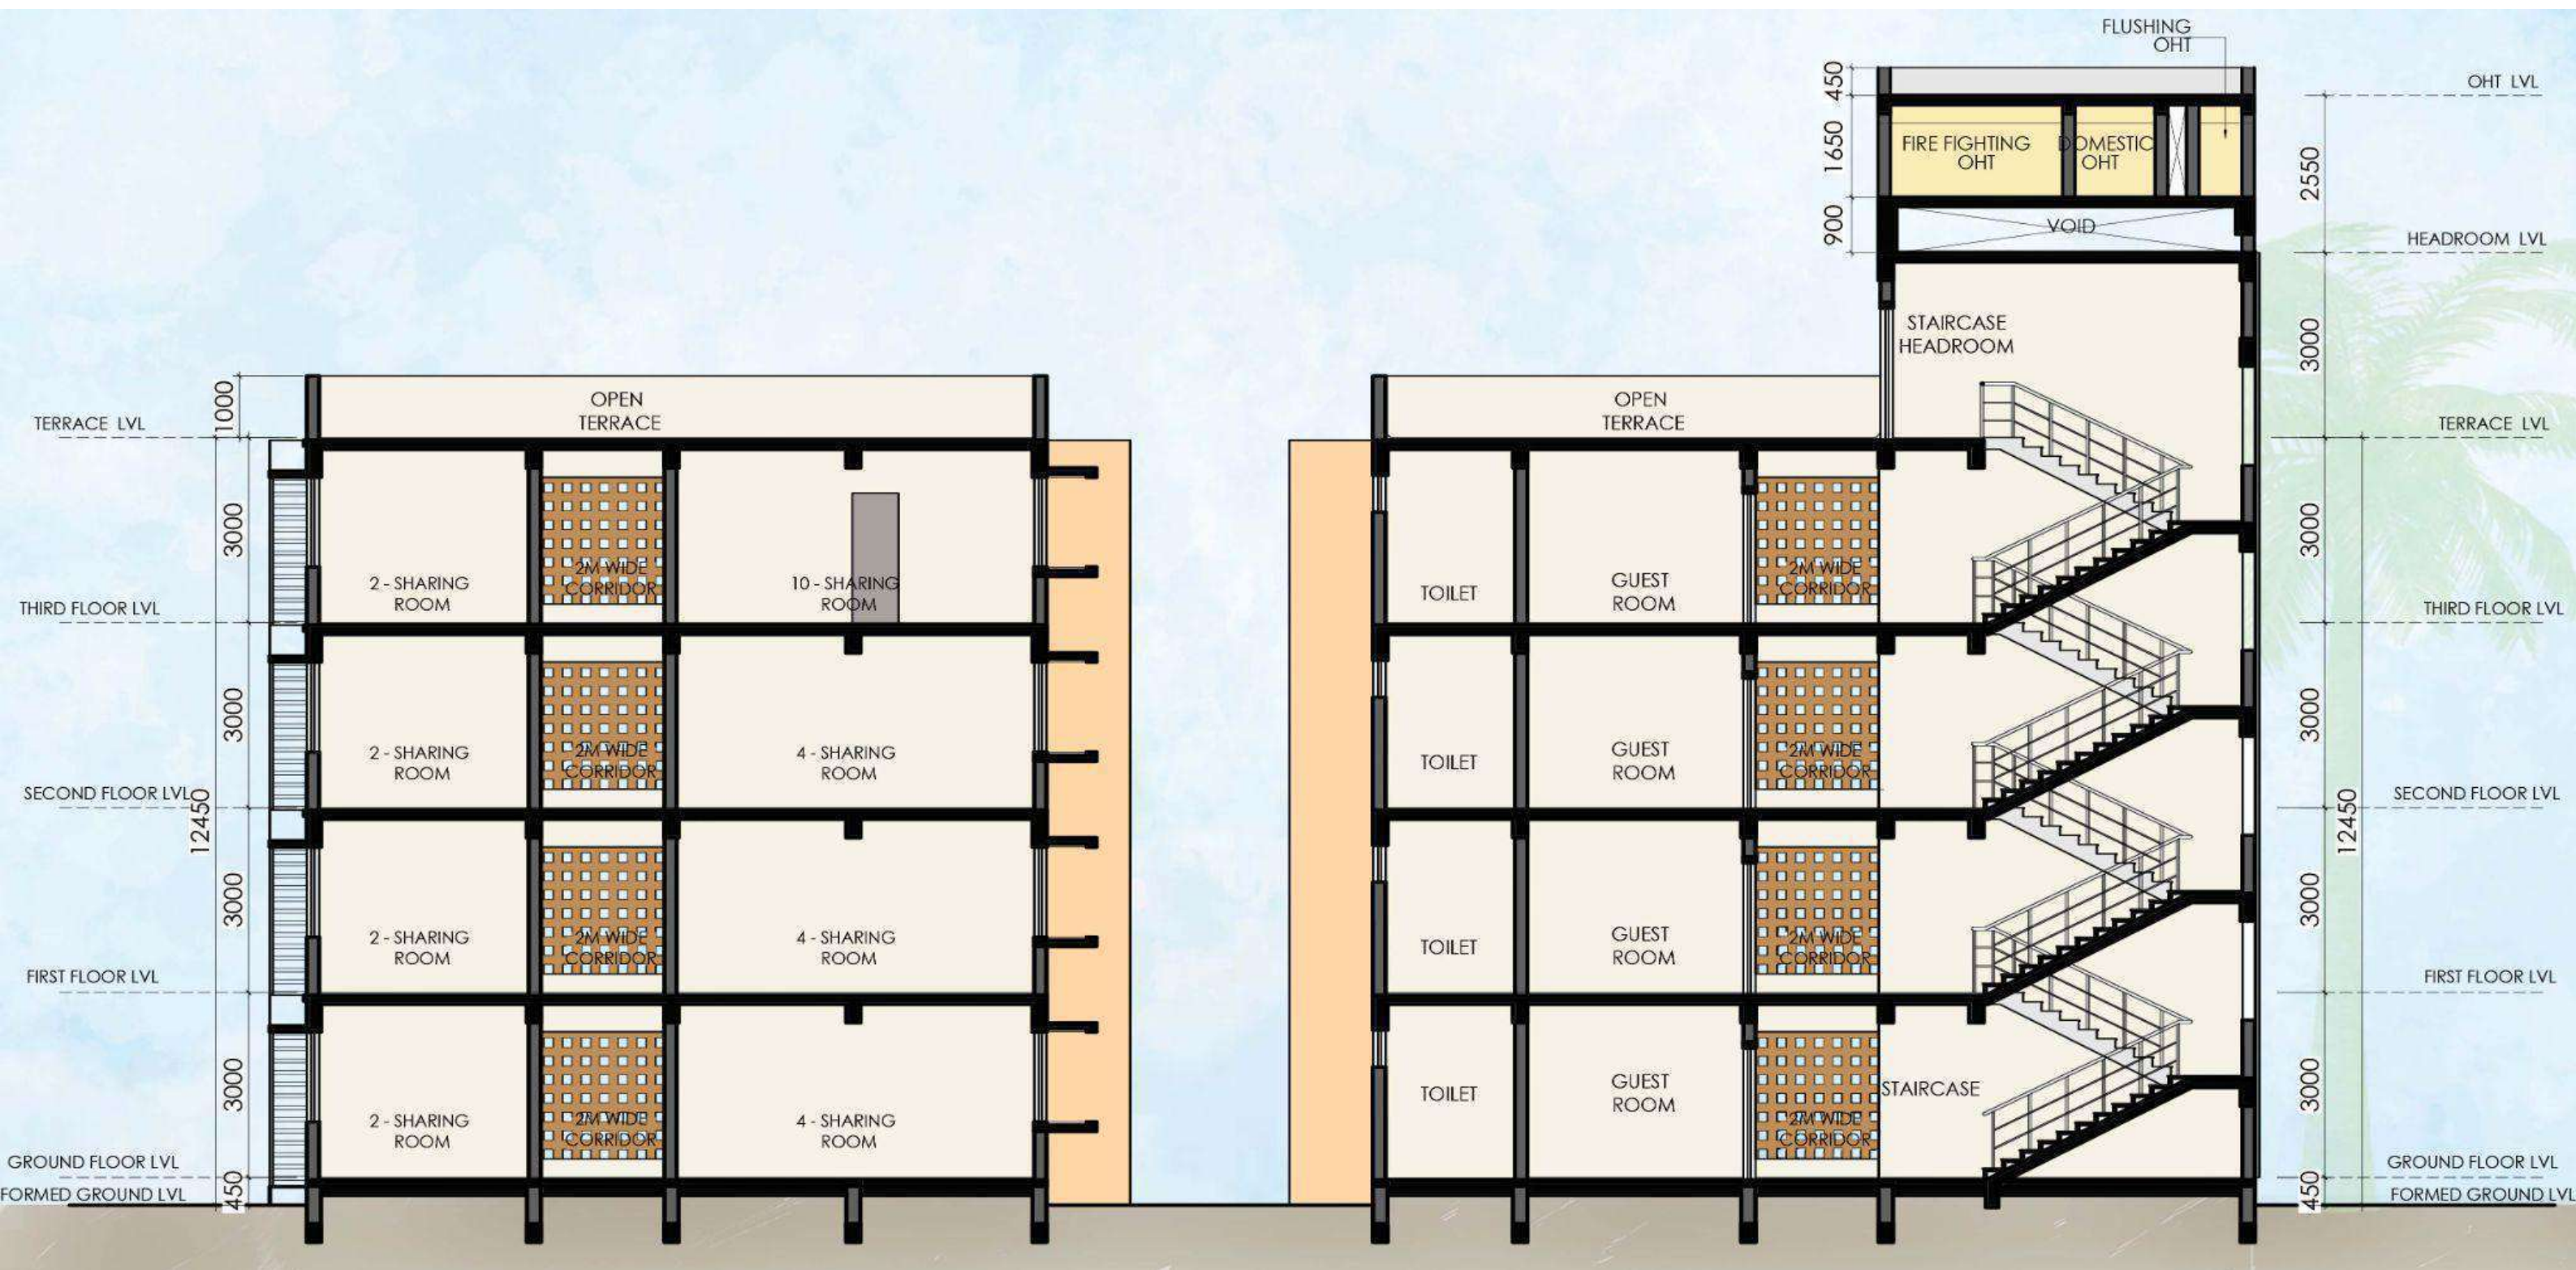



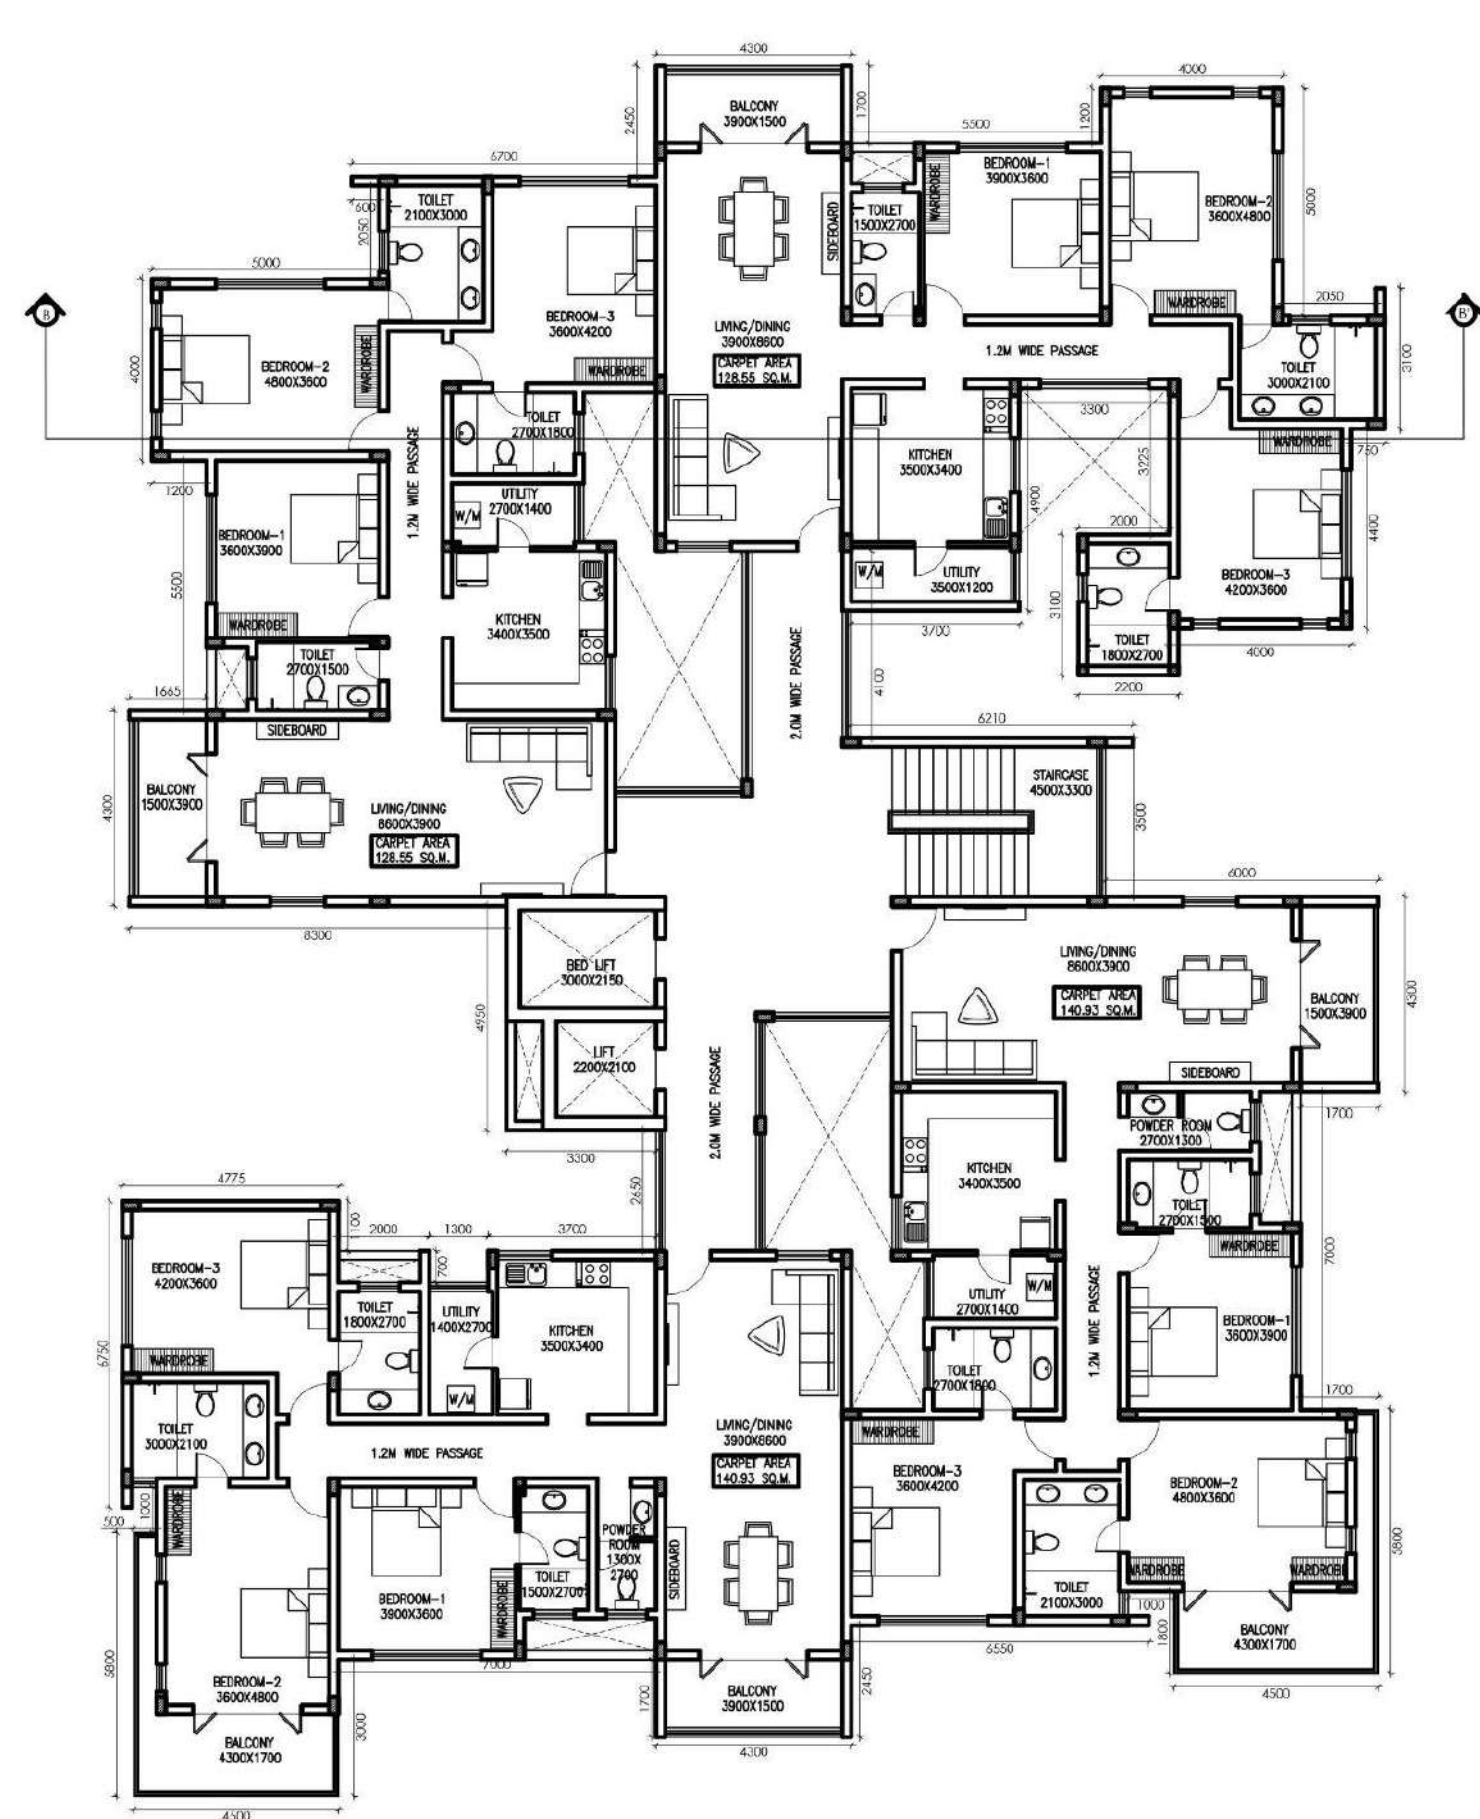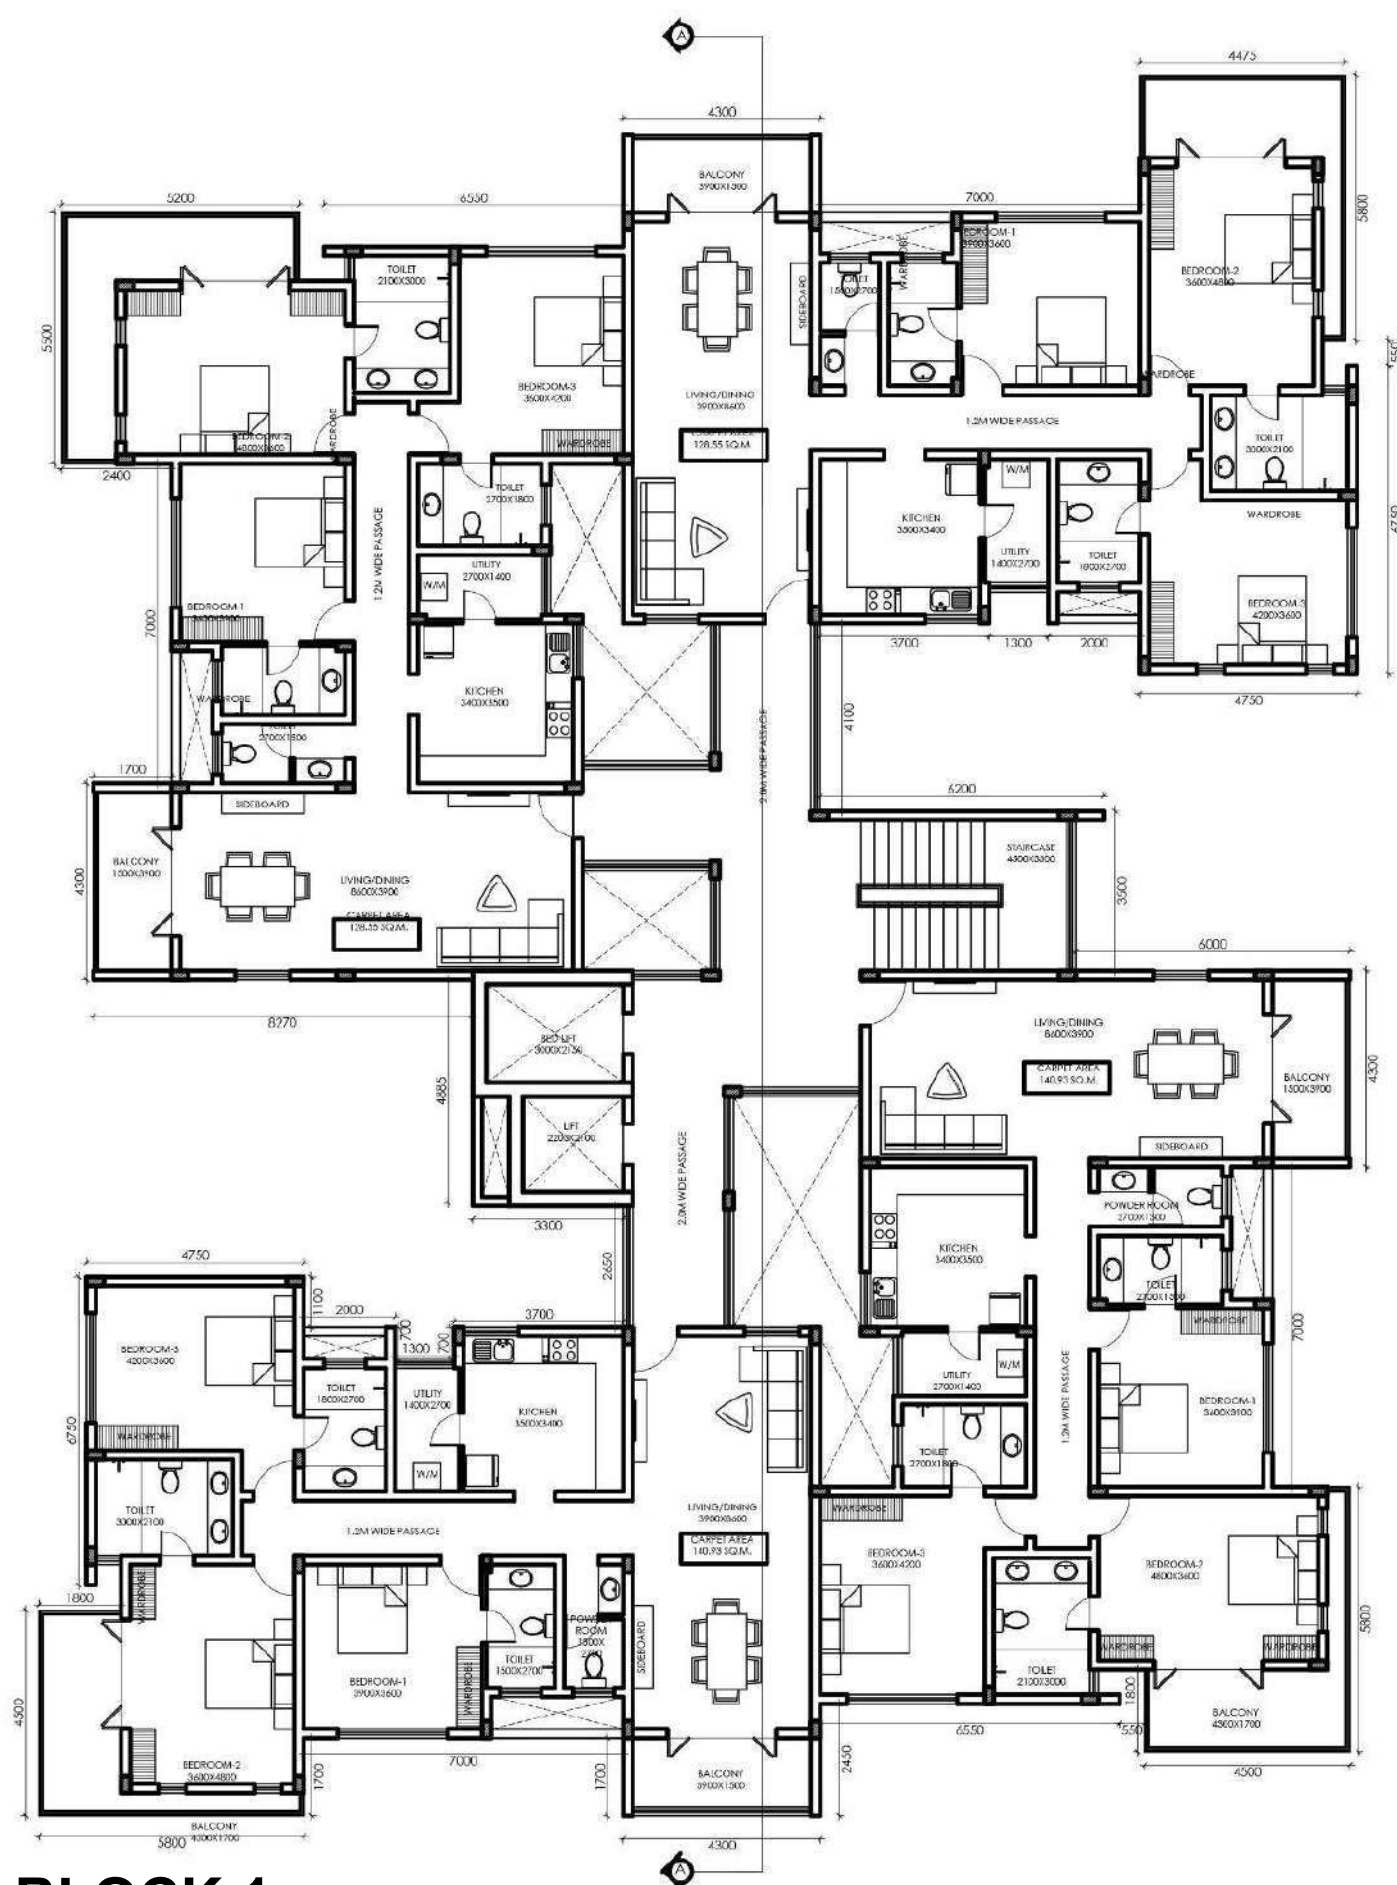

BLOCK 2

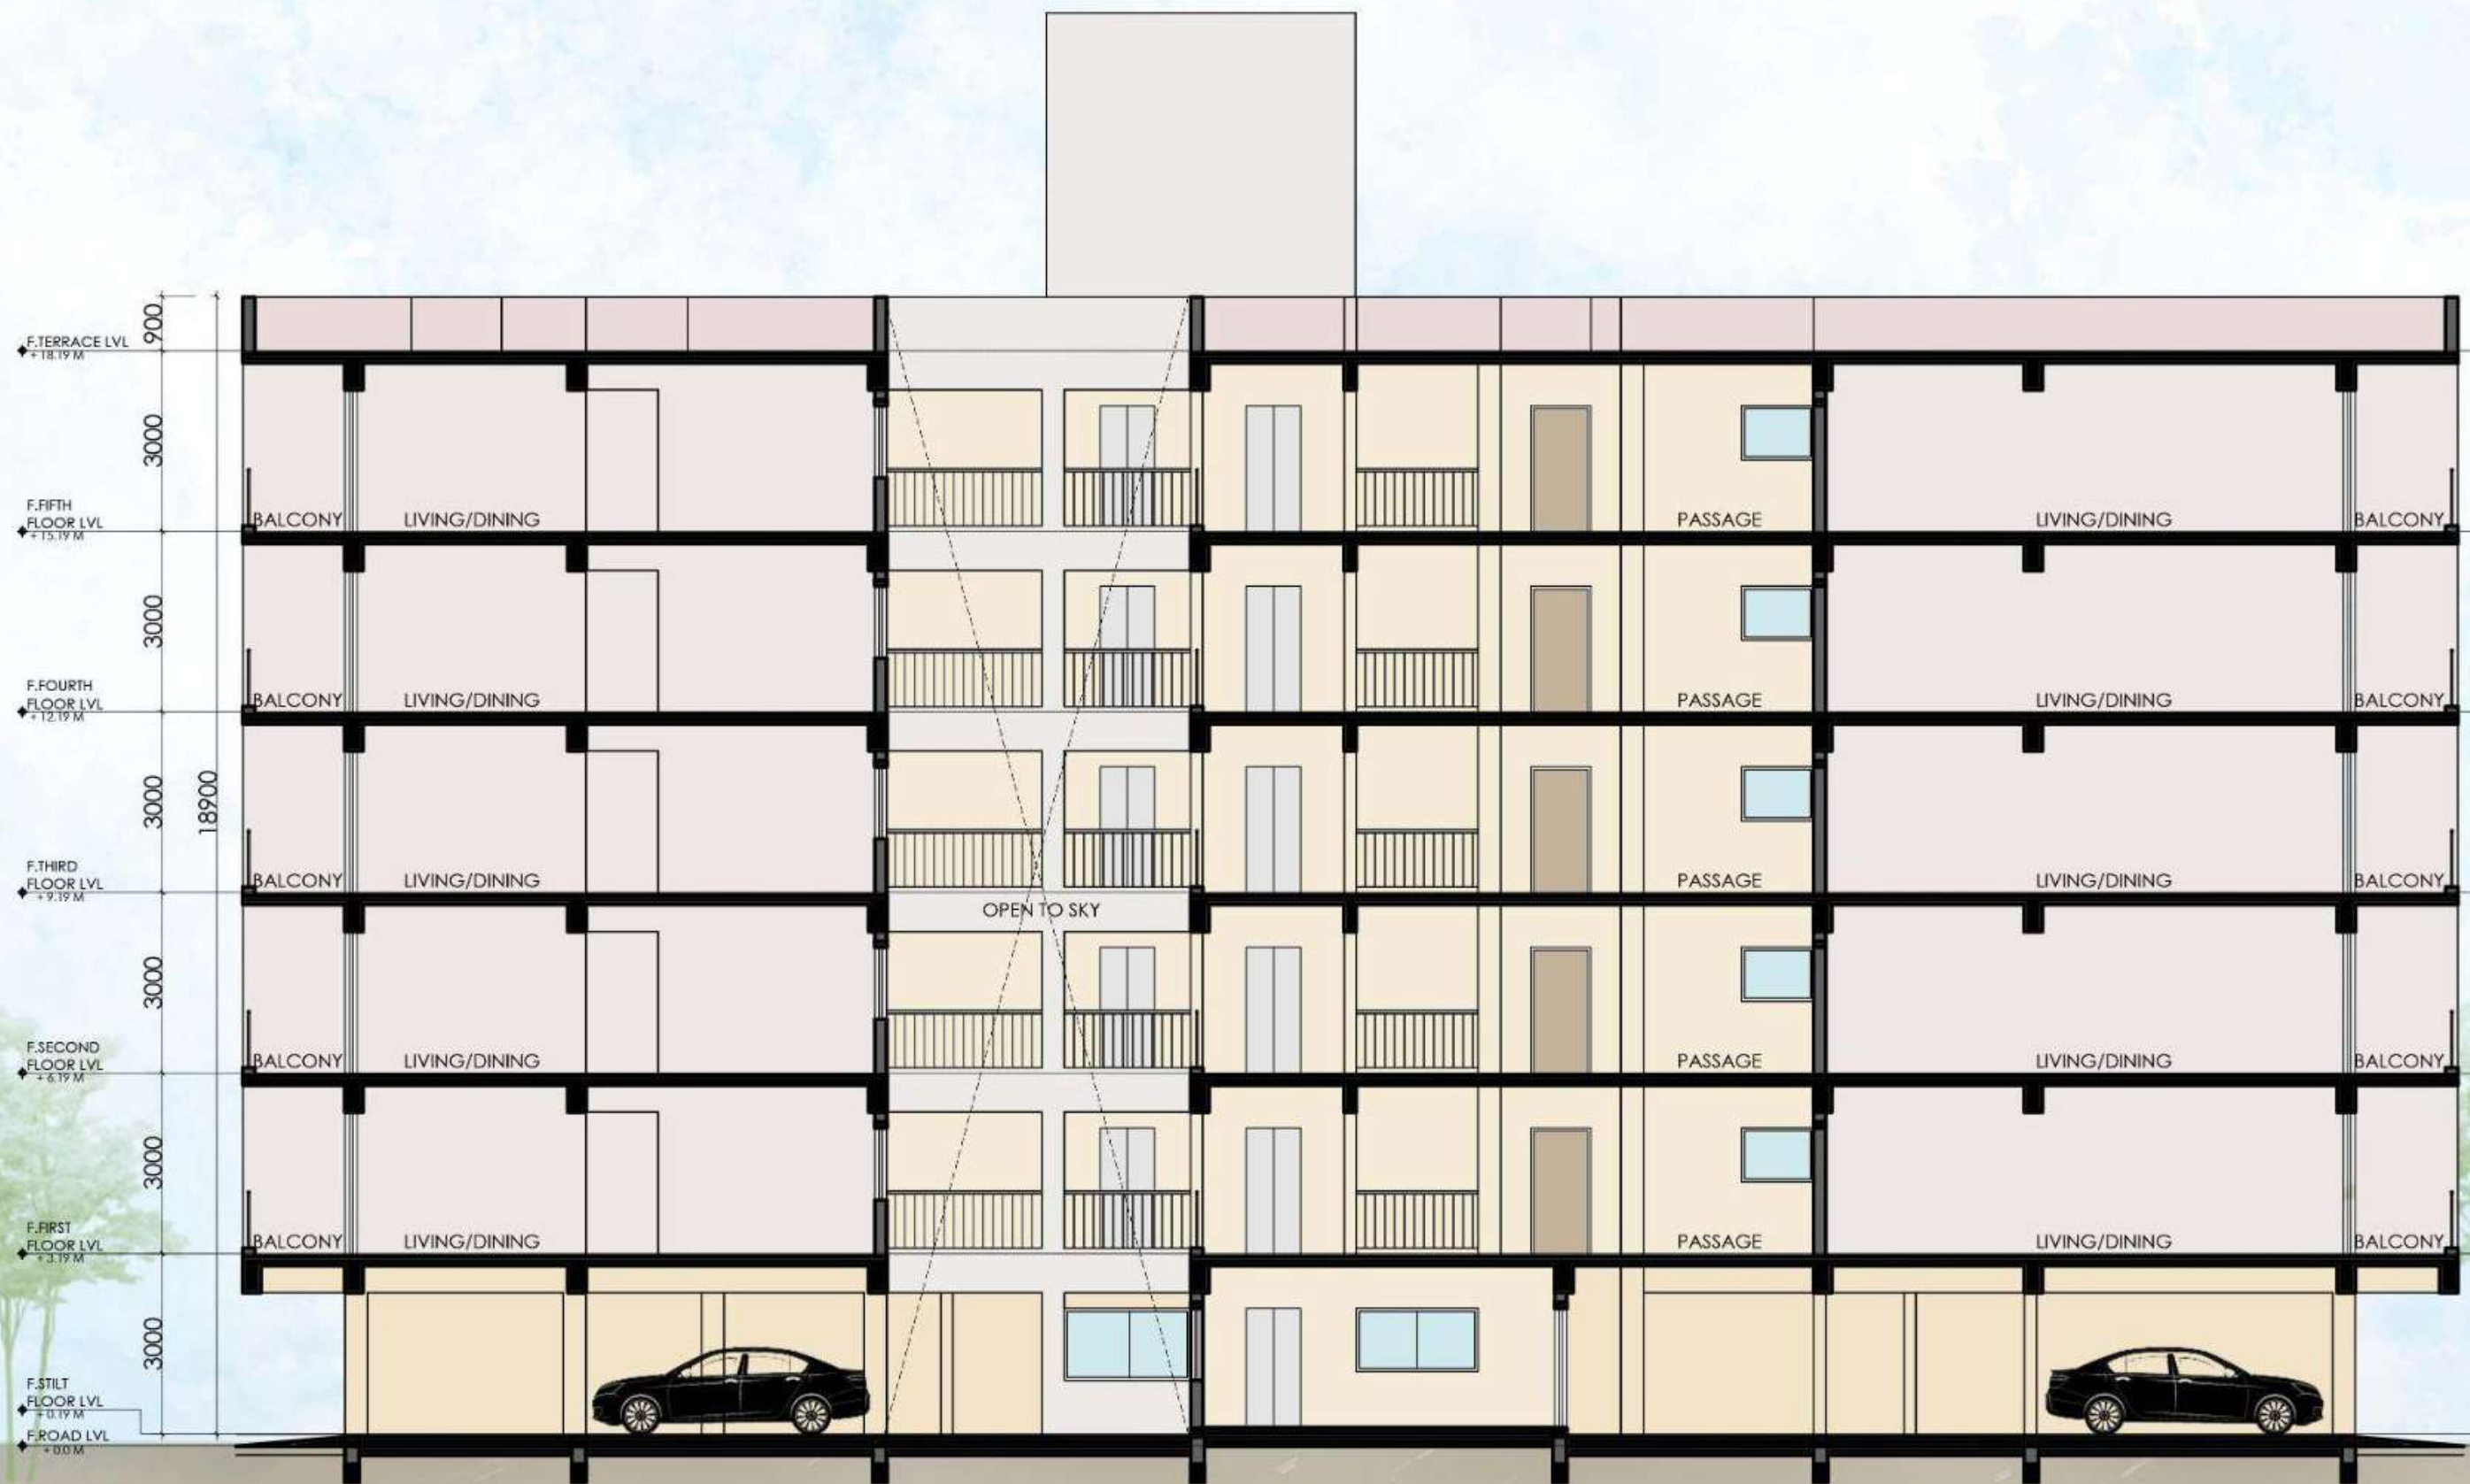


SECTION AA

PROPOSED STAFF QUARTERS - INDIAN BANK, MYLAPORE, CHENNAI

THE WATCHING DECK

THIS DECK IS SITUATED NEXT TO THE MEDITATION BLOCK AND IT DIRECTLY CONNECTS THE PEOPLE TO THE SEA. IT PROJECTS A LITTLE INTO THE SEA, PROVIDING A VIEWPOINT AS WELL AS AN OPEN MEDITATION SPACE.

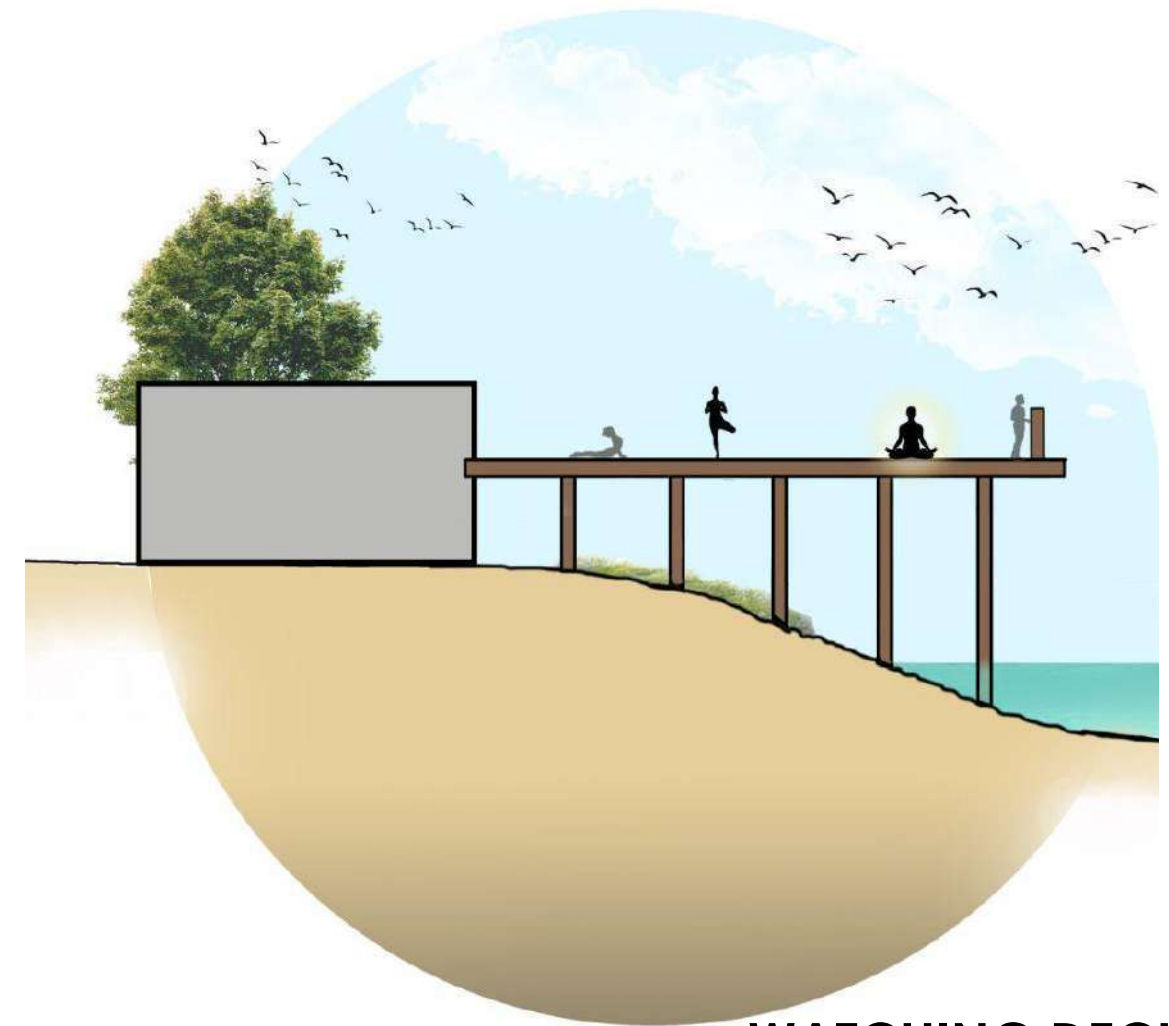

WATCHING DECK

THE ACTIVITY PASSAGE

THIS PASSAGE IS DIVIDED INTO THREE ZONES-


- CYCLE PASSAGE
- WALKING PATHWAY
- SKATING ARENA



ACTIVITY PASSAGE

SITE SECTIONS
WATCHING DECK & ACTIVITY PASSAGE

PROPOSED SPIRITUAL & CULTURAL ECO PARK, ECR, CHENNAI

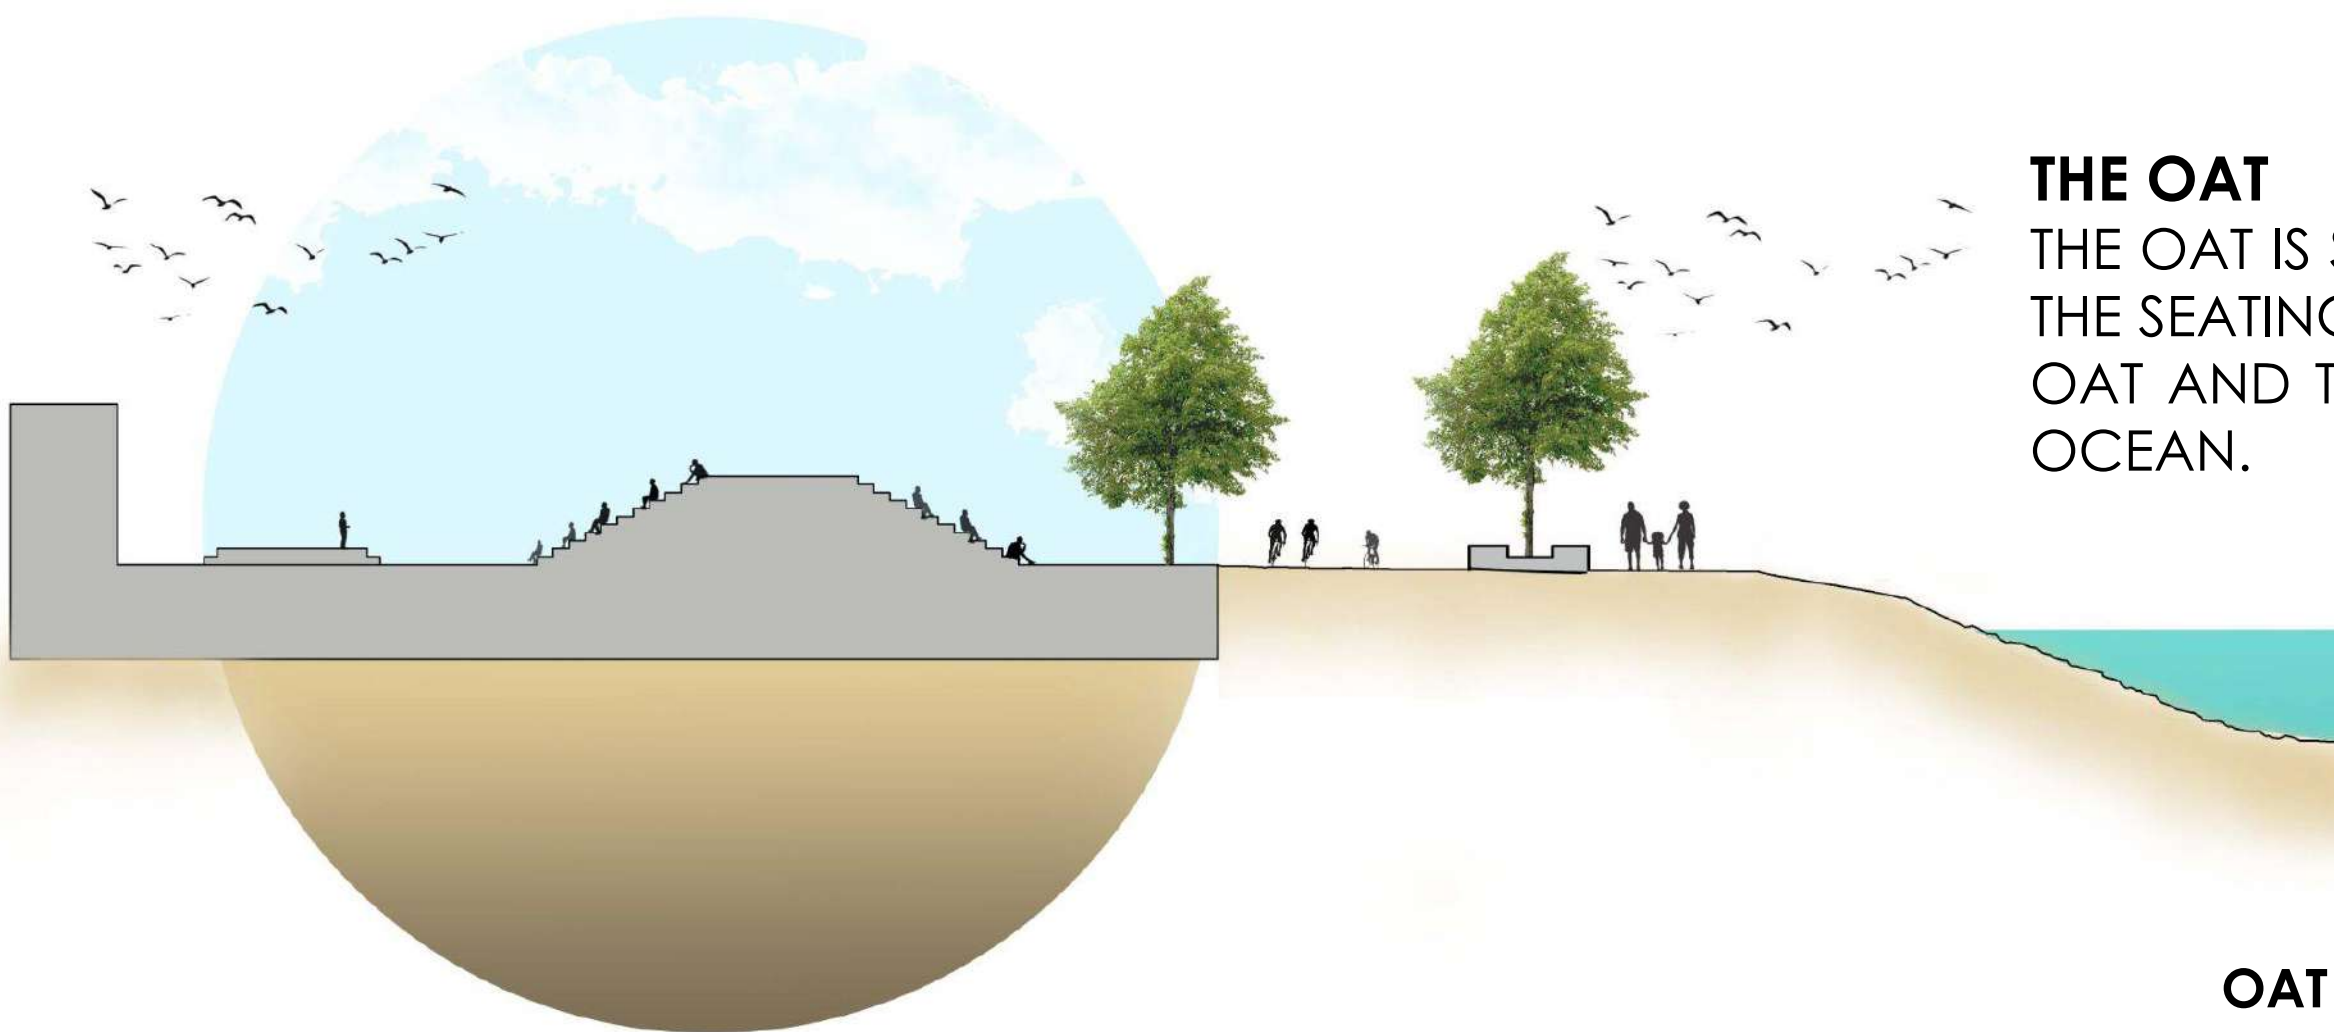

THE OAT

THE OAT IS SITUATED CLOSE TO THE SEA. THE SEATING HAS ONE SIDE FACING THE OAT AND THE OTHER SIDE FACING THE OCEAN.

THERE IS ALSO A SPACE FOR WALKING, CYCLING, JOGGING, ETC.

OAT




PARKING

SITE SECTIONS
OAT & PARKING


THE SPORTS ACTIVITY ZONE

THE SPORTS ACTIVITY ZONE IS A COMBINATION OF A PLAYGROUND, CYCLING PATHWAY, SKATING PATHWAY AND WALKING-JOGGING PATHWAY.

THIS PROVIDES A GREAT SPACE FOR PEOPLE OF ALL AGE GROUPS TO MINGLE.

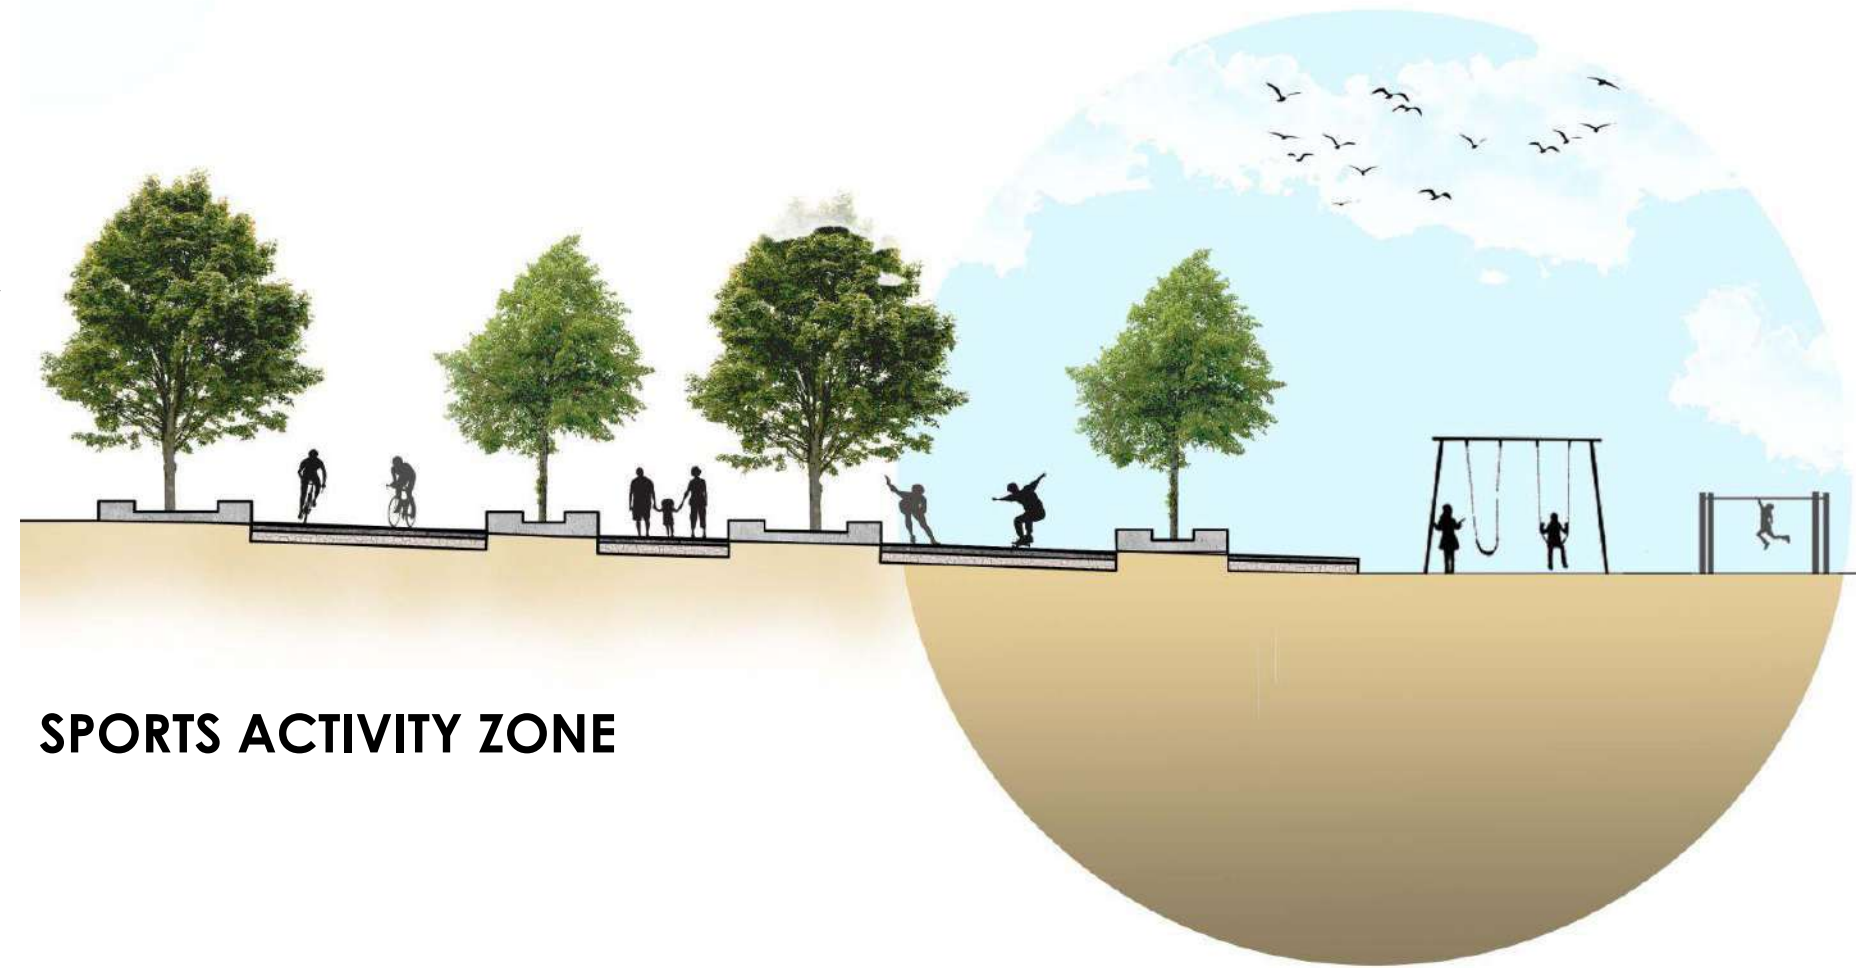

SPORTS ACTIVITY ZONE

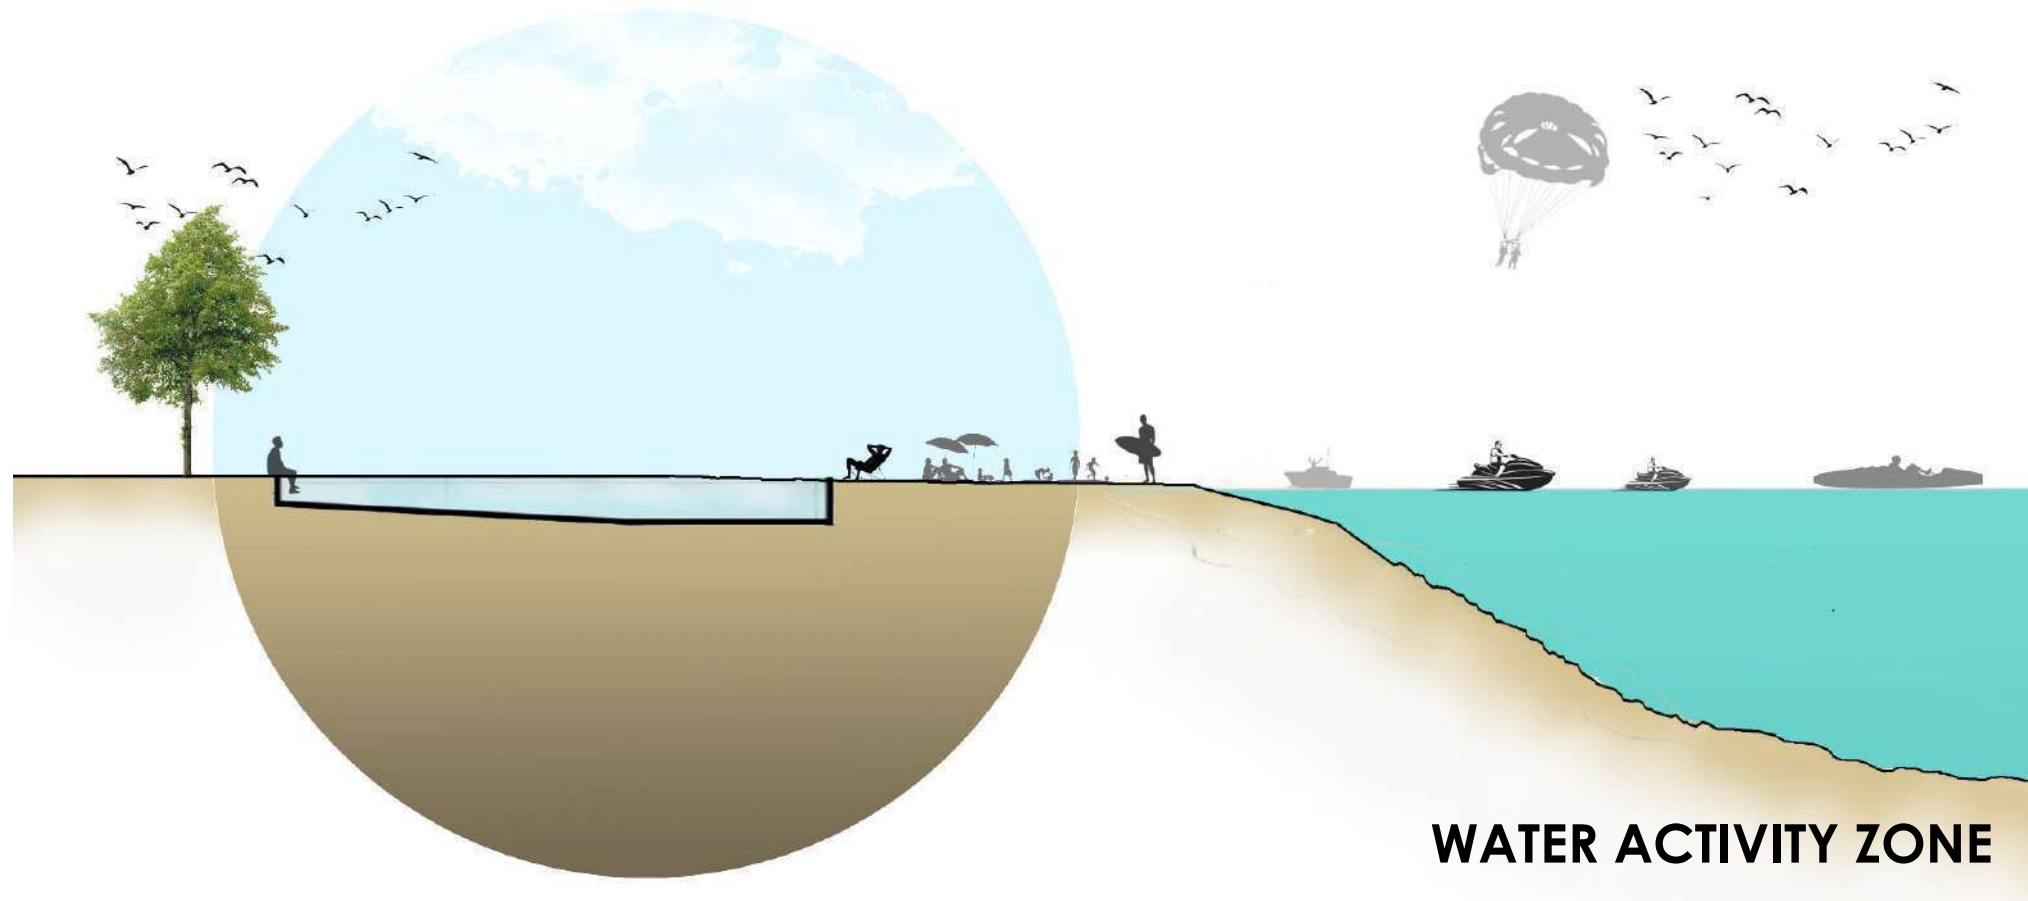

WATER ACTIVITY ZONE

THE WATER ACTIVITY ZONE

THIS ZONE CONTAINS THE DIFFERENT FUN WATER ACTIVITIES SUCH AS BOATING, PARASAILING, JET SKIING, SURFING, ETC. IT CONTAINS A SHALLOW WATER POOL AND SPACE FOR PEOPLE TO PLAY BY THE SHORE.



CHEYYAR SEZ DEVELOPERS - BARGUR

MAR GREGORIOUS COLLEGE-MOGAPPAIR

SITE VISIT



During this course of 5 months, Pithavadian and Partners has given me a good exposure to various aspects of architecture & office, and a good experience in some areas.

I experienced and understood the office environment, by which I am able to deliver the work practices, respecting and working with colleagues in the office. Interaction with the architects and senior architects have been extremely helpful to acquire as much information as possible during the internship.

In all the assignments given, I tried to get good amount of input about the project and the design, before starting my work and also during the work. This helped me execute the work with better knowledge and speed.

During the internship, I got several opportunities to execute the drawings for the designs that were happening during this time period using AutoCAD, Photoshop and SketchUp. I was also able to go for select site visits. The learning during the internship are- detail drawings for staircase, ramp, toilet and joinery, drafting of plan, section and elevation of factories and institutional projects, rendering and presentation, how to present the project for competitions and understanding of the construction practically during site visits.